DRAWING NUMBER 001203 PLAN HOLD CORPORATION . IRVINE, CALIFORNIA RECROER BY NUMBER 075AR

DRAWING NUMBER 001203 PLAN HOLD CORPORATION + IRVINE, CALIFORNIA


REORDER BY NUMBER 075AR

DRAWING NUMBER 001203 PLAN HOLD CORPORATION . IRVINE, CALIFORNIA

PEURDER BY NUMBER 075AP

DRAWING NUMBER 001203 PLAN HOLD CORPORATION . IRVINE, CALIFORNIA

RECIPOER BY NUMBER 175AF

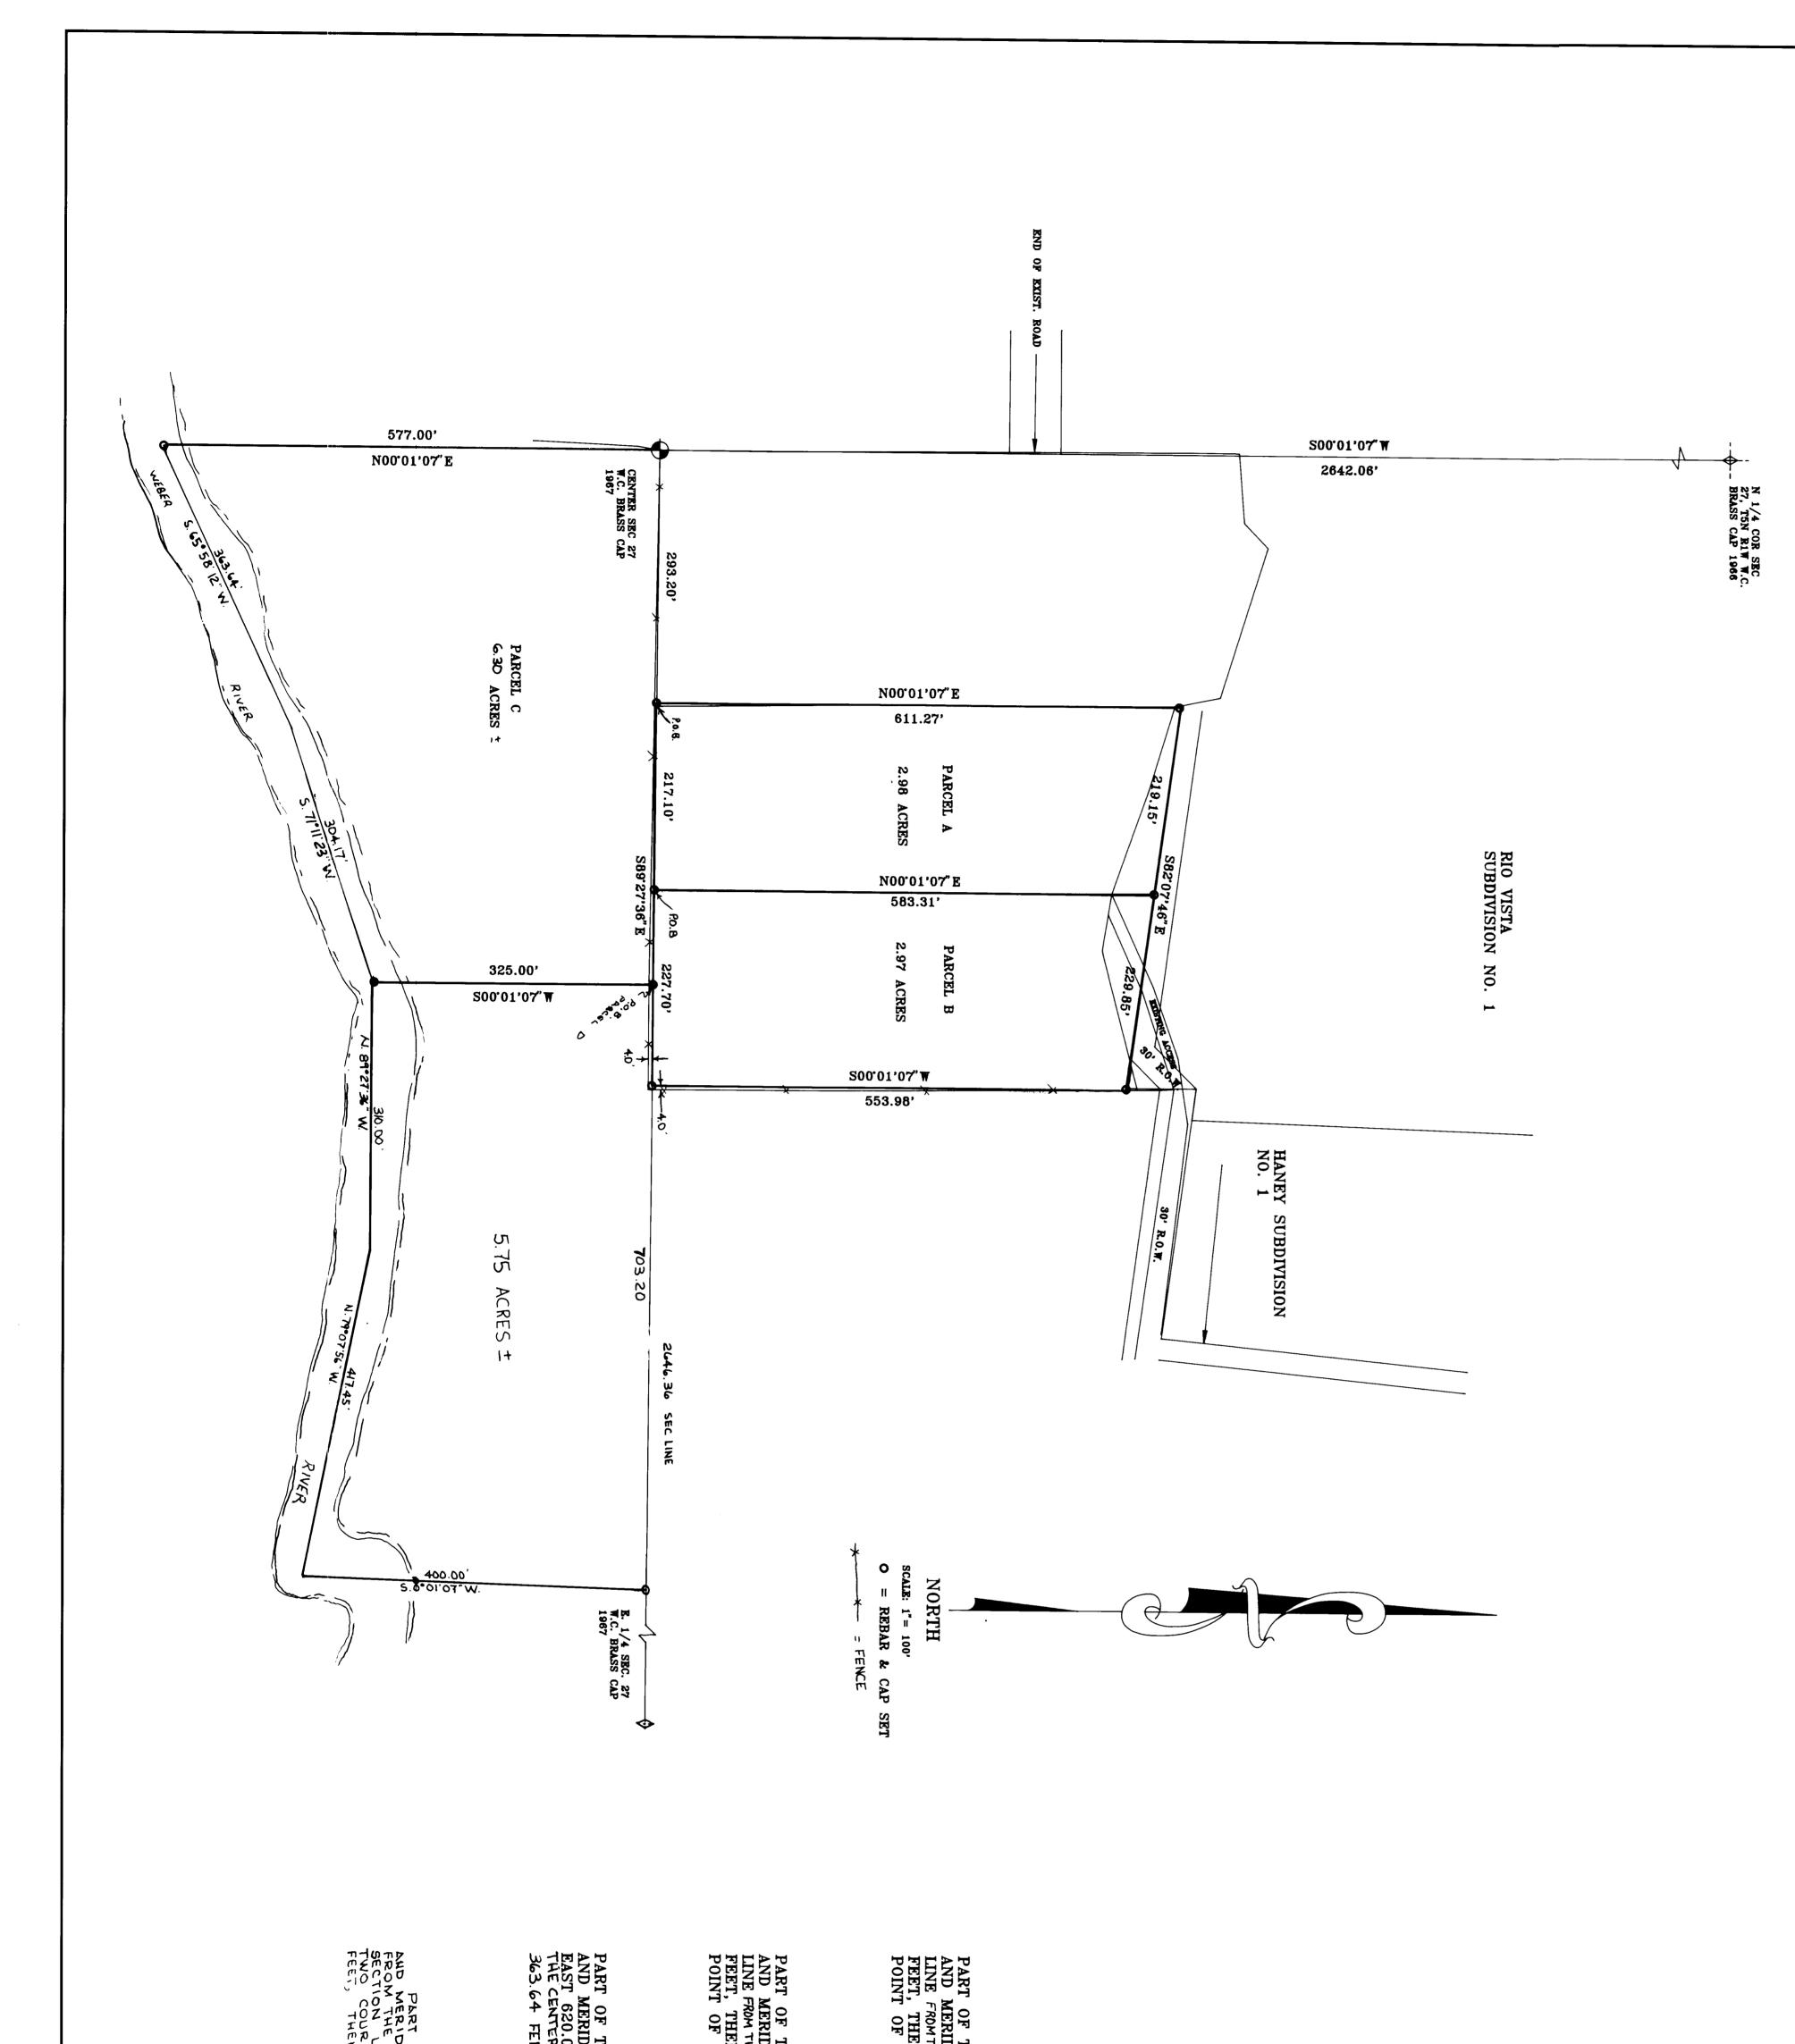

I, DALLAS K. BUTTARS, A REGISTERED LAND SURVEYOR AS PRESCRIBED BY THE LAWS OF THE STATE OF UTAH AND HOLDING LICENSE NUMBER 167594 DO HEREBY CERTIFY THAT I MADE A SURVEY OF THE BELOW DESCRIBED PROPERTY AND THE PLAT HEREON IS A TRUE AND CORRECT REPRESENTATION OF SAID SURVEY.

DATE: Mak 1, 1995 SIGNED WAS K SURVEYOR AS SIGNED.

PART OF THE NORTHEAST QUARTER OF SECTION 27, TOWNSHIP 5 NORTH, RANGE 1 WEST, SALT LAKE BASE AND MERIDIAN: BEGINNING AT A POINT SOUTH 89'27'36" EAST 293.20 FEET ALONG THE QUARTER SECTION LINE FROM THE CENTER OF SAID SECTION 21, AND RUNNING THENCE WATH 0°01'07" EAST 611.27 FEET, THENCE SOUTH 82'07'46" EAST 219.15 FEET, THENCE SOUTH 0'01'07" WEST 583.31 FEET, THENCE NORTH 89'27'36" WEST 217.10 FEET, TO THE POINT OF BEGINNING. CONTAINS 2.98 ACRES

## PARCEL B BOUNDARY DESCRIPTION

PART OF THE NORTHEAST QUARTER OF SECTION 27, TOWNSHIP 5 NORTH, RANGE 1 WEST, SALT LAKE BASE AND MERIDIAN: BEGINNING AT A POINT SOUTH 89'27'36" EAST 510.30 FEET ALONG THE QUARTER SECTION LINE FROM THE CENTER OF SAID SECTION 27, AND RUNNING THENCE NORTH 0'01'07' EAST 529.85
FEET, THENCE SOUTH 0'01'07" WEST 553.98 FEET, THENCE NORTH 89'27'36" WEST 227.70 FEET, TO THE POINT OF BEGINNING. CONTAINS 2.97 ACRES PARCEL C
BOUNDARY DESCRIPTION

PART OF THE NORTHEAST QUARTER OF SECTION 27, TOWN SHIP 5 NORTH, RANGE I WEST, SALT LAKE BASE AND MERIDIAN: BEGINNING AT A POINT 5.89°27'36" EAST G20.00 FT, DLONG THE QUARTER SECTION LINE FROM THE CENTER OF SAID SECTION 27, DAND RUNNING THENCE SOUTH 89°27'36" EAST DLONG SAID QUARTER SECTION LINE 703.20 FEET, THENCE SOUTH 0°01'07" WEST TO THE CENTER OF WEBER RIVER, THENCE TWO COURSES ALONG THE CENTER OF RIVER N. 79°07'56" W. 417.45 FEET DAND N. 89°27'36"W. 310.00 FEET TO THE POINT OF BEGINNING. PART OF THE NORTHEAST QUARTER OF SECTION 27, TOWNSHIP 5 NORTH, RANGE 1 WEST, SALT LAKE BASE AND MERIDIAN: BEGINNING AT THE CENTER OF SECTION 27, AND RUNNING THENCE SOUTH 89'27'36"

EAST 620.00 FEET, THENCE SOUTH 0'01'07" WEST 325.00 FEET TO THE CENTER OF RIVER, THENCE ALONG THE CENTER OF RIVER THE FOLLOWING 2 COURSES: SOUTH 71°11'23" WEST 304.17 FEET, SOUTH 65'58'12" WEST 363.64 FEET, THENCE NORTH 0'01'07" EAST 577.0 FEET TO THE POINT OF BEGINNING. CONTAINS 6.30 ACRES PARCEL D
BOUNDARY DESCRIPTION

PARCEL A
BOUNDARY DESCRIPTION