


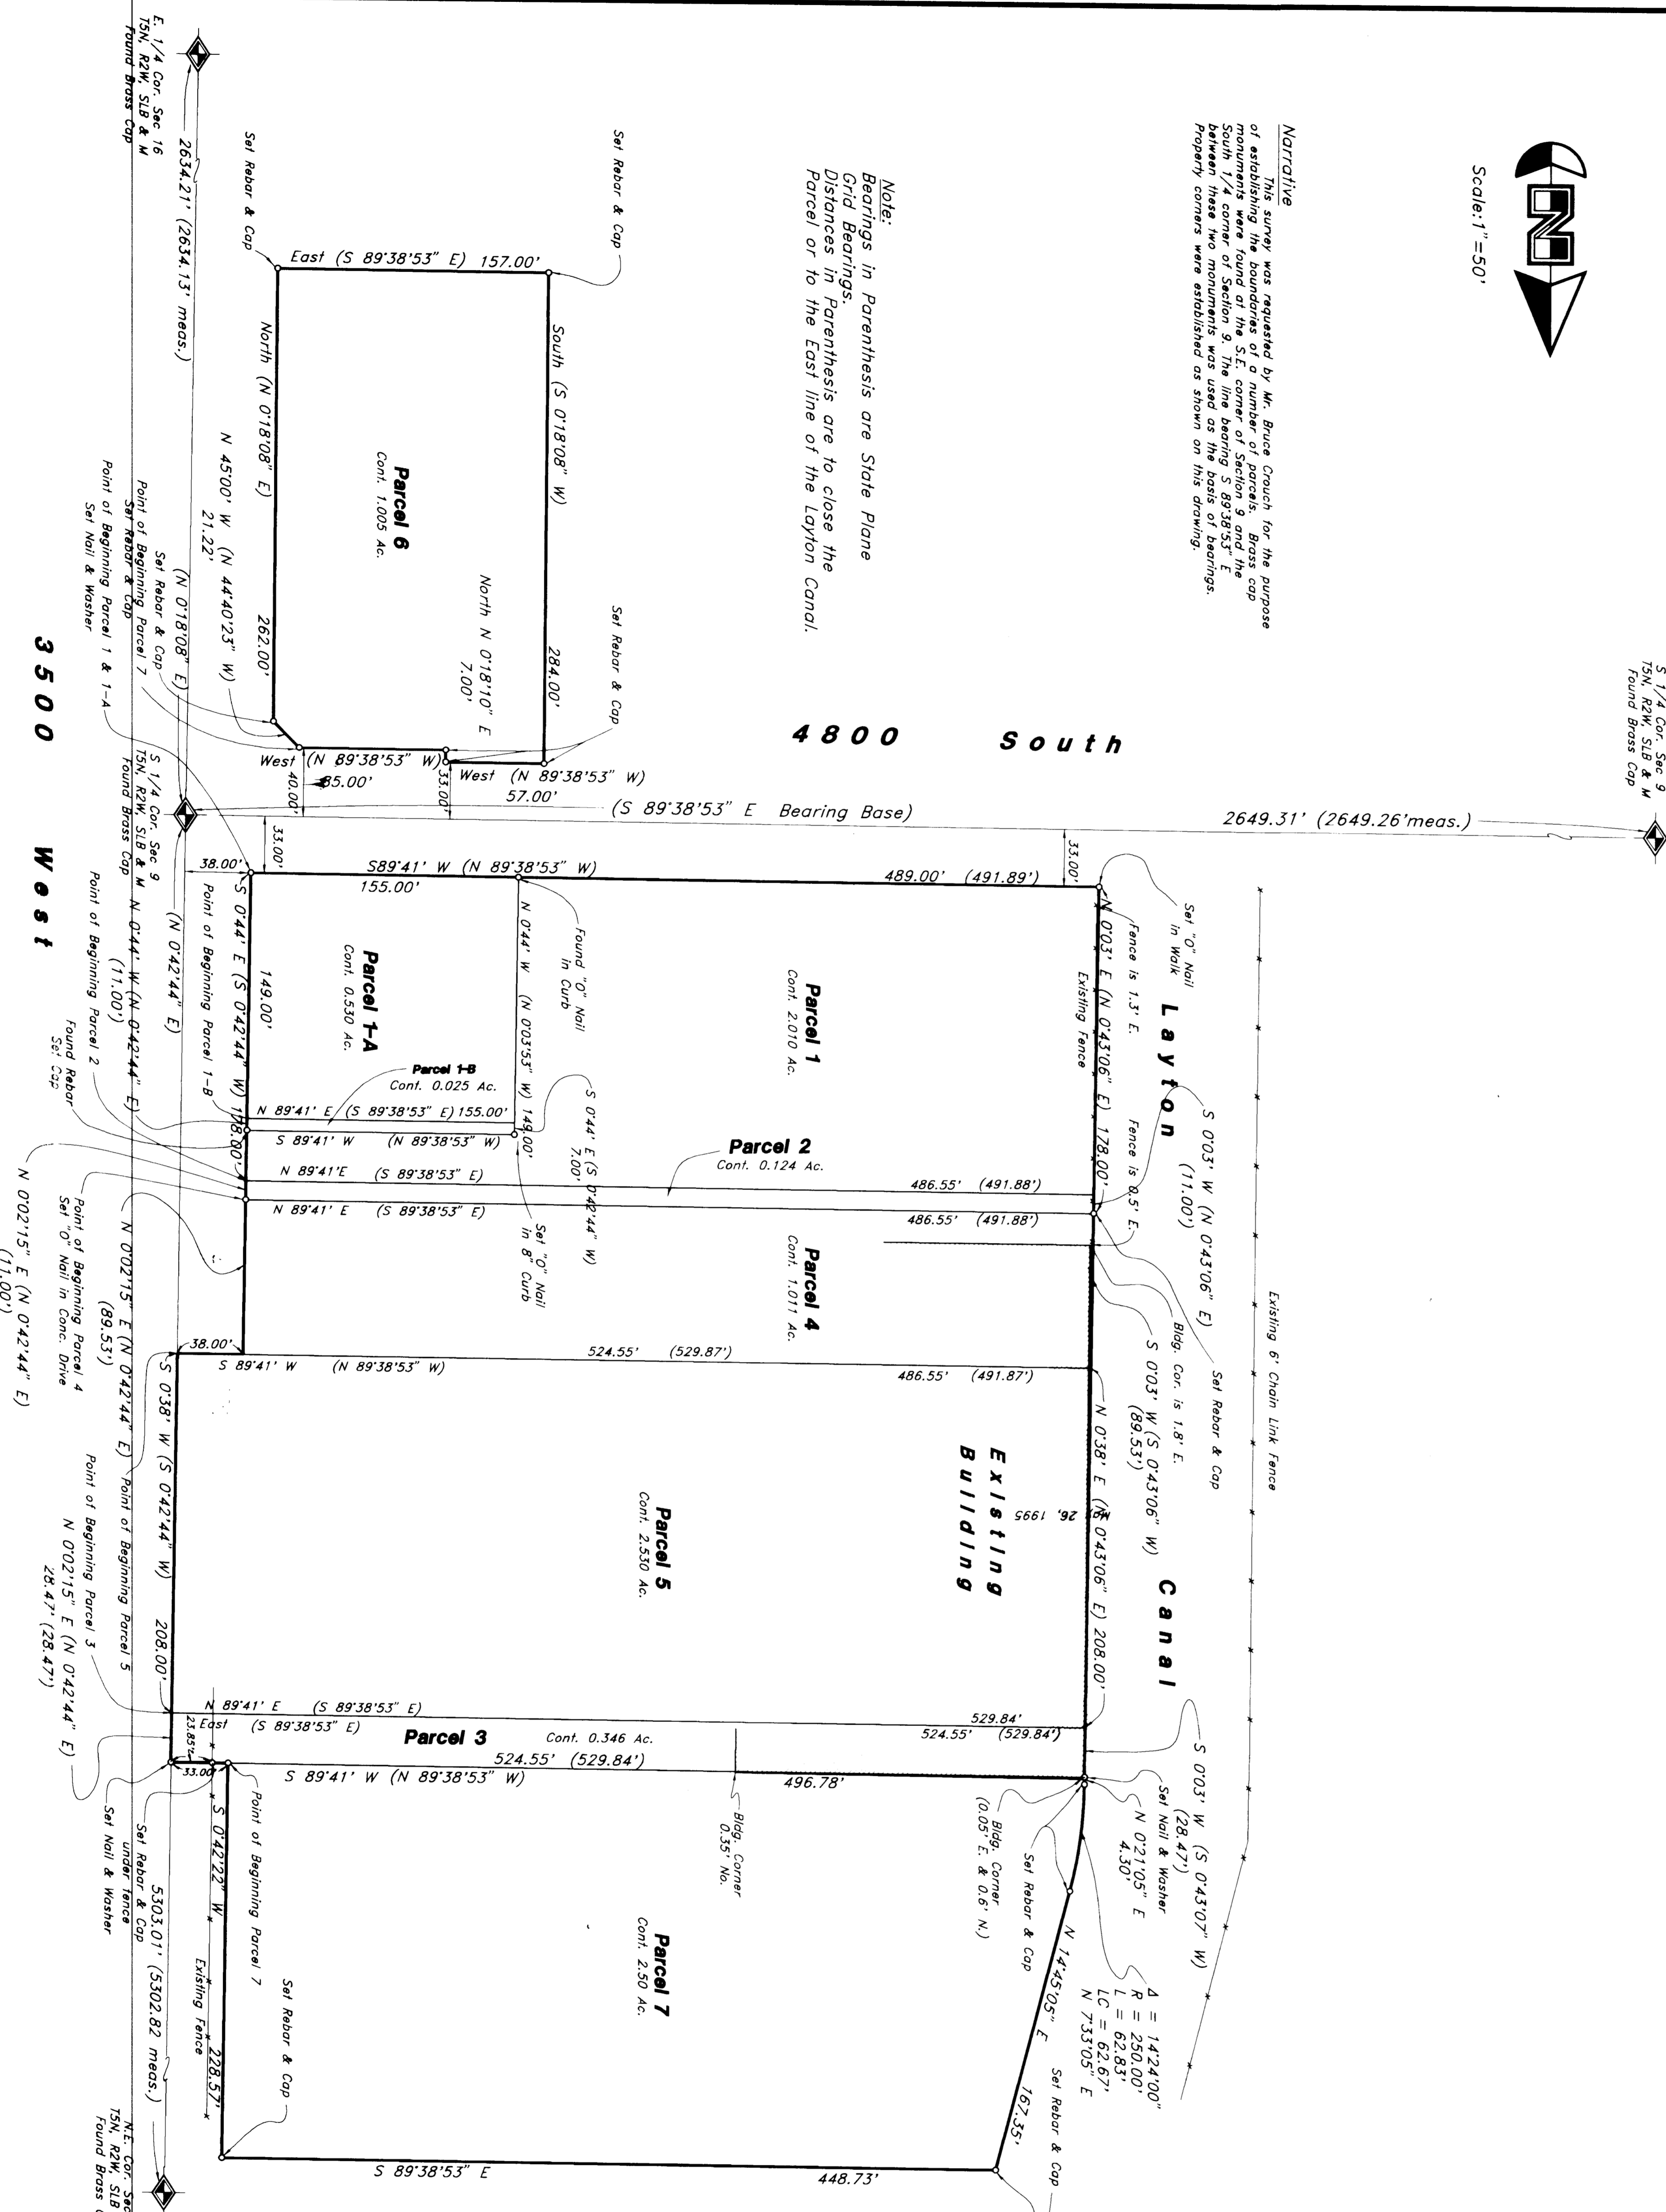

Scale: 1"=50'

**NARRATIVE**  


**Note:**  



S 1/4 Cor. Sec. 9  
15N, 42W, S1B & M  
Found Brass Cap

2649.31' (2649.26' meas.)

4800 South

(S 89°38'53" E Bearing Base)

3500 West

(N 0°02'15" E (N 0°42'44" E))

(N 0°02'15" E (N 0°42'44" E))

(N 0°02'15" E (N 0°42'44" E))

**Parcel 1**  


















**Bruce Couch**  

DATE: 1-15-88  
GARY L. NEWMAN  
GARY L. NEWMAN

**Property Survey**  
GREAT BASIN ENGINEERING, INC.  
94-664

SCALE: 1"=50'	DATE: 14 Nov, 1994	WORK NO. PS-94-66
DRAWN: DGA	REVISIONS: 31 Nov, 1995	
	14 Jan, 1995	