



S 88°49'58" E (Ranging Bars)

2735.177


DESCRIPTION FOR RECORD


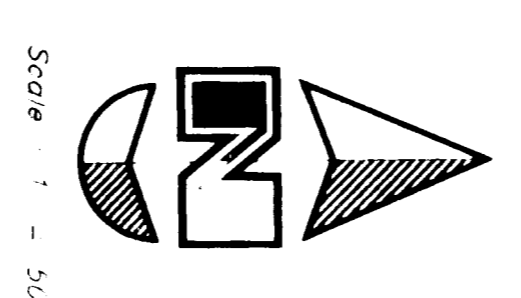

REMARKS:
 This survey was requested by Mr. John Daniels for the purpose of describing & determining acreage within a parcel he planned to sell. The survey was conducted on August 4, 1995. The bearings & distances were measured with a total station. The corners were marked with iron nails. The corners were set.

BOUNDARY DESCRIPTION



CERTIFICATION
 I, John S. Daniels, Registered Land Surveyor, do hereby certify that I am a Registered Land Surveyor, and that I had certified no. 4778 as prescribed by the laws of the State of Utah, and have made a survey of the above described property, I further certify that the above set correctly shows the true dimensions of the property surveyed.

Date: 8-8-95

John S. Daniels
 Registered Land Surveyor
 State of Utah

Property Survey

GREAT BASIN ENGINEERING, INC.
 CONSULTING ENGINEERS AND SURVEYORS
 2100 S. 1000 E., SUITE 200, OGDEN, UTAH 84401

SCALE: 1" = 50'
 DRAWN: A.H.
 DATE: 4 Aug. 1995
 SHEET NO.: 82-104

John Daniels
 Registered Land Surveyor
 State of Utah

82-104