



08/29/1995 F:\PROJ\2437\CAD\RECSURV1

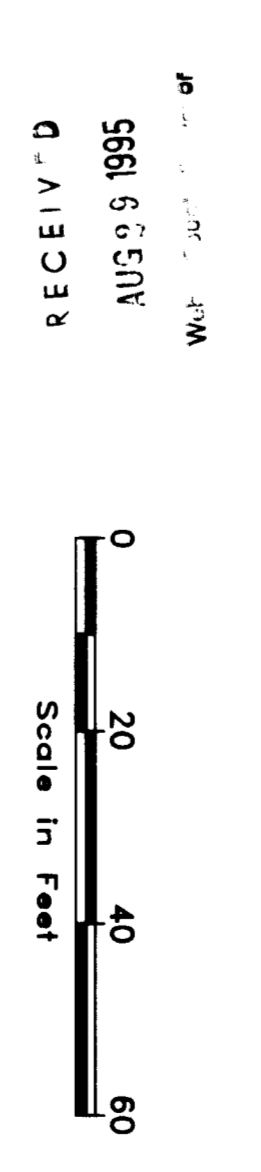

**SURVEYOR'S CERTIFICATE**

 Date: August 29, 1995  
 James D. Pihkin, RLS  
 License No. 171546

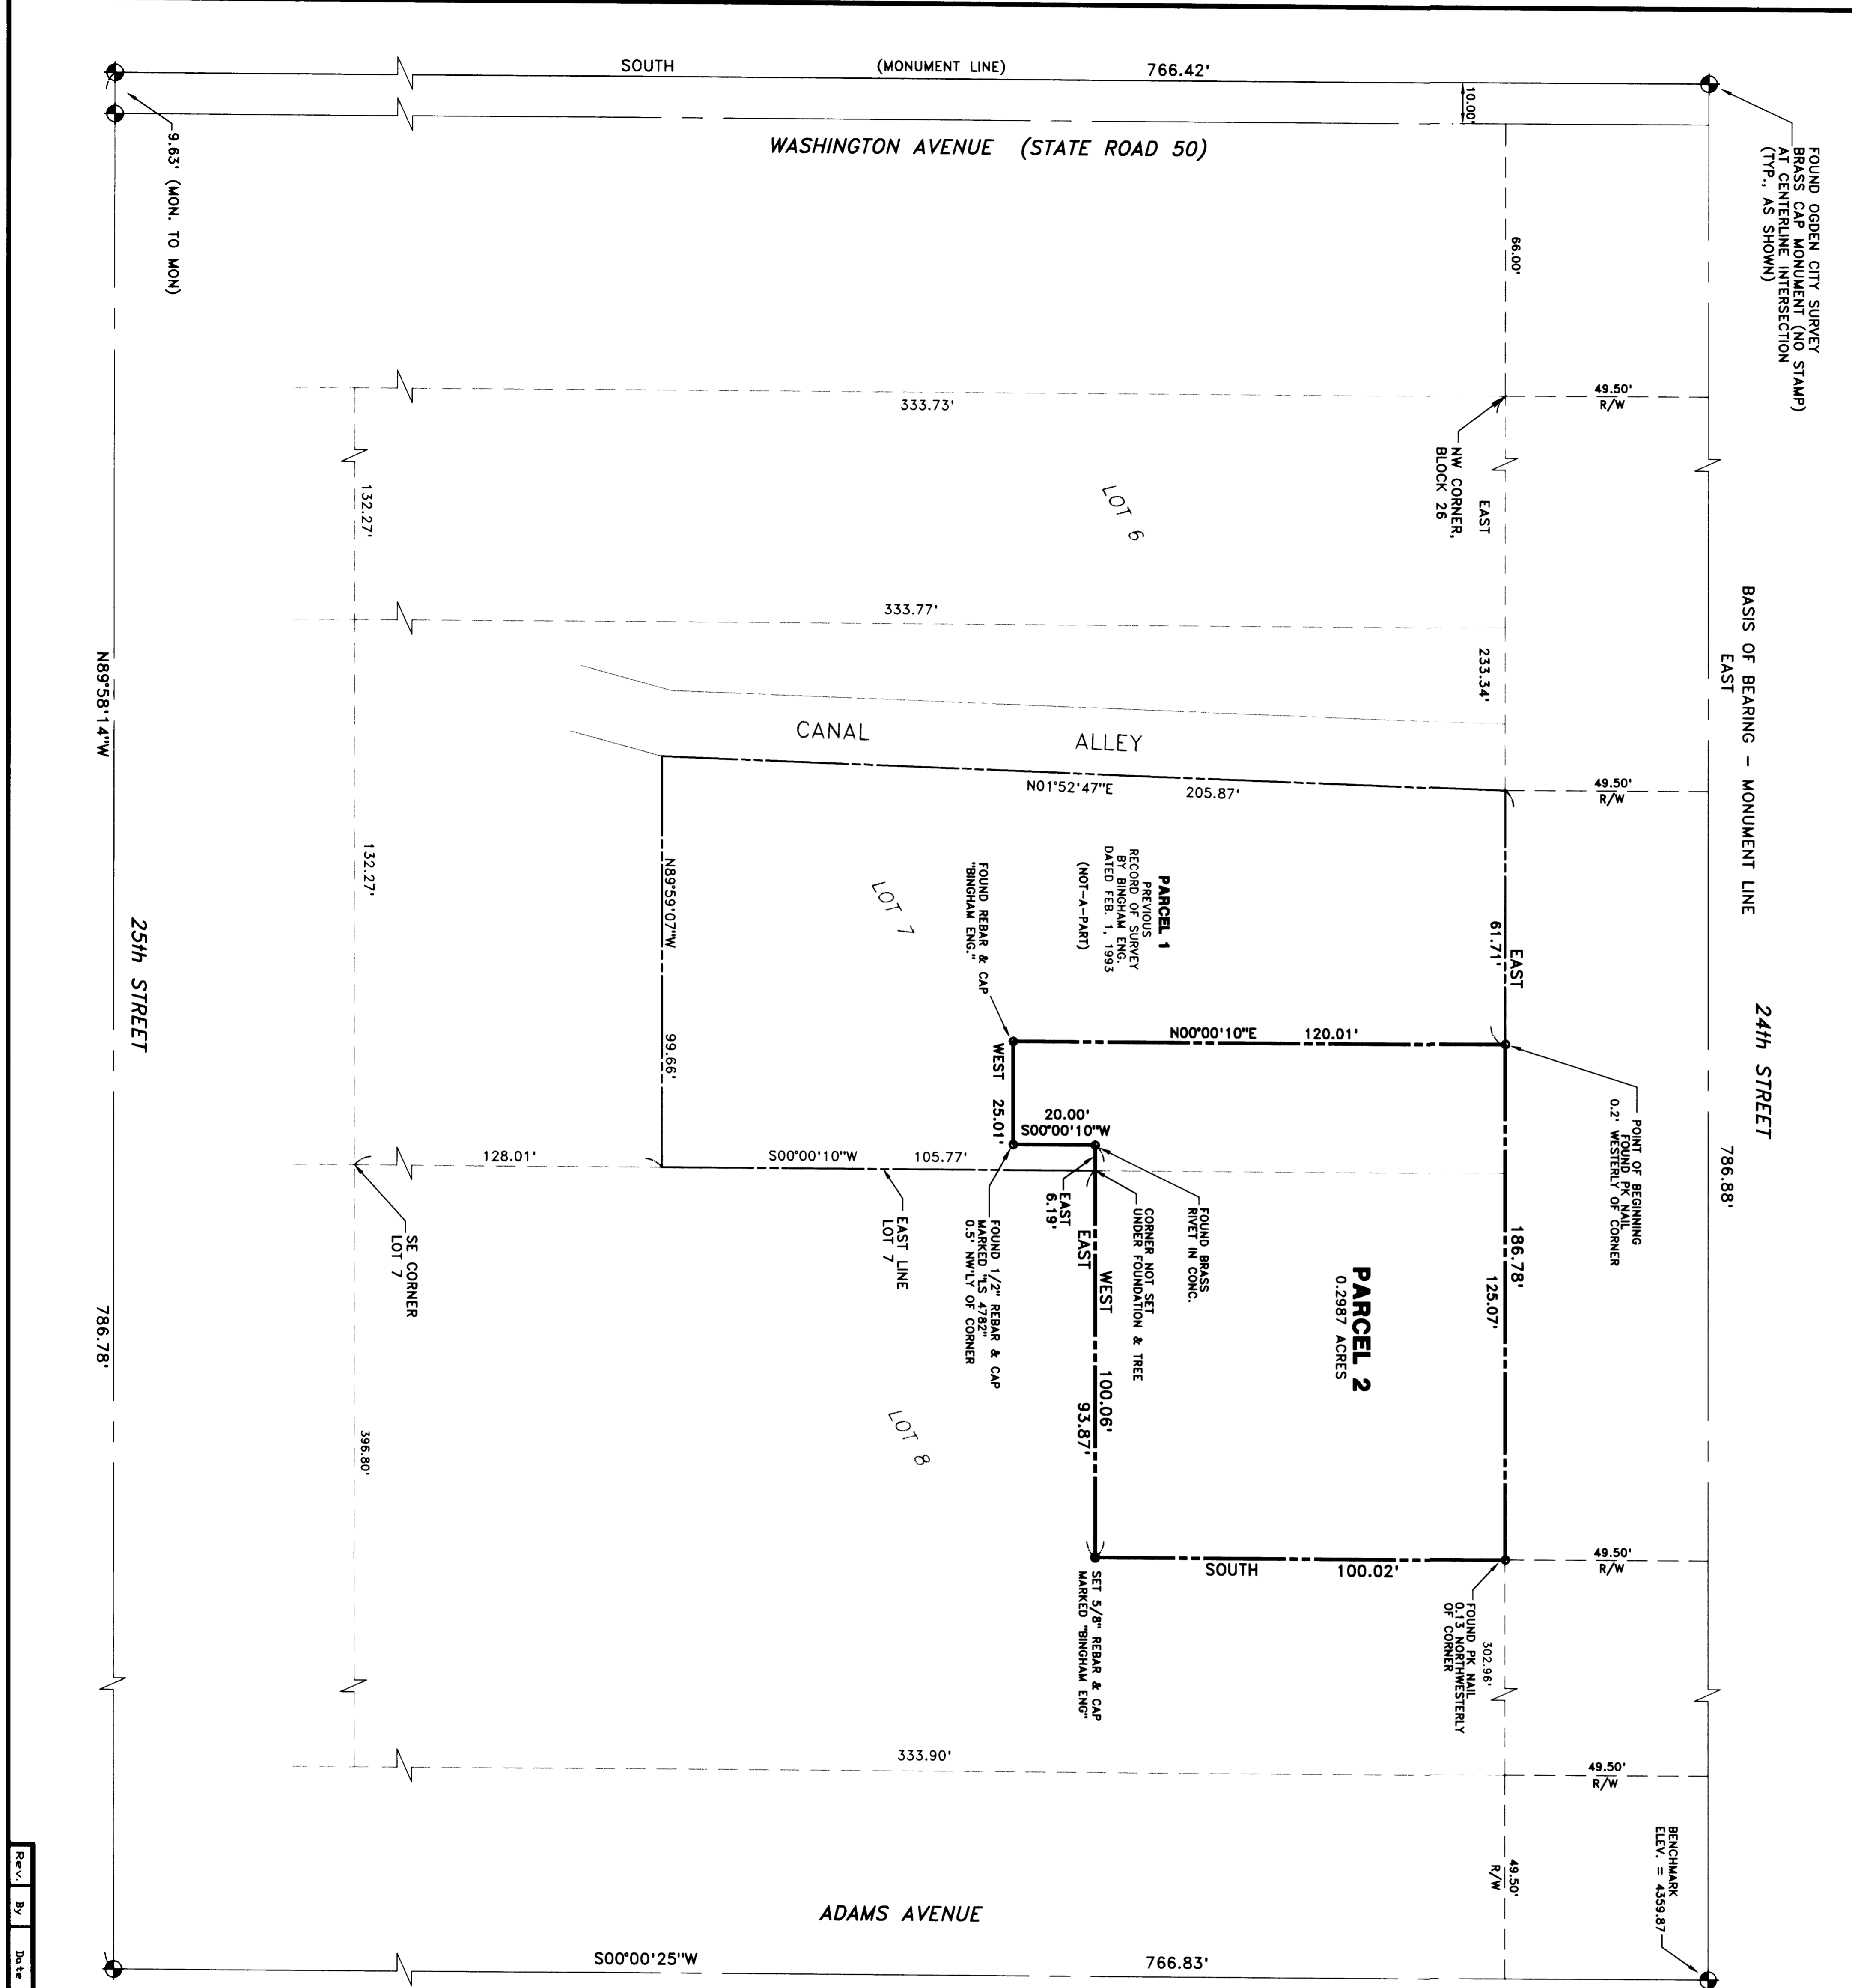

**PARCEL 1**  
RECORD DESCRIPTION (Not a part)

A part of lots 4 and 7, Block 26, Plat "A", Ogdan City Survey:  
 BEGINNING at a point on the South line of 24th Street 233.2 feet East of the Northwest corner of said Block 26, and running thence South 120 feet; thence East 23 feet; thence North 20 feet; thence East to the East line of said Lot 7; thence South to a point 128 feet North of the Southeast North line of said Lot 7; thence East to the place of beginning.

**PARCEL 2**  
RECORD DESCRIPTION

Part of Lot 7, Block 26, Plat "A", Ogdan City Survey, more particularly described as follows:  
 BEGINNING at a point on the South line of 24th Street which is 233.34 feet East of the Northwest corner of said Block 26, and running thence East 20.00 feet; thence East 6.19 feet to the East line of said Lot 7; 

**PARCEL 1**  
RECORD DESCRIPTION  
 Part of Lots 7 and 8, Block 26, Plat "A", Ogdan City Survey, more particularly described as follows:  
 BEGINNING at a point on the South line of 24th Street which is 233.34 feet East of the Northwest corner of said Block 26, and running thence East 120.01 feet; thence East 6.19 feet to the East line of said Lot 7; thence South 100 feet; thence West 100 feet; thence South 20 feet; thence West 25 feet; thence North 120 feet to the place of beginning.

**NARRATIVE**  
The record plat was prepared by Vincent Design Group and the record plat was filed for recording on August 9, 1995.

**SURVEYORS NOTES**  
 1) All bearings & distances shown indicate measured values. Any discrepancies with record bearings and distances are due to excess and deficiencies in the existing monuments found and delineating locations for Block 26, Plat "A".

**REFERENCES**  
 Water County Deeds of Record (Book/Page): 1586/1453, 1586/2448.  
 Ogdan City Survey Plat (Sheet 22) of Block 26, Plat "A".  
 Ownership Plat of Block 26, Plat "A".  
 Plat of Ogdan City Center prepared by Bush & Gudgeon, Inc.  
 Boundary Survey prepared by Bingham Engineering, Proj. No. 1790-001, Dated Feb. 1, 1993.

|   |                  |                     |                   |
|---|------------------|---------------------|-------------------|
| RECEIVED  | DESIGN           | DATE                | BY                |
| AUG 29 1995                                     | JAV              |                     |                   |
| <b>BINGHAM ENGINEERING</b>                      |                  |                     |                   |
| <b>VINCENT DESIGN GROUP</b>                     |                  |                     |                   |
| <b>PART OF LOTS 7 &amp; 8, BLOCK 26, PLAT A</b> |                  |                     |                   |
| <b>OGDEN CITY SURVEY</b>                        |                  |                     |                   |
| <b>FIRST SECURITY BANK</b>                      |                  |                     |                   |
| <b>RECORD OF SURVEY</b>                         |                  |                     |                   |
| DATE  | PROJECT          | SHEET               | TOTAL SHEETS      |
| AUGUST 1995                                     | 2437-001         | 1                   | 1                 |