

NARRATIVE


THE PURPOSE OF THIS SURVEY IS TO ESTABLISH THE LOT CORNERS AS SHOWN ON THE SUBDIVISION PLAT FOR THE PURPOSE OF LOCATING A FENCE ALONG THE BOUNDARY LINE.

LEGAL DESCRIPTION

ALL OF LOT 274, EVERGREEN PARK NO. 1 SUBDIVISION ACCORDING TO THE OFFICIAL PLAT THERE OF ON FILE AND OF RECORD WITH THE WEBER COUNTY RECORDERS OFFICE, OGDEN, UTAH.  
SET REAR CORNERS FROM FOUND CORNERS BY INTERSECTION.

MAY 25, 1988

*F. Lyle Page*

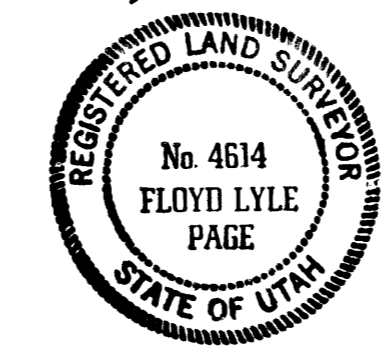

LEGEND

o PROP. CORNER (SEE MAP)  
P.U.E PUBLIC UTILITIES EASEMENT

RECEIVED

MAY 30 1988

Weber County Surveyor

SURVEY FOR		SECTION	TOWNSHIP	RANGE	DATE	SCALE
JOE B. GUSTAVESON 3105 E. 7180 SO. SALT LAKE CITY, UT. 84121		NE 1/4 30	7 N	3 E	5-25-88	1" = 60'
		S. L. B. & M.				
LOT	BLOCK	PLAT	SURVEY			
274			EVERGREEN PARK NO. 1			
		9740 SO SITZMARK DR		328-5883		SANDY, UTAH 84092

**CONTRACT SURVEYORS**  
REGISTERED LAND SURVEYORS