



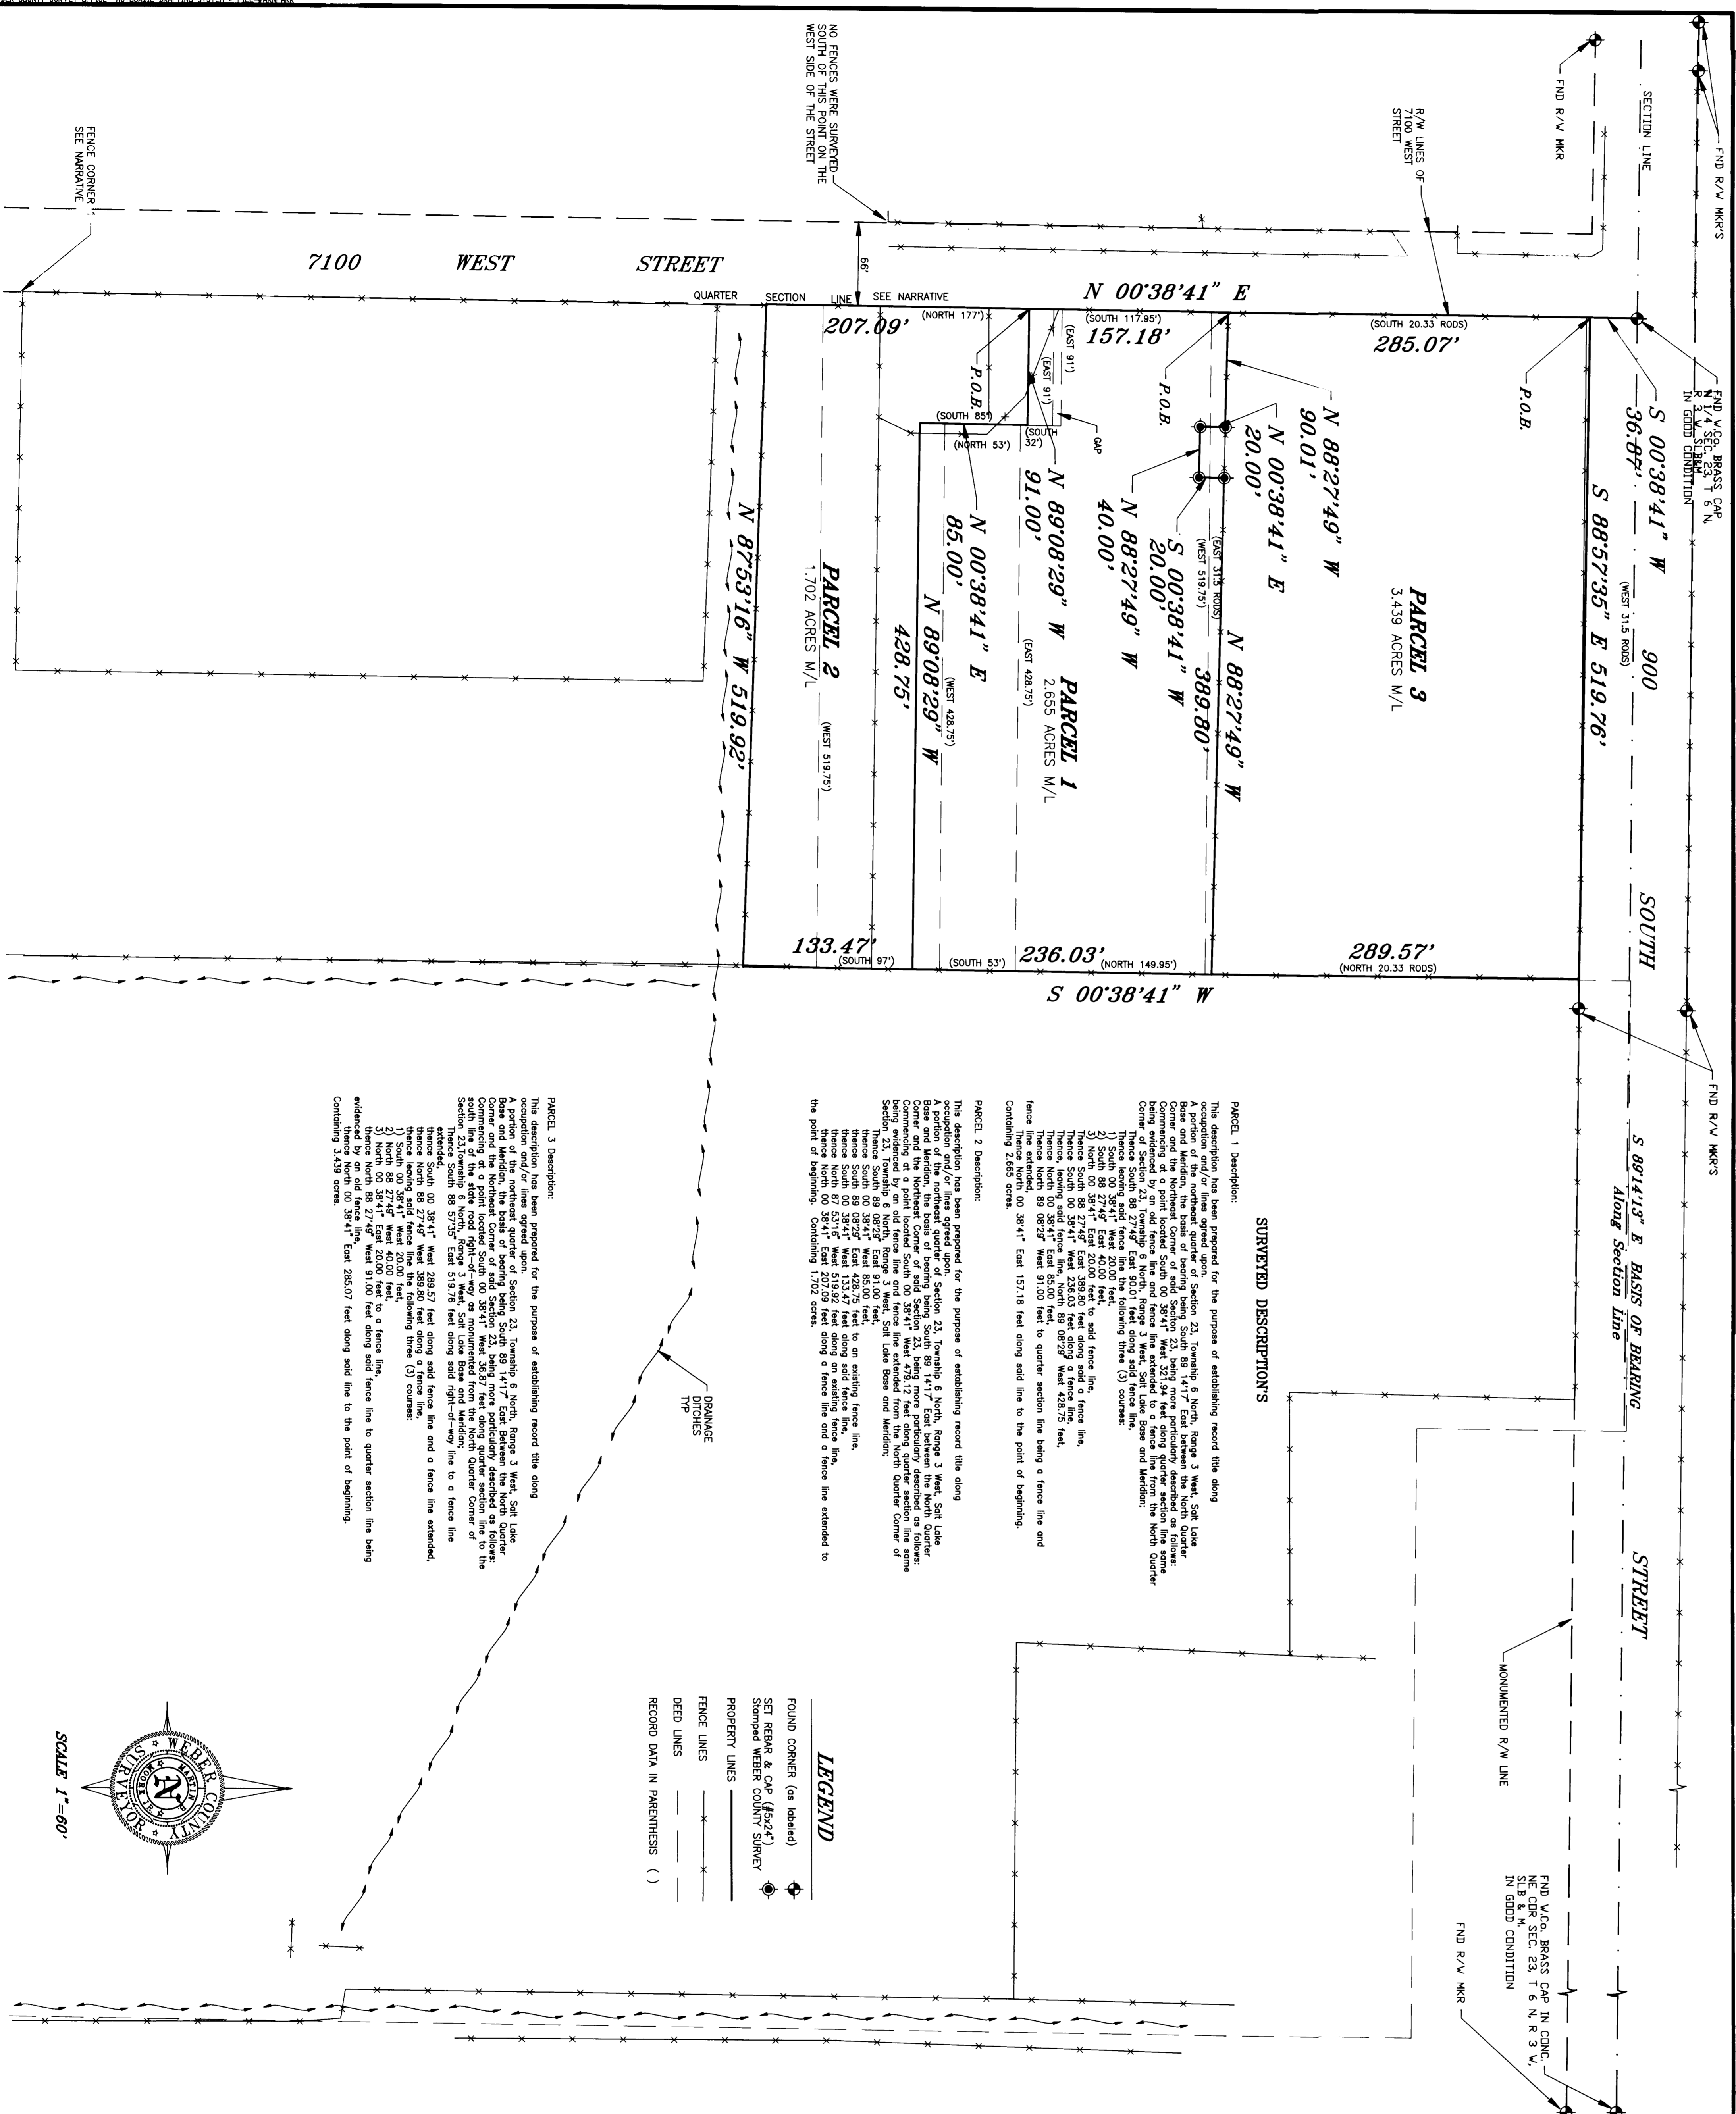


PARCEL 1 Description:
This description has been prepared for the purpose of establishing record the doing occupation and/or have opened upon.







SURVEYED DESCRIPTIONS

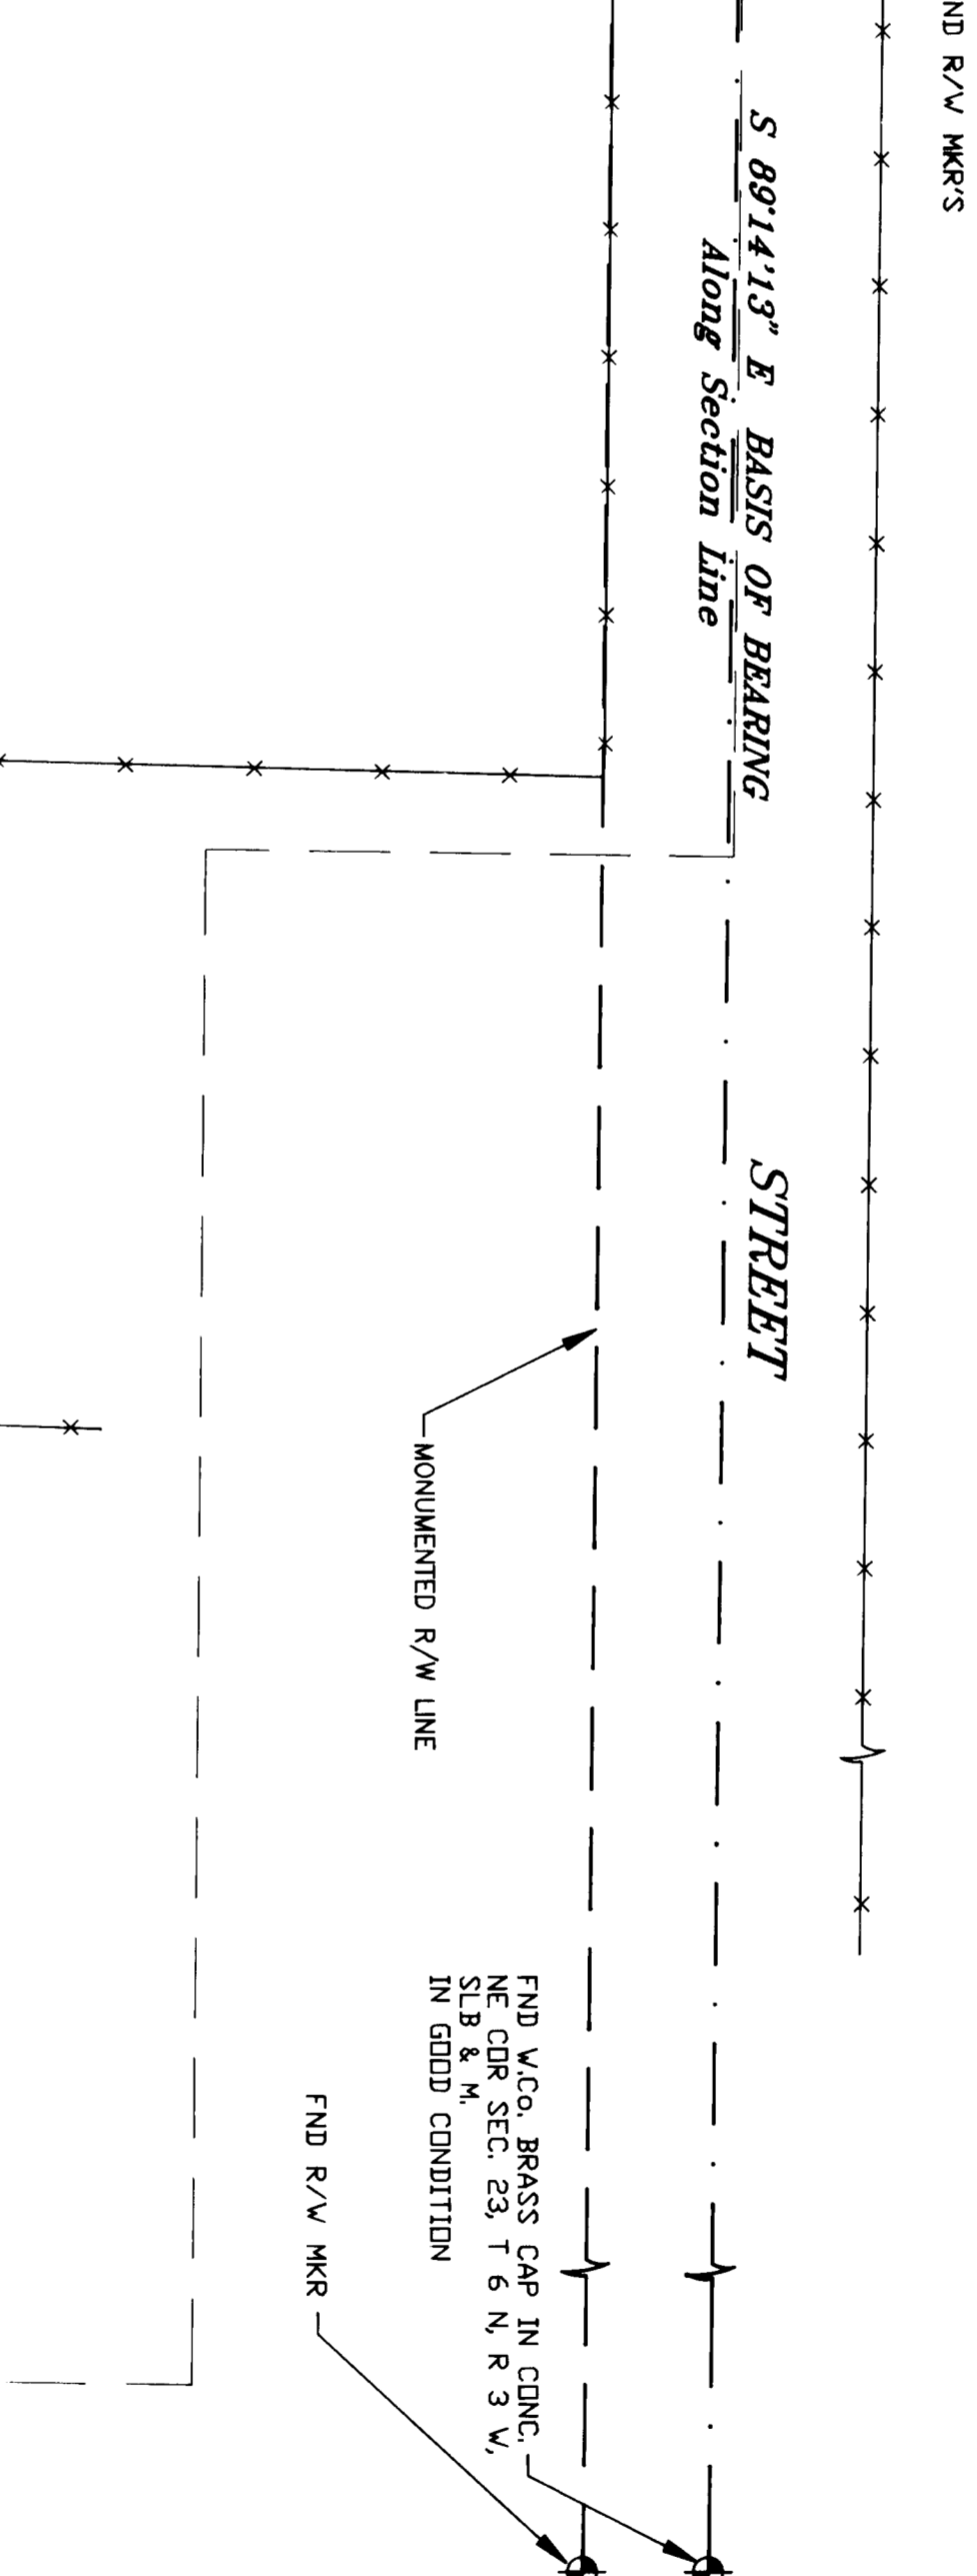

LEGEND

- FOUND CORNER (as located)
- Stamped WEBER COUNTY SURVEY
- PROPERTY LINES
- FENCE LINES
- DEED LINES
- RECORD DATA IN PARENTHESIS ()

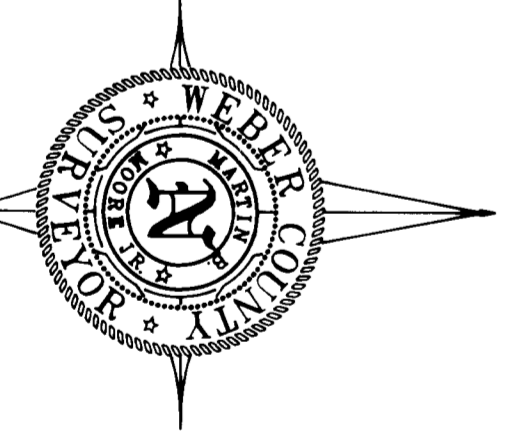

SCALE 1"=60'

WEBER COUNTY SURVEYORS' CERTIFICATE

I, MARTIN B. MOORE, JR., HAVING BEEN DULY Elected as the WEBER COUNTY Surveyor for the State of Utah, do hereby certify that I have made a survey of the tract of land shown hereon and that the same is in accordance with the laws of the State of Utah. 



BASEIS OF BEARING



NARRATIVE



BOUNDARY LINE AGREEMENT FOR COUNTY PARK
TOWNSHIP 6 NORTH, RANGE 3 WEST,
SALT LAKE BASIN AND MERIDIAN

Prepared by:
Ernest D. Rowley P.S.L.
Chief Deputy Surveyor

WEBER COUNTY
Surveyors
Ernest D. Rowley P.S.L.
Chief Deputy Surveyor

RECEIVED
RECEIVED ON THE
DAY OF OCTOBER, 1995
19 1995

