

**NARRATIVE**

THE PURPOSE OF THIS SURVEY IS TO LOCATE OR RE-LOCATE THE ORIGINAL LOT CORNERS. THE NORTHWEST AND SOUTHWEST CORNERS WERE FOUND WITH THE ORIGINAL REBAR WITH METAL T-POST AND METAL PLATE ATTACHED TO POST. THERE WAS NO EVIDENCE OF THE ORIGINALS AT THE NORTHEAST AND SOUTHEAST CORNERS.

BASIS OF BEARING, N 89° 12' 04" E, IS THE QUARTER SECTION LINE OF SECTION 29 ON THE NORTH SUB-DIVISION BOUNDARY. A CONTROL TRAVERSE FROM THIS LINE WAS USED TO COMPUTE THE POSITION OF THE INSTRUMENT IN RELATION TO THE LOT CORNERS.


**LEGAL DESCRIPTION**

ALL OF LOT 287, EVERGREEN PARK SUBDIVISION, ACCORDING TO THE OFFICIAL PLAT THEREOF ON FILE AND OF RECORD WITH THE WEBER COUNTY RECORDERS OFFICE, OGDEN, UTAH.

**LEGEND**

- PROPERTY CORNER - SET 5/8" REBAR AT NE AND SE CORNERS. FOUND ORIS'S AT NW AND SW.

JUNE 20, 1995

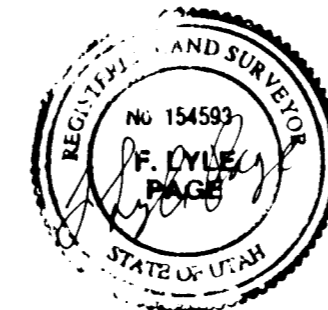

RECEIVED

DATE

BY

|   |  |           |          |                                |         |                   |
|---|--|-----------|----------|--------------------------------|---------|-------------------|
| SURVEY FOR  |  | SECTION   | TOWNSHIP | RANGE                          | DATE    | SCALE             |
| DONALD C. ROSE<br>871 GRANT AVE.<br>OGDEN, UT 84404 |  | NE 1/4 30 | 7 N      | 3 E                            | 6-22-95 | 1" = 40'          |
|   |  | LOT       |          | BLOCK                          |         | PLAT              |
|   |  | 287       |          |                                |         | EVERGREEN PARK    |
|   |  |           |          | CONTRACT SURVEYORS             |         |                   |
|   |  |           |          | REGISTERED LAND SURVEYORS      |         |                   |
|   |  |           |          | 9740 SO. SITZMARK DR. 328-5803 |         | SANDY, UTAH 84092 |