


NARRATIVE

THE PURPOSE OF THIS SURVEY IS TO SET OR RELOCATE THE ORIGINAL LOT CORNERS ON LOTS 288 AND 289. EVIDENCE OF THE ORIGINAL LOCATION WAS FOUND AT EACH CORNER EXCEPT THE NE OF LOT 288. BASIS OF BEARING, N 89°12'04"W, IS THE SUBDIVISION BOUNDARY WEST OF THE NE CORNER OF SECTION 29. A CONTROL TRAVERSE THRU THE ENTIRE SUBDIVISION WAS ESTABLISHED FROM THIS LINE.

LEGAL DESCRIPTION

ALL OF LOTS 288 AND 289, EVERGREEN PARK SUBDIVISION ACCORDING TO THE OFFICIAL PLAT THEREOF ON FILE AND OF RECORD WITH THE WEBER COUNTY RECORDER'S OFFICE, OGDEN, UTAH.

JUNE 15, 1995

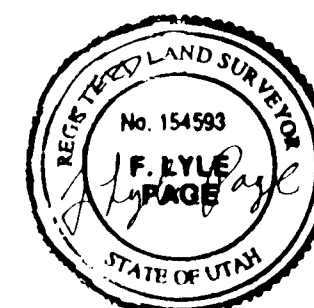

LEGEND

- PROPERTY CORNER - SET 5/8" REBAR AND YELLOW CAP - 4 PLACES

RECEIVED

SURVEY FOR  
STEVE HARROP  
5897 SO. 3650 W.  
ROY, UTAH

SECTION	TOWNSHIP	RANGE	DATE	SCALE
NE 1/4 30	7 N	3 E	6-15-95	1"=60'
S L B & M				
LOT	BLOCK	PLAT	SURVEY	
288, 289			EVERGREEN PARK SUB'D	

**CONTRACT SURVEYORS**  
REGISTERED LAND SURVEYORS  
9740 SO. SITZMARK DR. 328-5883 SANDY, UTAH 84092