





CONSTRUCTION & LAND SURVEYORS



PREPARED BY:
ORDER 2724

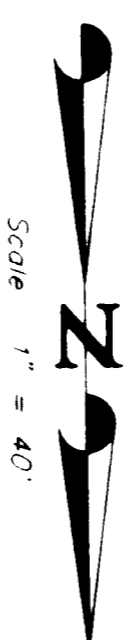

LEGEND:
() DISTANCE AND OR BEARING PER DEED OR PLAT
NO PARENTHESES IS MEASURED DISTANCE OR ROTATED PLAT
OR DEED BEARING TO STATE PLANE GRID BEARING.
EXISTING FENCES:
SET 3/4" REBAR WITH C & L.S. CAP.
STREET DEDICATION

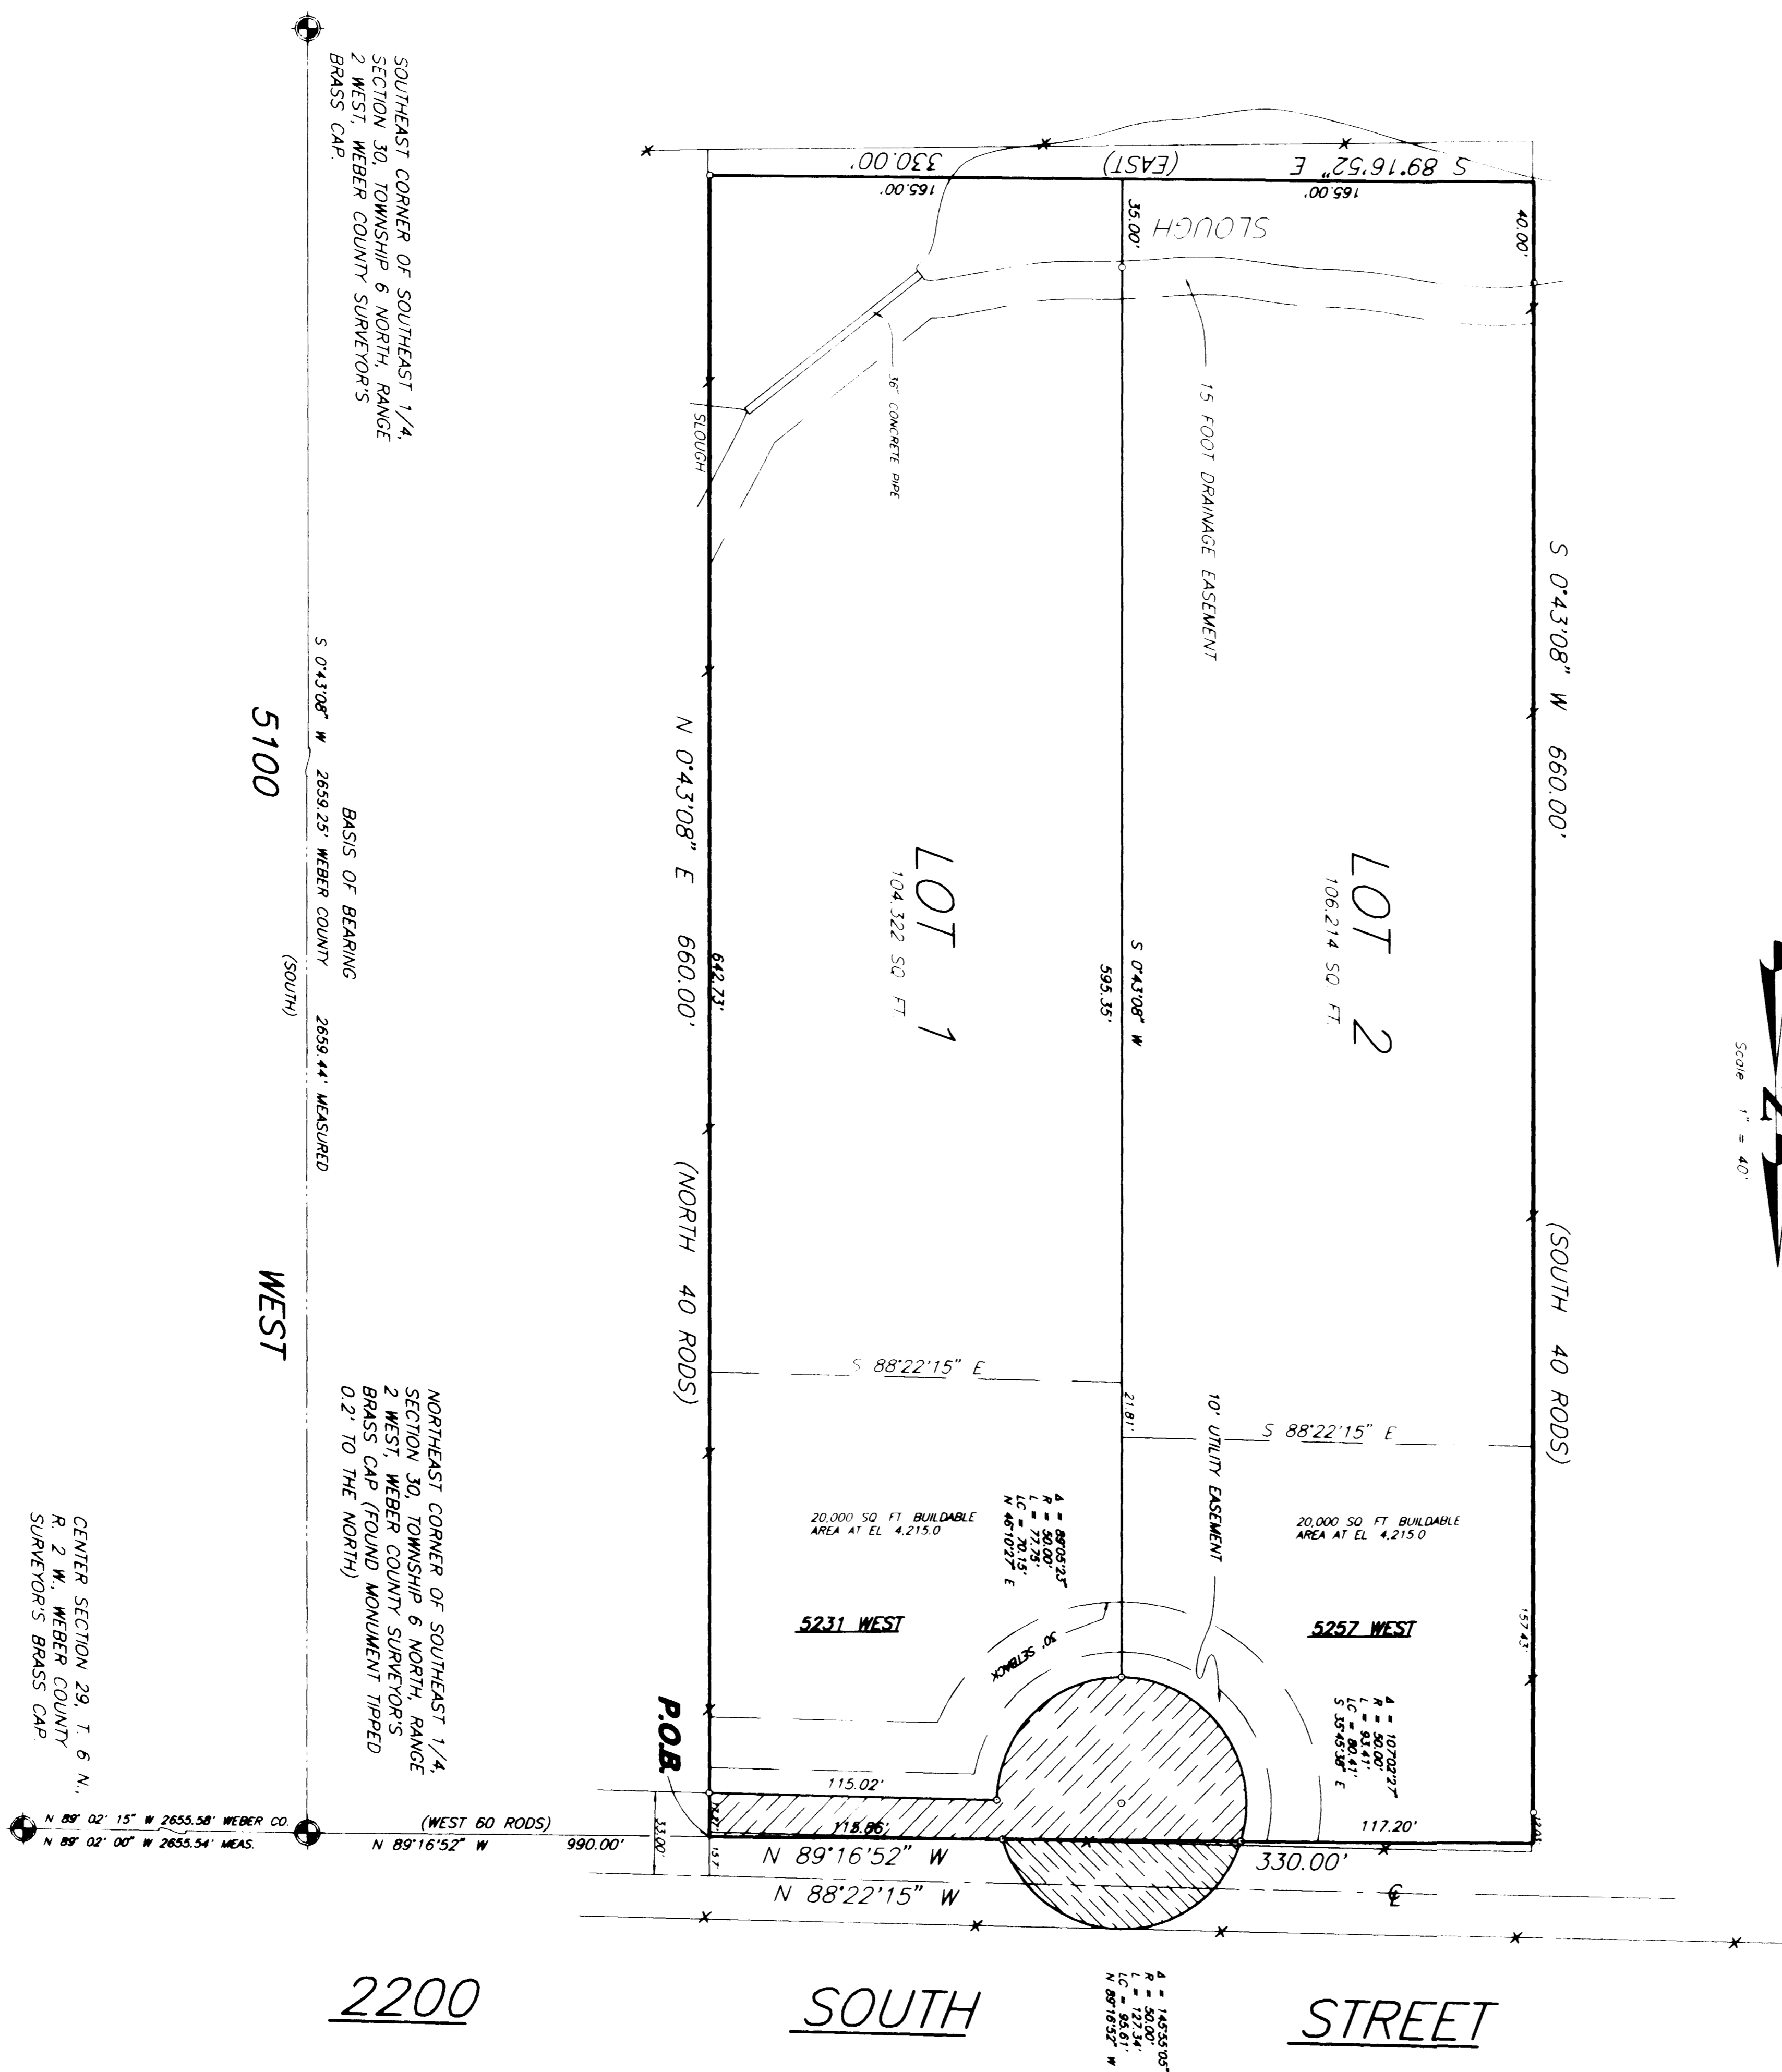

BOUNDARY DESCRIPTION

PART OF THE SOUTHWEST QUARTER OF SECTION 30, TOWNSHIP 6 NORTH, RANGE 2 WEST, SALT LAKE BASE AND MERIDIAN, BEGINNING AT A POINT IN THE SOUTHWEST CORNER OF THE SOUTHWEST QUARTER OF SECTION 30, TOWNSHIP 6 NORTH, RANGE 2 WEST, AND RUNNING N 89° 16' 52" W 330.00 FEET (WEST 20 RODS), THENCE S 0° 43' 08" W 660.00 FEET (SOUTH 40 RODS), THENCE S 88° 22' 15" E 330.00 FEET (20 RODS), THENCE N 0° 43' 08" E 660.00 FEET TO POINT OF BEGINNING, CONTAINING 3.00 ACRES.

SURVEYOR'S CERTIFICATE

I, CYNTHIA L. ROBINETT DO HEREBY CERTIFY THAT I AM A REGISTERED LAND SURVEYOR AND THAT I HOLD CERTIFICATE NO. 7511 AS DESCRIBED BY AND AM OF RECORD IN THE PUBLIC RECORDS OF THE COUNTY RECORDERS OFFICE AS DESCRIBED ABOVE AND AS SHOWN PER THIS PLAT.

6/14/95
DATED
CYNTHIA L. ROBINETT R.L.S.# 7511



NARRATIVE

THE PURPOSE OF THIS SURVEY WAS TO DEFINE ON THE GROUND THE BOUNDARIES AND TO SUBDIVIDE THE LAND INTO LOTS AND TO PROVIDE A BASIS OF BEARING TO STATE PLANE GRID BEARING ALONG THE SOUTHWEST CORNER OF SECTION 30, TOWNSHIP 6 NORTH, RANGE 2 WEST, SALT LAKE BASE AND MERIDIAN.

