




001282

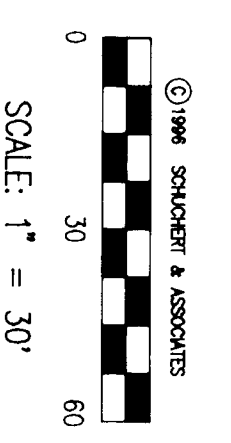




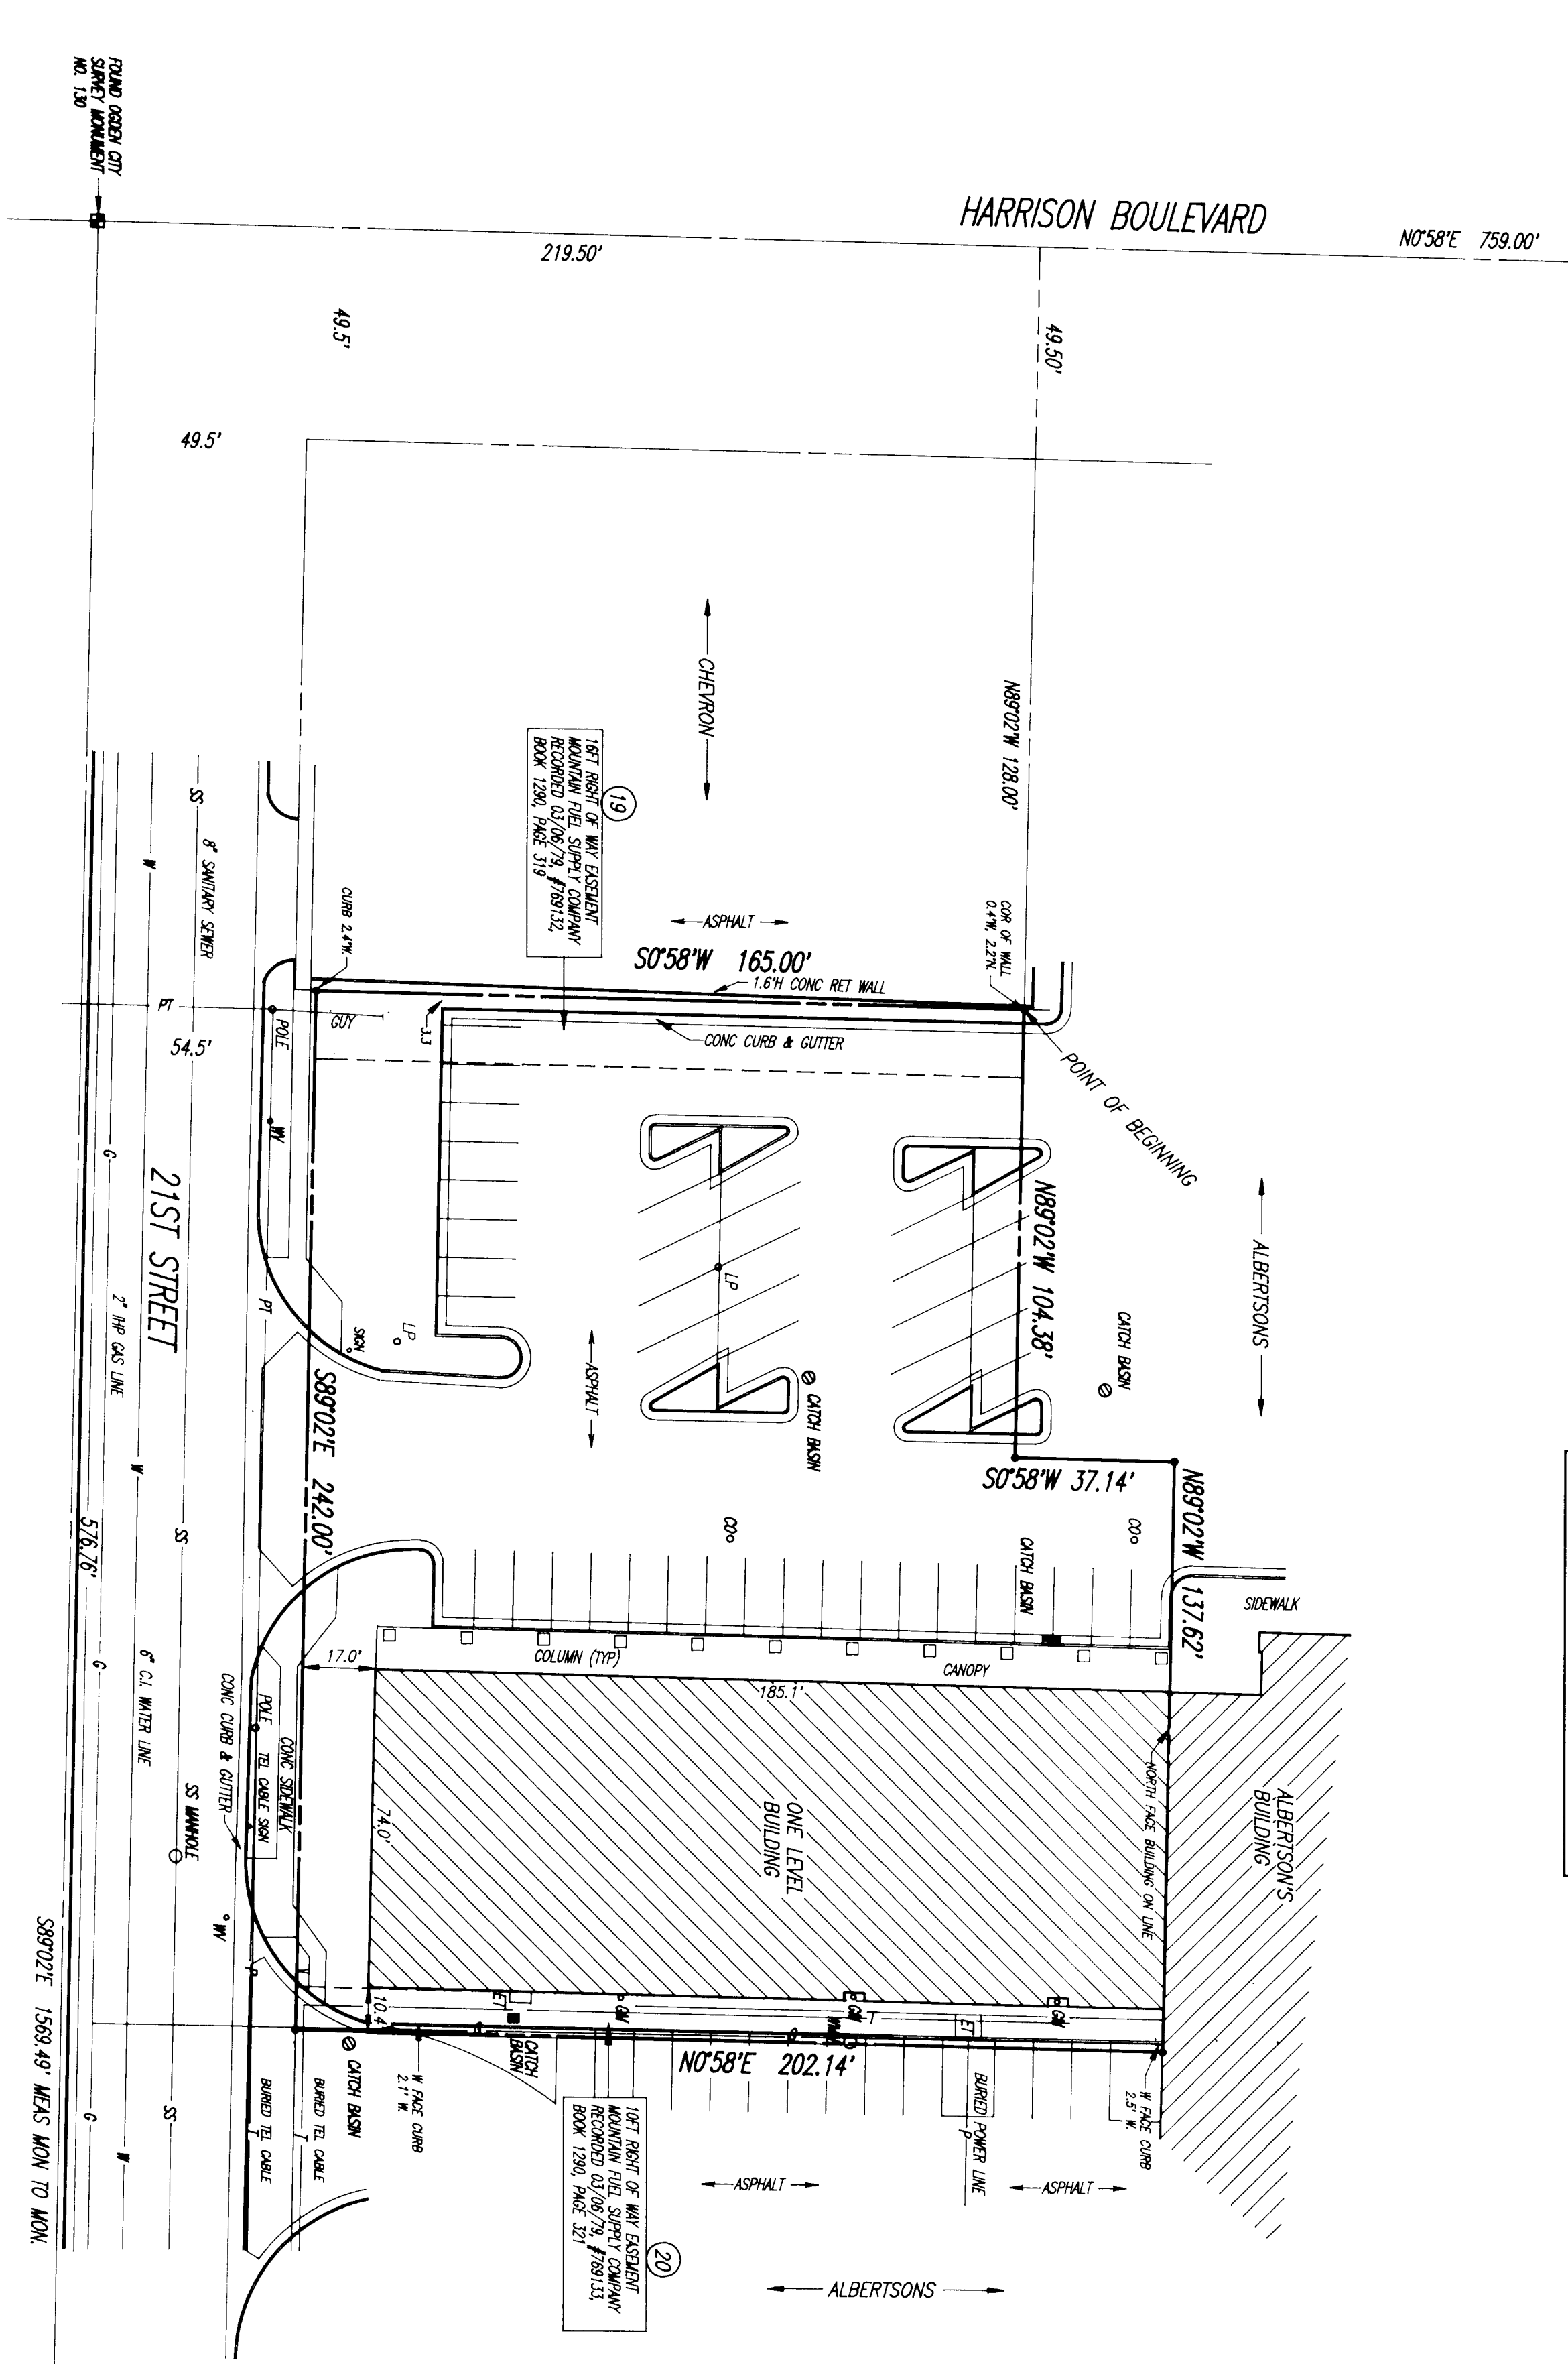

001282

001282

001282

SURVEYOR'S CERTIFICATE

TO: M&L INVESTMENTS CANYON PLAZA L.L.C.
 FROM: M&L INVESTMENTS CANYON PLAZA L.L.C.



 SCHAUCHERT & ASSOCIATES

RECEIVED
MAR 08 1996

ALTA/ACSM LAND TITLE SURVEY
 NW1/4 SEC 27, T6N, R1W, SLB & M

M&L INVESTMENTS CANYON PLAZA L.L.C.

- COMMENTS**
1. THE PURPOSE OF THIS SURVEY IS TO PROVIDE A BASIC ALTA/ACSM LAND TITLE SURVEY UPON THE SUBJECT PROPERTY.
 2. THE BASIS OF BEARING FOR THIS SURVEY IS NORTH ALONG THE HARRISON BOULEVARD MONUMENT LINE.
 3. VARYING DEPTHS OF SNOW COVERED THE GROUND DURING THIS SURVEY.

FLOOD BOUNDARY NOTE

THE SUBJECT PROPERTY LIES WITHIN AN AREA HAVING A FLOOD DESIGNATION "A" AS SHOWN ON THE FLOOD INSURANCE RATE MAP COMMUNITY PANEL NO. 480199 0004 B WITH AN EFFECTIVE DATE OF JANUARY 18, 1981.

ZONING AND SETBACKS

THE SUBJECT PROPERTY IS ZONED PLANNED COMMERCIAL (PC-2) WITH A 20 FOOT SETBACK FROM STRIPS AND 10 FEET FROM RESIDENTIAL ZONES.

AREA


THE SUBJECT PROPERTY CONTAINS 4504 SQUARE FEET OR 1.046 ACRES.

UTILITY NOTE

THE UNDERGROUND UTILITIES SHOWN HAVE BEEN LOCATED FROM ABOVE GROUND SURVEY TIES AND/OR EXISTING UTILITY EXHIBITS. THESE UTILITY LOCATIONS MAY NOT CORRESPOND EXACTLY TO THE EXACT LOCATION INDICATED, ALTHOUGH THEY ARE LOCATED AS ACCURATELY AS POSSIBLE FROM THE INFORMATION PROVIDED TO US. CALL BLUE STAKES BEFORE DIGGER.

LEGAL DESCRIPTION



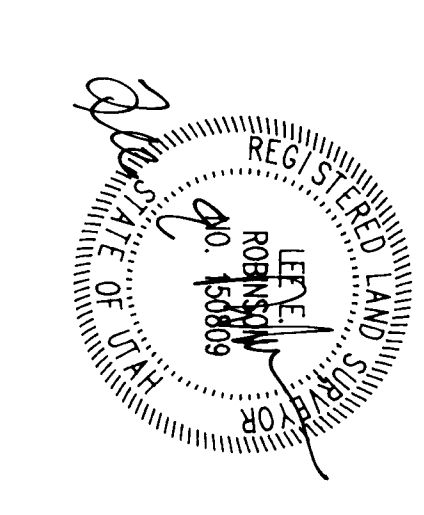

RBB

SCHAUCHERT & ASSOCIATES
 PROFESSIONAL LAND SURVEYORS
 961 W. 4000 S. SUITE 200
 SALT LAKE CITY, UTAH 84117-2881
 (801) 586-1118 • (801) 288-5814 FAX

DATE	DESCRIPTION	SHEET

001282