

DATE	10-5-92
BY	JK
CHECKED	JK
SCALE	1"=100'

PROJECT NO.	JK-92-02
DATE	10-5-92
BY	JK
CHECKED	JK
SCALE	1"=100'

REEVE & REEVE, INC.
 CIVIL AND ENVIRONMENTAL ENGINEERING

RECORD OF SURVEY



LARRY CARVER PROPERTY

SHEET 1 OF 1
 SHEETS

NOTE: BEARINGS IN PARENTHESES ARE FROM DEED AND RECORDS TO REFLECT CURRENT NEBER COUNTY SURVEY RECORDS, USING U.S. GEODETIC GRID BEARINGS.

NARRATIVE

THE PURPOSE OF THIS SURVEY WAS TO ESTABLISH THE BOUNDARY OF THIS PROPERTY AND TO SET THE CORNERS AS SHOWN HEREON. THE BASIS OF BEARINGS BEING THE LINE BETWEEN N. 1/4 COR AND THE NW COR OF SEC. 26, T. 7N., R. 2W., S. 18.5M. AND IS SHOWN HEREON AS N 89° 46' 57" E.

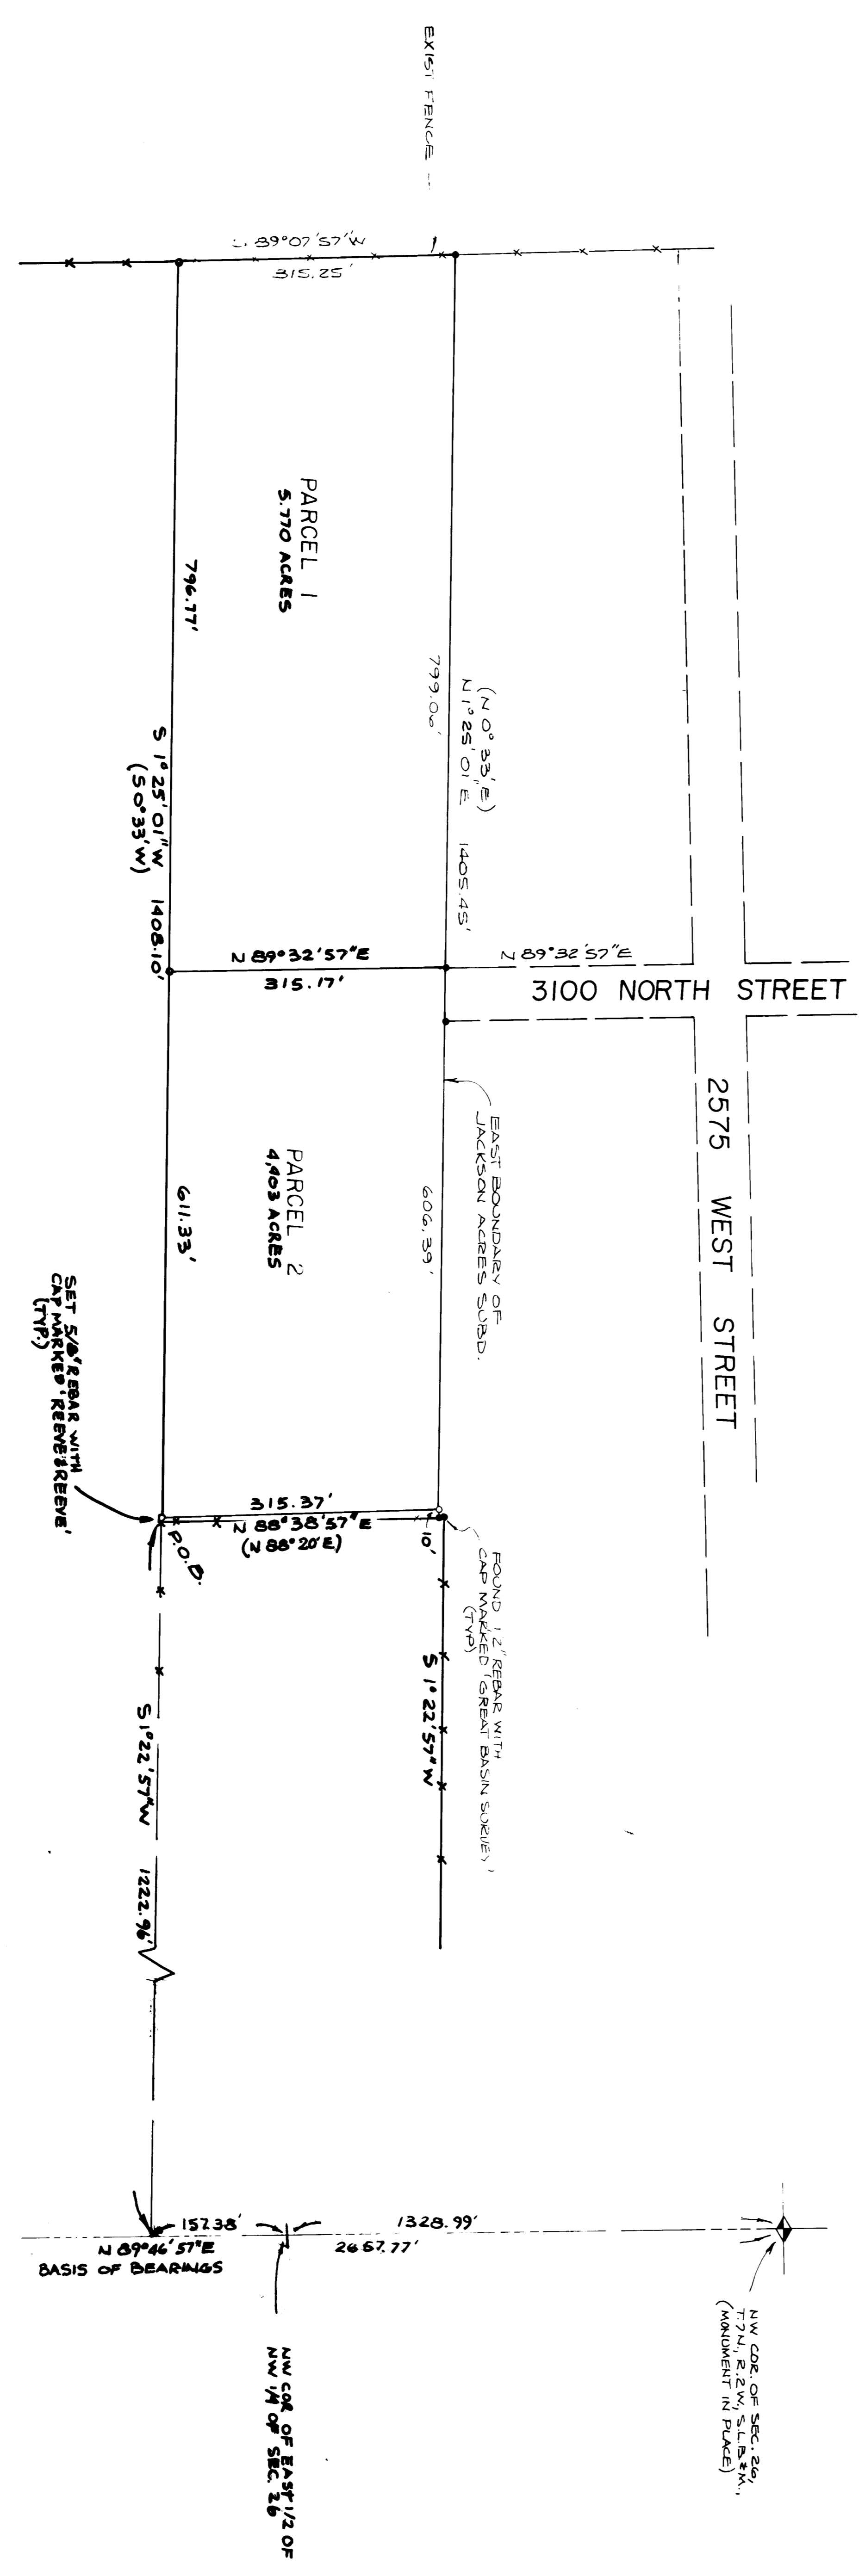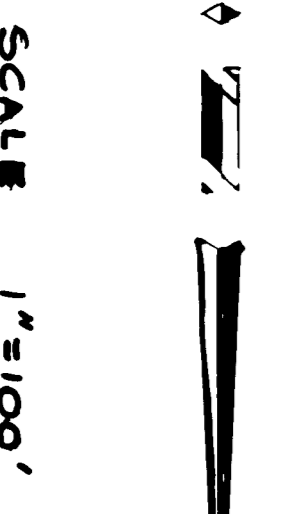

BOUNDARY DESCRIPTION

PARCEL 1

A PART OF THE NORTHWEST QUARTER OF SECTION 26, T. 7 N., R. 2 W., S. 18.5 M., DESCRIBED AS FOLLOWS:
 BEGINNING AT A POINT N 89° 46' 57" E 157.38 FEET ALONG THE SECTION LINE (BASIS OF BEARINGS) AND S 1° 22' 57" W 1222.96 FEET FROM THE NORTHWEST CORNER OF THE EAST HALF OF THE NORTHWEST QUARTER OF SECTION 26, T. 

BOUNDARY DESCRIPTION

PARCEL 2

A PART OF THE NORTHWEST QUARTER OF SECTION 26, T. 7 N., R. 2 W., S. 18.5 M., DESCRIBED AS FOLLOWS:



RECEIVED
 OCT 5 1992
 NEBER COUNTY SURVEY