


PLAN HOLD CORPORATION • IRVINE, CALIFORNIA
REGISTERED NUMBER 3700
REGISTERED UNDER PUBLIC LAW

PLAN HOLD CORPORATION • IRVINE, CALIFORNIA
REGISTERED NUMBER 3700
REGISTERED UNDER PUBLIC LAW

PLAN HOLD CORPORATION • IRVINE, CALIFORNIA
REGISTERED NUMBER 3700
REGISTERED UNDER PUBLIC LAW

PLAN HOLD CORPORATION • IRVINE, CALIFORNIA
REGISTERED NUMBER 3700
REGISTERED UNDER PUBLIC LAW

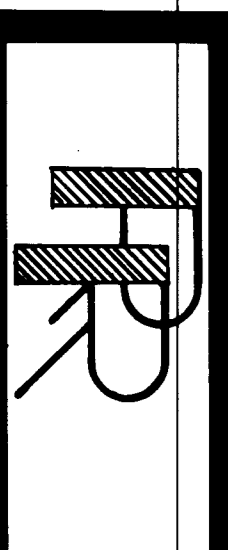

DATE	11.23.91
BY	JPR
DATE	11.23.91
BY	JPR

PROJECT NO.	91-1099
DATE	11.23.91
BY	JPR
DATE	11.23.91
BY	JPR



RECORD OF SURVEY

GRANT ANDERSEN PROPERTY

RECEIVED
MAY 0 6 1996

Welder County Surveyor

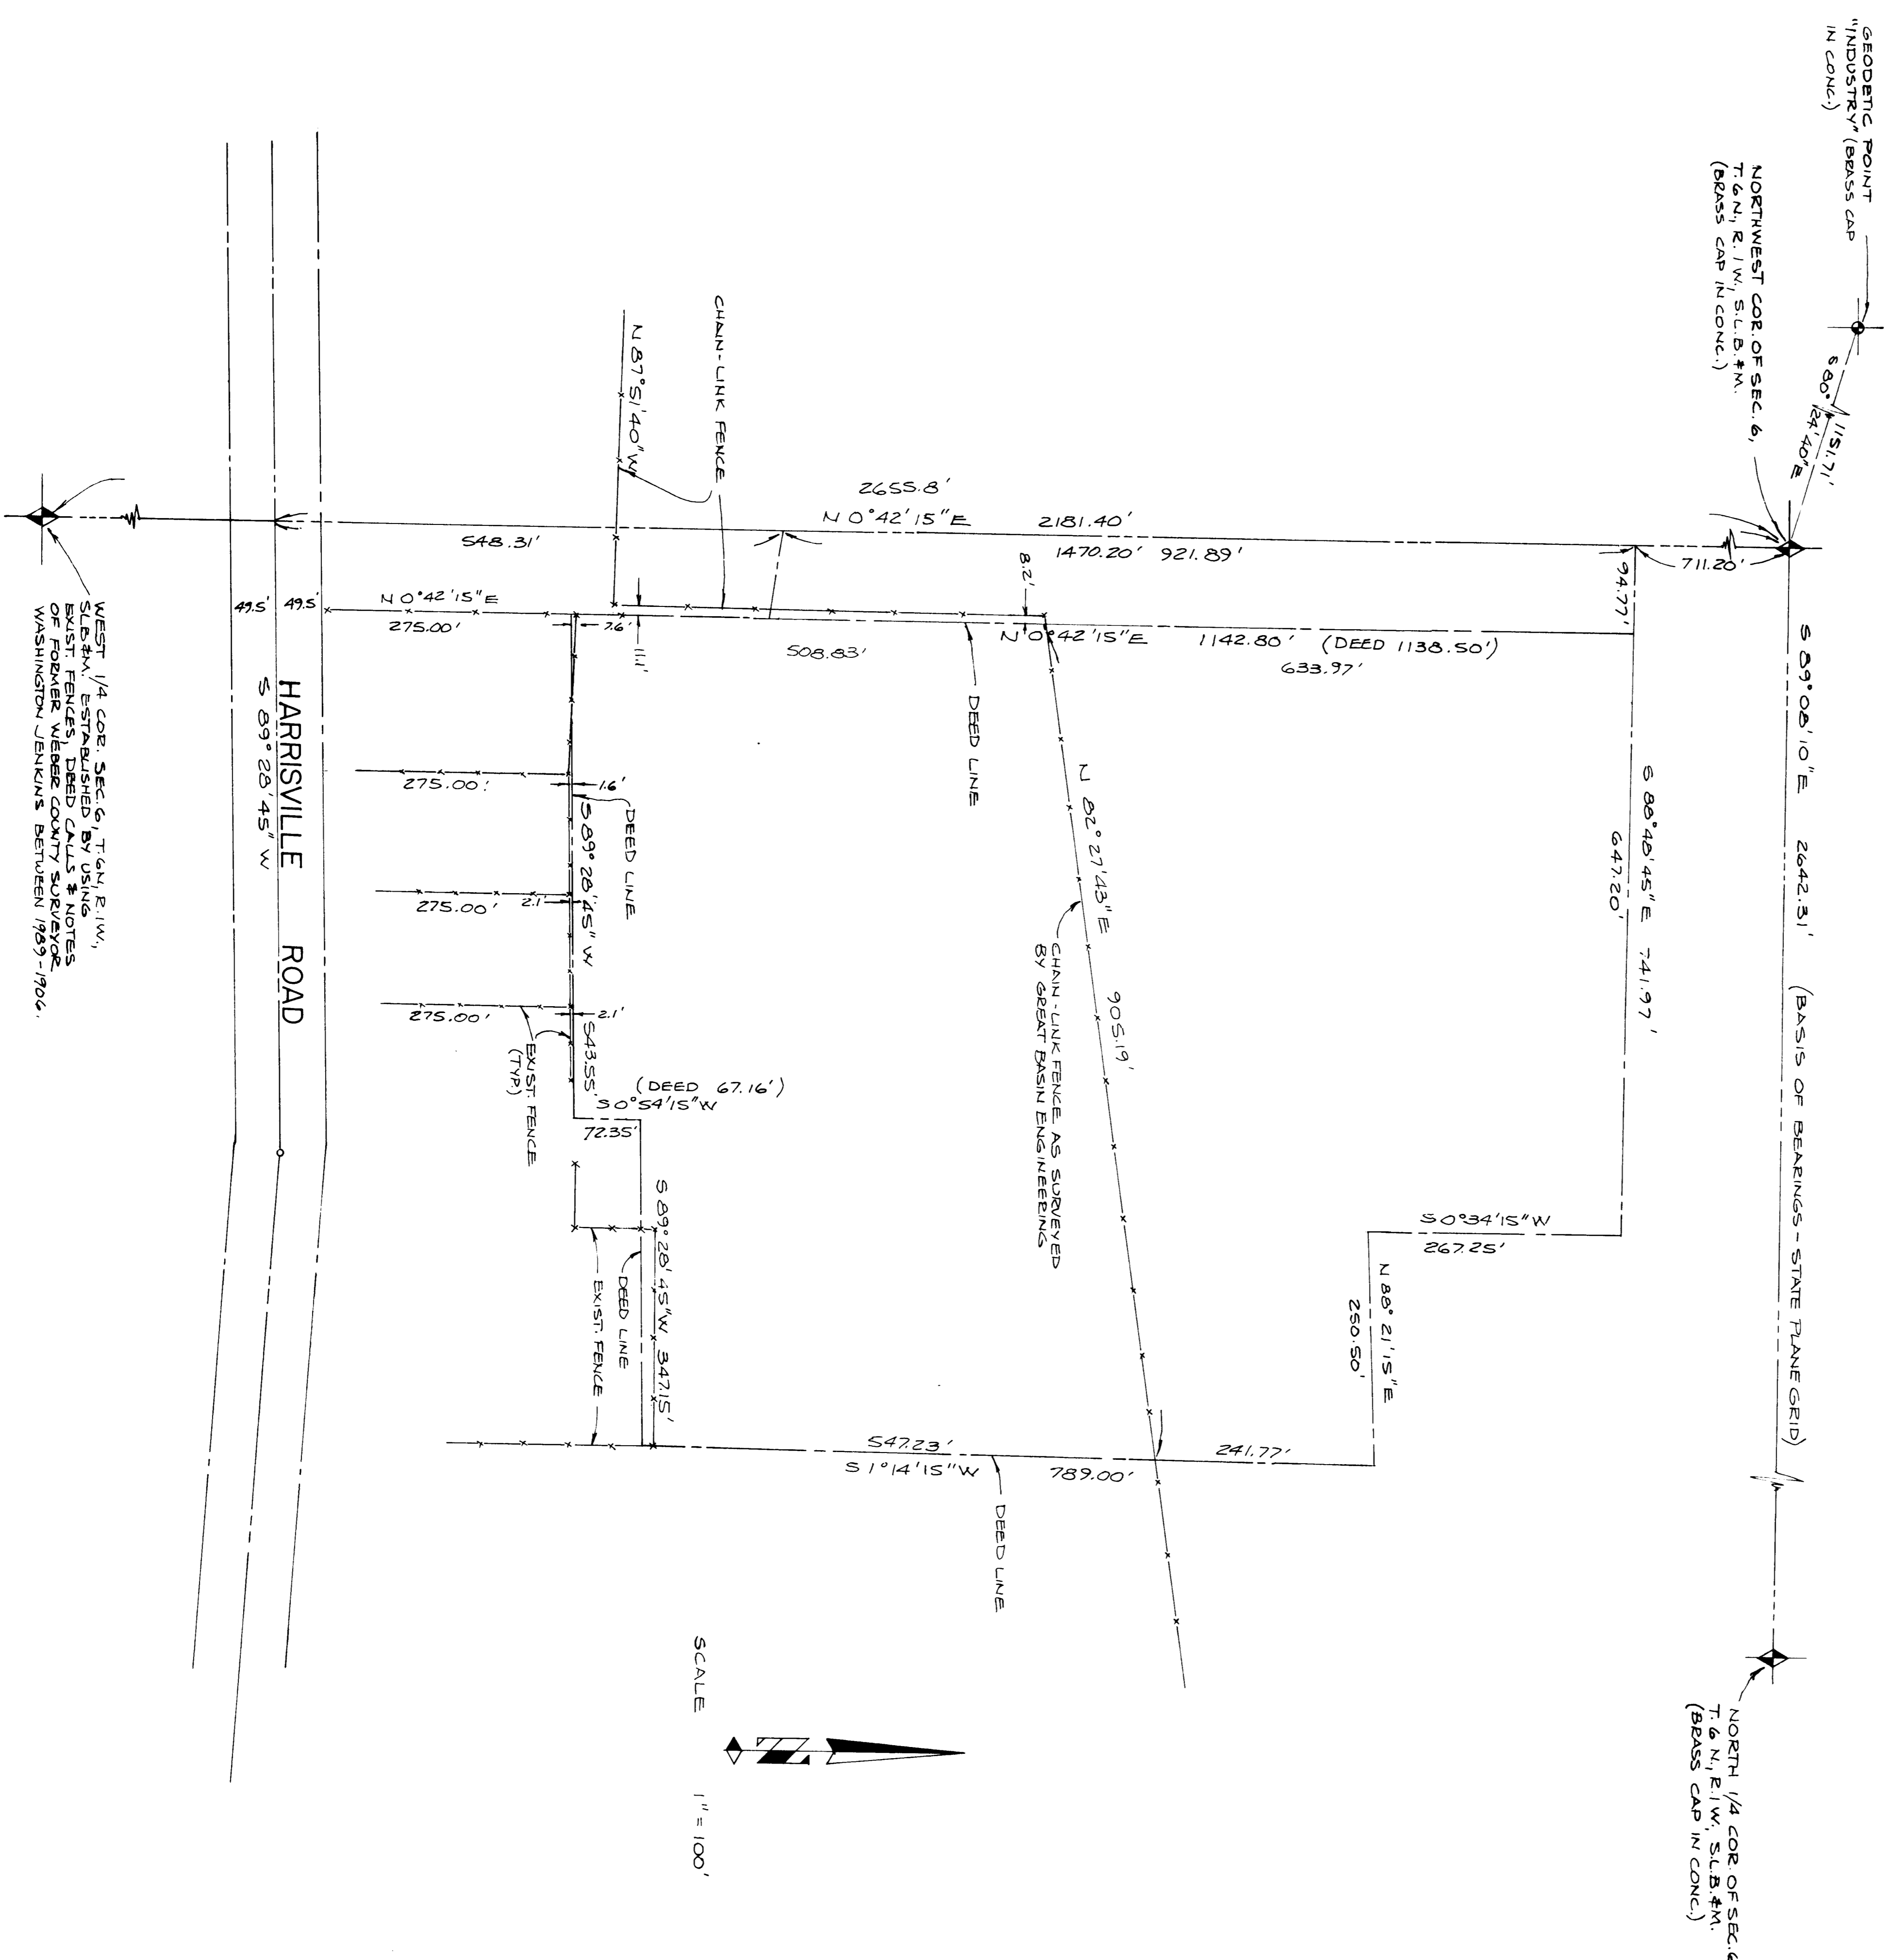


NARRATIVE

MANY EXISTING FENCES SOUTH OF THE NORTHWEST CORNER WERE FOUND AND COMPARED TO THE BEARINGS AND DISTANCES OF THE DEEDS FROM 1899 TO 1956 AND SURVEY INFORMATION FROM THE NOTES OF FORMER COUNTY SURVEY, WASHINGTON JENKINS 1899. THE PROPERTY LINES WERE ESTABLISHED USING THIS INFORMATION.

CERTIFICATION

I, JOHN P. REEVE, DO HEREBY CERTIFY THAT I AM A REGISTERED LAND SURVEYOR, AND THAT I DO HOLD CERTIFICATION NO. 2492, AS PRESCRIBED BY THE CHARTER OF THE STATE ENGINEER, CERTIFYING THAT THE ABOVE PLAT CORRECTLY SHOWS THE TRUE DIMENSIONS OF THE PROPERTY SURVEYED.

MAY 12 1991
JOHN P. REEVE

