

# A PART OF BLOCK 2, TERRACE SUBDIVISION OGDEN CITY, WEBER COUNTY, UTAH.

## SURVEYORS CERTIFICATE

I, DOUG L. GRAHAM, A REGISTERED LAND SURVEYOR AS PRESCRIBED BY THE LAWS OF THE STATE OF UTAH AND HOLDING LICENSE NUMBER 17275 DO HEREBY CERTIFY THAT I MADE A SURVEY OF THE ABOVE DESCRIBED PROPERTY AND THE PLAT HEREON IS A TRUE AND CORRECT REPRESENTATION OF SAID SURVEY.

DATE: FEB. 14, 1996 SIGNED: DOUG L. GRAHAM




### NARRATIVE:

THE PURPOSE OF THIS SURVEY WAS TO ESTABLISH THE PROPERTY CORNERS OF LOTS 7 AND 8, COMBINED, OF TERRACE SUBDIVISION, AND SHOW THE RELATION TO THE ADJOINING FRONTAGES. THE MEASURED DISTANCE TO THE RAILROAD SPIKE AT 10th STREET AND IT'S RELATION TO THE OCCUPATION LINES WAS USED TO DETERMINE THE INTERSECTION.

### \*BOUNDARY DESCRIPTION\*

ALL OF LOTS 7 AND 8, BLOCK 2, TERRACE SUBDIVISION, OGDEN CITY, WEBER COUNTY, UTAH.

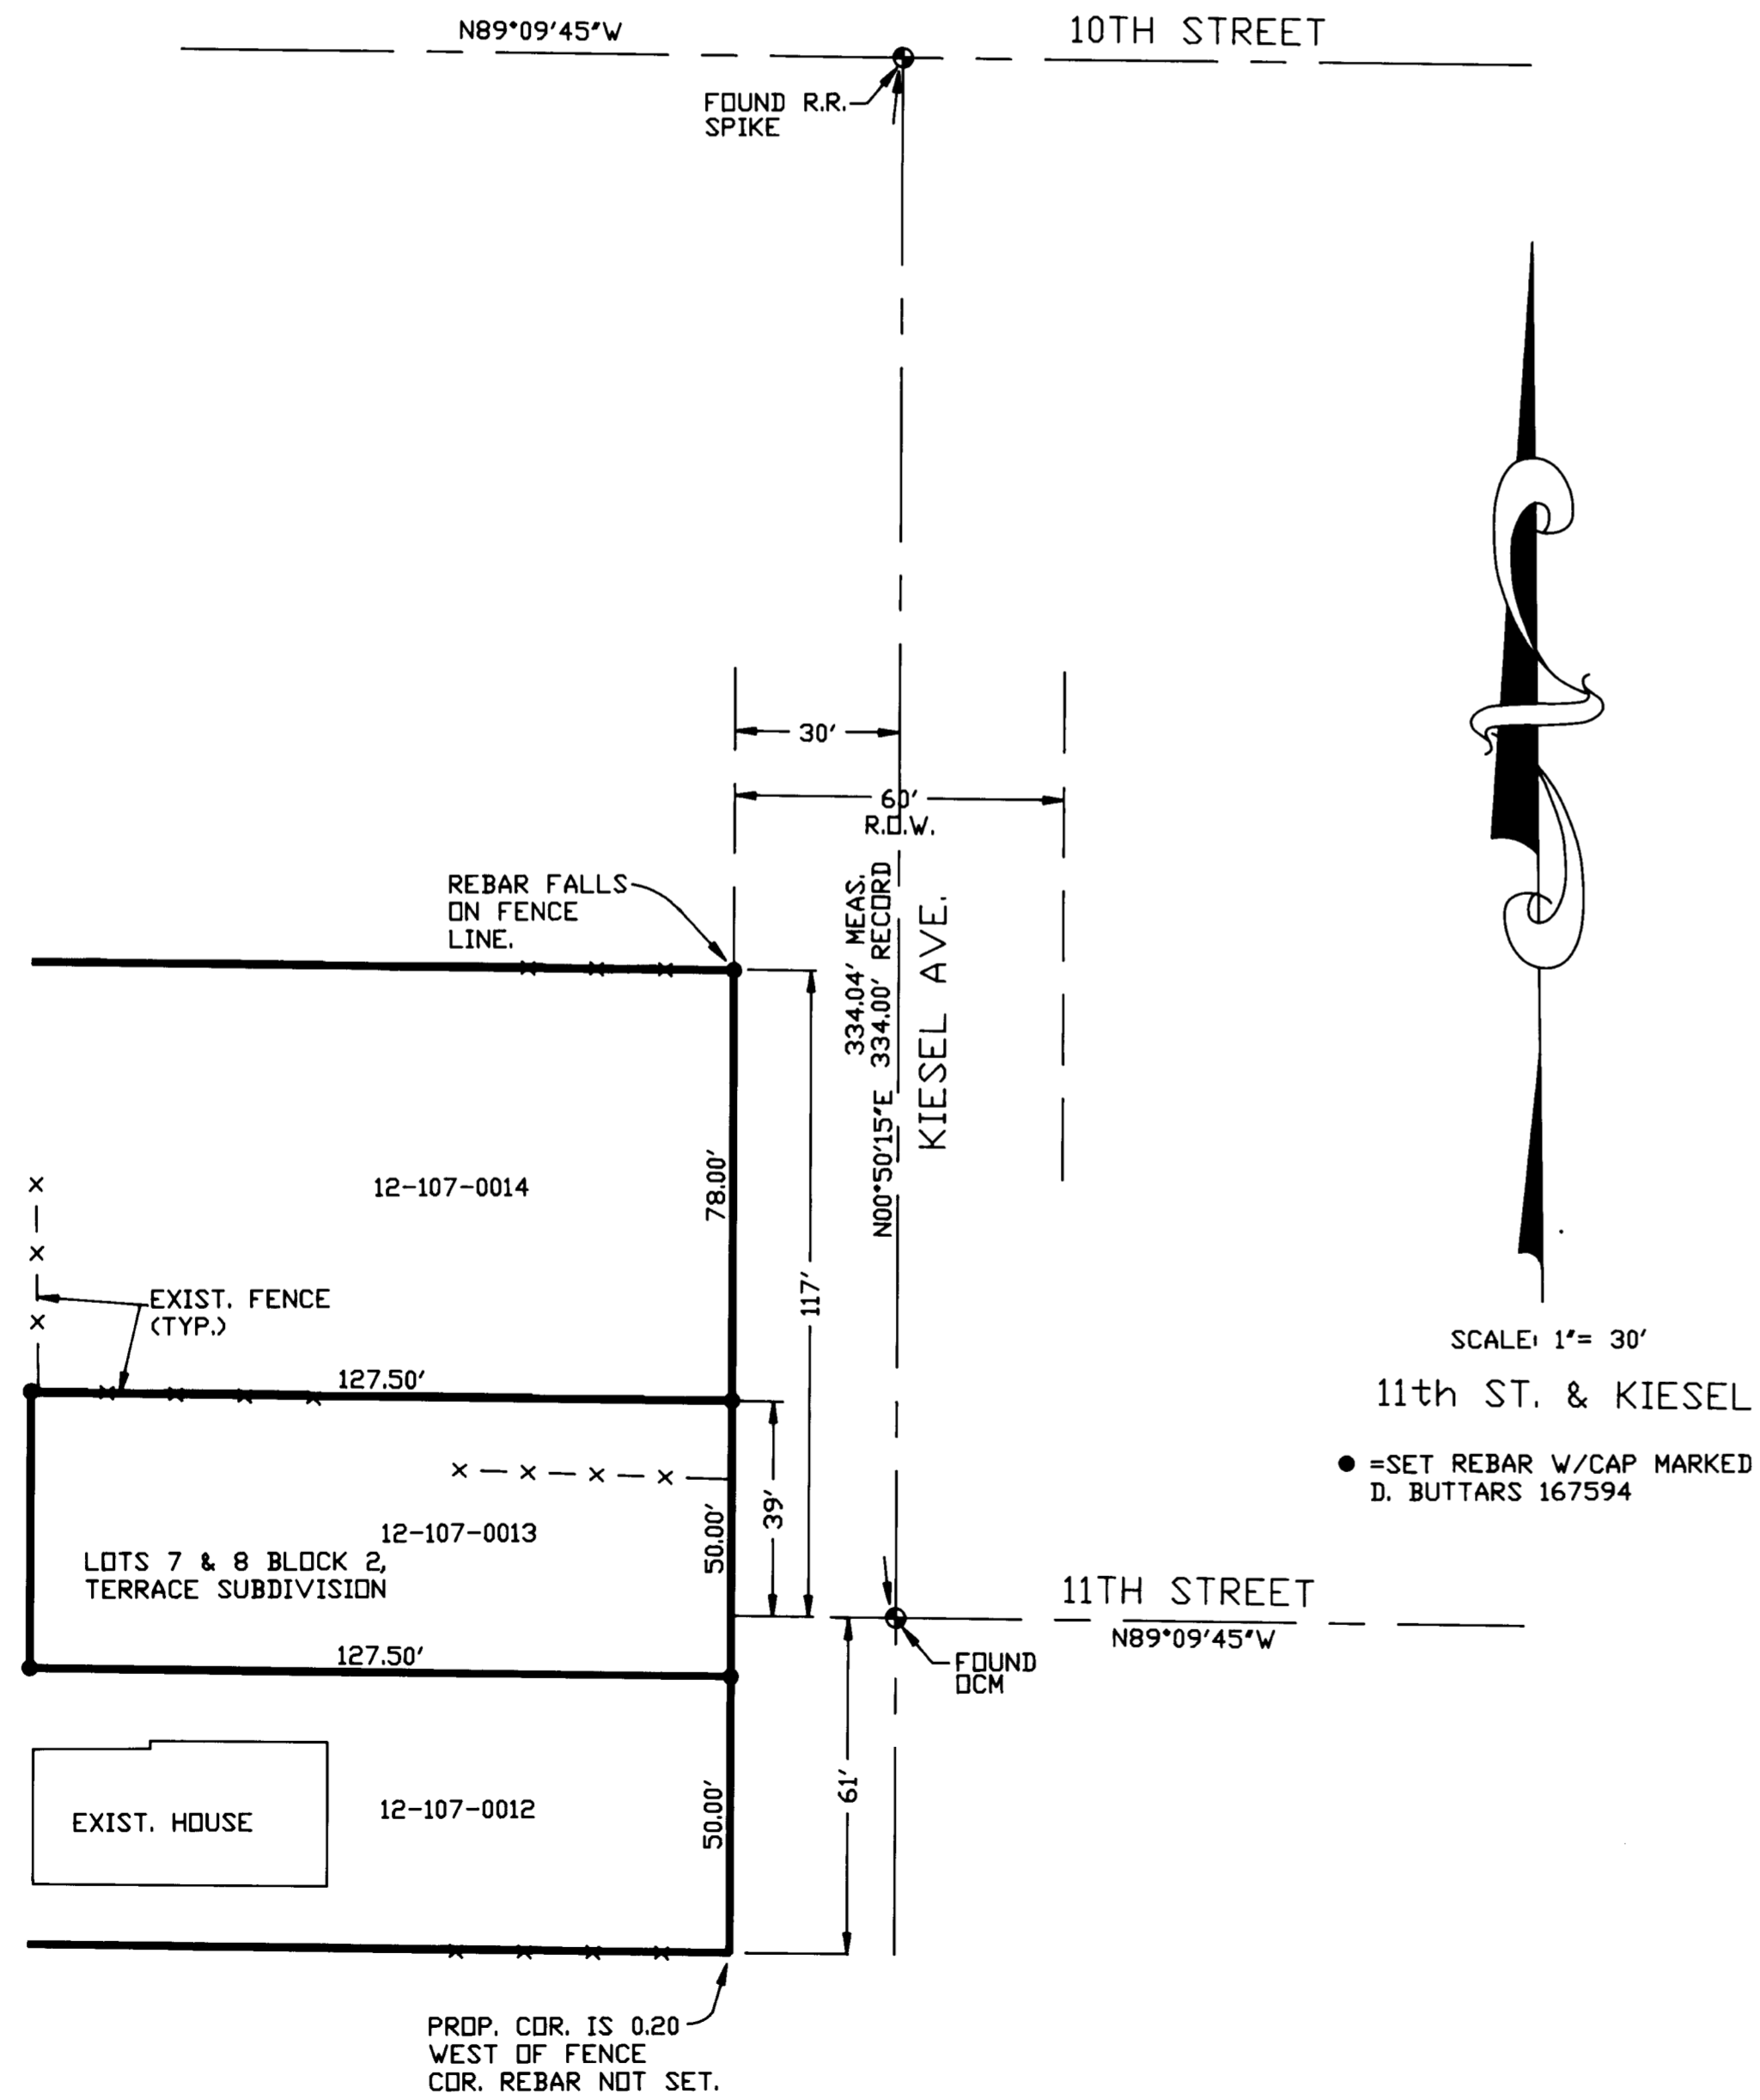

RECEIVED  
FEB 14 1996  
Weber County Surveyor

**LANDMARK SURVEYING**  
A COMPLETE SURVEYING SERVICE  
2406 GRANT AVE. SUITE 318 OGDEN, UTAH 84401  
PE 827-4014  
CLIENT: OGDEN CITY RDA  
LOCATION: 11th STREET AND KIESEL  
SURVEYED: JAN, 3, 1996