


SCALE: 1" = 50'  
● = REBAR & CAP SET

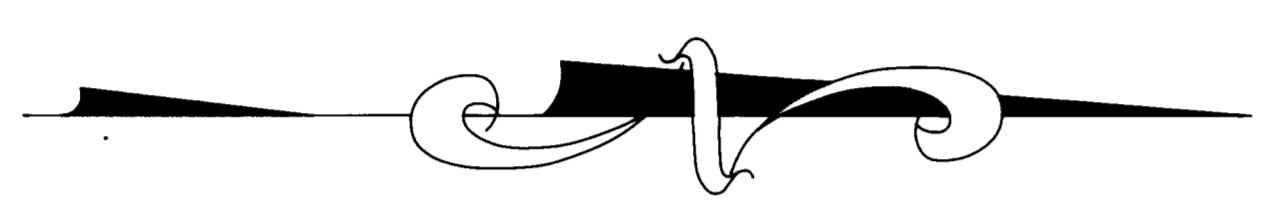

### SURVEYORS CERTIFICATE

I, DALLAS K. BUTTARS, A REGISTERED LAND SURVEYOR AS PRESCRIBED BY THE LAWS OF THE STATE OF UTAH AND HOLDING LICENSE NUMBER 6985, DO HEREBY CERTIFY THAT I MADE A SURVEY OF THE BELOW DESCRIBED PROPERTY AND THE PLAT HEREON IS A TRUE AND CORRECT REPRESENTATION OF SAID SURVEY.

DATE: 8-11-95 SIGNED: Dallas K. Buttars

#### DESCRIPTION A


PART OF THE WEST HALF OF SECTION 6, TOWNSHIP 6 NORTH, RANGE 1 WEST, SALT LAKE BASE AND MERIDIAN, BEGINNING FROM A POINT 1045.01 FEET EAST AND 699.71 FEET NORTH FROM THE NORTH QUARTER CORNER OF SAID SECTION 6, SAID POINT BEING ON THE SOUTH LINE OF HARRISVILLE ROAD AND RUNNING THENCE SOUTH 65°39'00" EAST 287.97 FEET ALONG SAID SOUTH LINE OF ROAD, THENCE SOUTH 24°21'00" WEST 162.78 FEET, THENCE NORTH 65°39'00" WEST 348.13 FEET, NORTH 24°21'00" EAST 151.25 TO THE POINT OF BEGINNING.

#### DESCRIPTION B

PART OF THE WEST HALF OF SECTION 6, TOWNSHIP 6 NORTH, RANGE 1 WEST, SALT LAKE BASE AND MERIDIAN, BEGINNING FROM A POINT 1045.01 FEET EAST AND 699.71 FEET NORTH FROM THE NORTH QUARTER CORNER OF SAID SECTION 6, SAID POINT BEING ON THE SOUTH LINE OF HARRISVILLE ROAD AND RUNNING THENCE NORTH 65°39'00" WEST 200.00 FEET ALONG SAID SOUTH LINE OF ROAD, THENCE SOUTH 24°21'00" WEST 151.25 FEET, THENCE SOUTH 65°39'00" EAST 200.00 FEET, NORTH 24°21'00" EAST 151.25 TO THE POINT OF BEGINNING.

CLIENT: WADE HURD  
LOCATION: PART OF THE W 1/2 SEC. 6  
T. 6N., R. 1W., S. 17E. & W.  
SURVEYED: 8-11-95

RECEIVED  
MAY 13 1995  
Weber County Surveyors

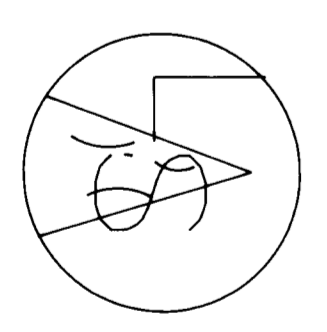

LANDMARK SURVEYING  
A COMPLETE SURVEYING SERVICE  
2485 GRANT AVE. SUITE 318-B OGDEN, UTAH 84401  
PH 627-4014 392-5291

RECEIVED  
MAY 11 1995  
Weber County Surveyors