
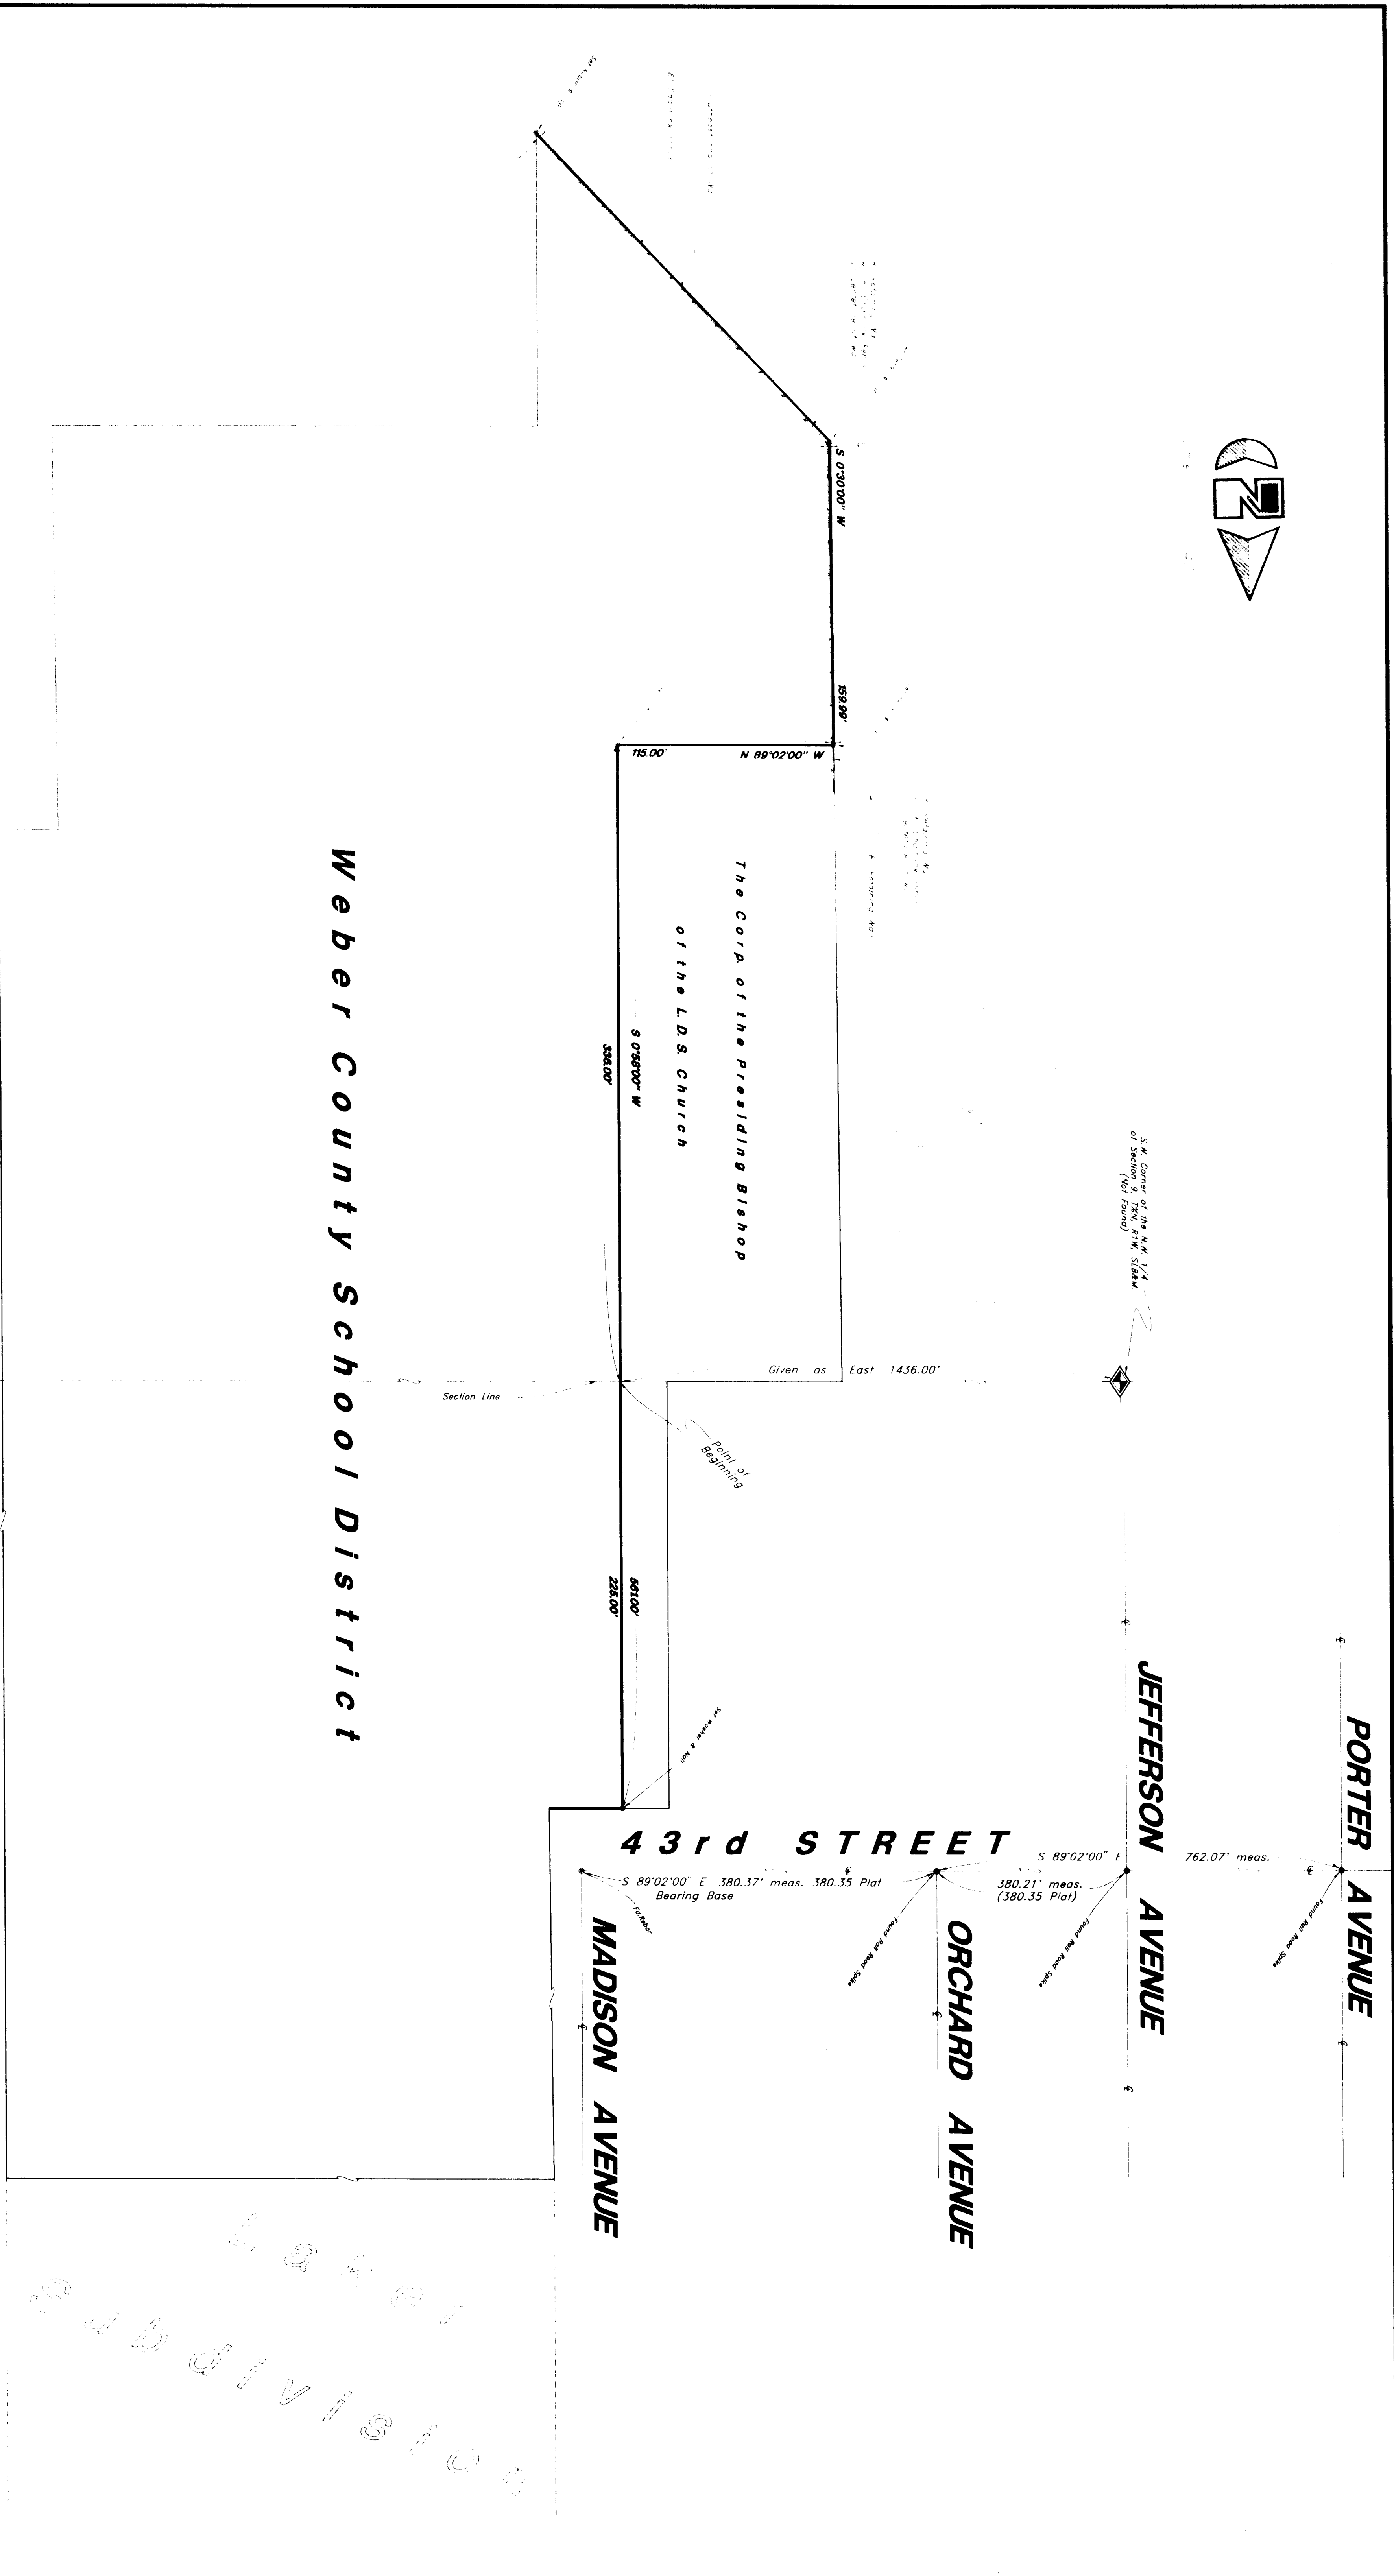


4-19-95

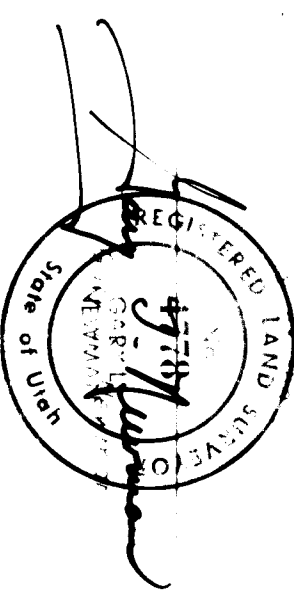

Weber County School District

The Corp. of the Presiding Bishop of the LDS Church

43rd STREET

MADISON AVENUE

ORCHARD AVENUE

JEFFERSON AVENUE

PORTER AVENUE

Later subdivision

Section Line

Given as East 1436.00'


Point of Beginning

Bearing Base



BOUNDARY SURVEY

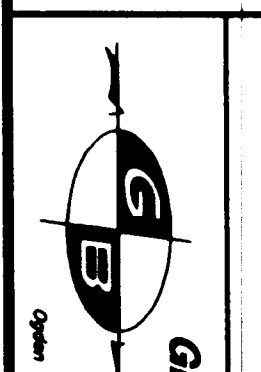

GREAT BASIN ENGINEERING, INC.
5544 Lincoln Avenue, Ogden, Utah, 84401
P.O. Box 8207, Ogden, Utah, 84409
Phone: (801) 464-4919 Fax: (801) 464-4919

Scale: 1" = 40'
Date: 7 Jul, 1995

Mar Lon Hines Emergency School
C/S: Part of lots 10, 11, 12, 1000

RECEIVED
MAY 1 1995
Weber County Surveyor