


CONTAINS 4.000 ACRES

CONTAINS 4.000 ACRES

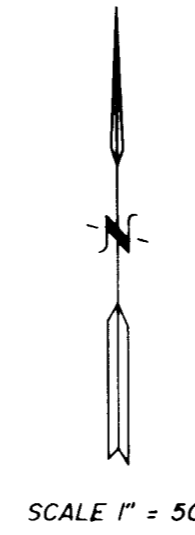

• SET REBAR AND CAP

A PART OF THE SOUTHWEST QUARTER OF SECTION 30, T7N, R1W, SLB&M, U.S. SURVEY, BEGINNING AT A POINT ON THE WEST LINE OF 1000 WEST STREET WHICH IS SOUTH 89°21'44\"


NARRATIVE

THIS SURVEY WAS DONE TO DIVIDE OFF A PARCEL FOR A CHAPLE SITE, THE TWO SECTION CORNERS SHOWN WERE LOCATED AND USED FOR SURVEY CONTROL AND BASIS OF BEARINGS.

I, GLENN RAVENBERG, DO HEREBY CERTIFY THAT I AM A REGISTERED LAND SURVEYOR, AND THAT I HOLD CERTIFICATE NO. 3835 AS PRESCRIBED BY THE LAWS OF THE STATE OF UTAH, AND I HAVE MADE A SURVEY OF THE ABOVE DESCRIBED PROPERTY. I FURTHER CERTIFY THAT THE ABOVE PLAT CORRECTLY SHOWS THE TRUE DIMENSIONS OF THE PROPERTY SURVEYED.

Glenn Ravenberg
GLENN RAVENBERG

MARCH 7, 1995

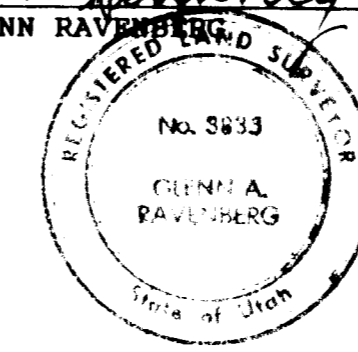

SO. 1/4 COR. OF SEC. 25, T7N, R2W, SLB&M FOUND MON.
2632.27'
N 89°34'13\"

SW COR. OF SEC. 30, T7N, R1W, SLB&M FOUND MON.

732.80'
S 89°21'44\"

SO. 1/4 COR. OF SEC. 30, T7N, R1W, SLB&M

2656.40'

REVISED JAN. 12, 1996

INTERMOUNTAIN SURVEYING
Layton, Utah 84041 (801) 544-1170

PROPERTY SURVEY FOR LDS CHURCH

PART OF THE S.W. 1/4 OF SEC. 30, T7N, R1W, SLB&M, U.S. SURVEY

MARCH 7, 1995 1" = 50' PS-95-05