

PROJECT NO.	2-27-B
DATE	03/17/20
DRAWN BY	Zachary Engelhardt
CHECKED BY	John P. Reeve

**REEVE & REEVE, INC.**  
 CIVIL AND ENVIRONMENTAL ENGINEERING  
 LAND PLANNING AND SITE DESIGN  
 LAND SURVEYING  


PROPERTY SURVEY FOR  
 TAYLOR T. KATD

SHEET 1 OF 3  
 JUL 18 2020  
 1933 001409

1. John P. Reeve, a registered professional land surveyor in the State of Utah, hereby certifies that the foregoing plat has been correctly drawn to the designated scale and is a true representation of the above legal descriptions, based upon data compiled from records at the County Recorder's office and of a survey made on the premises.

**DESCRIPTION**  


**SURVEYOR'S CERTIFICATE**  
 JOHN P. REEVE  
 Utah License No. 3492

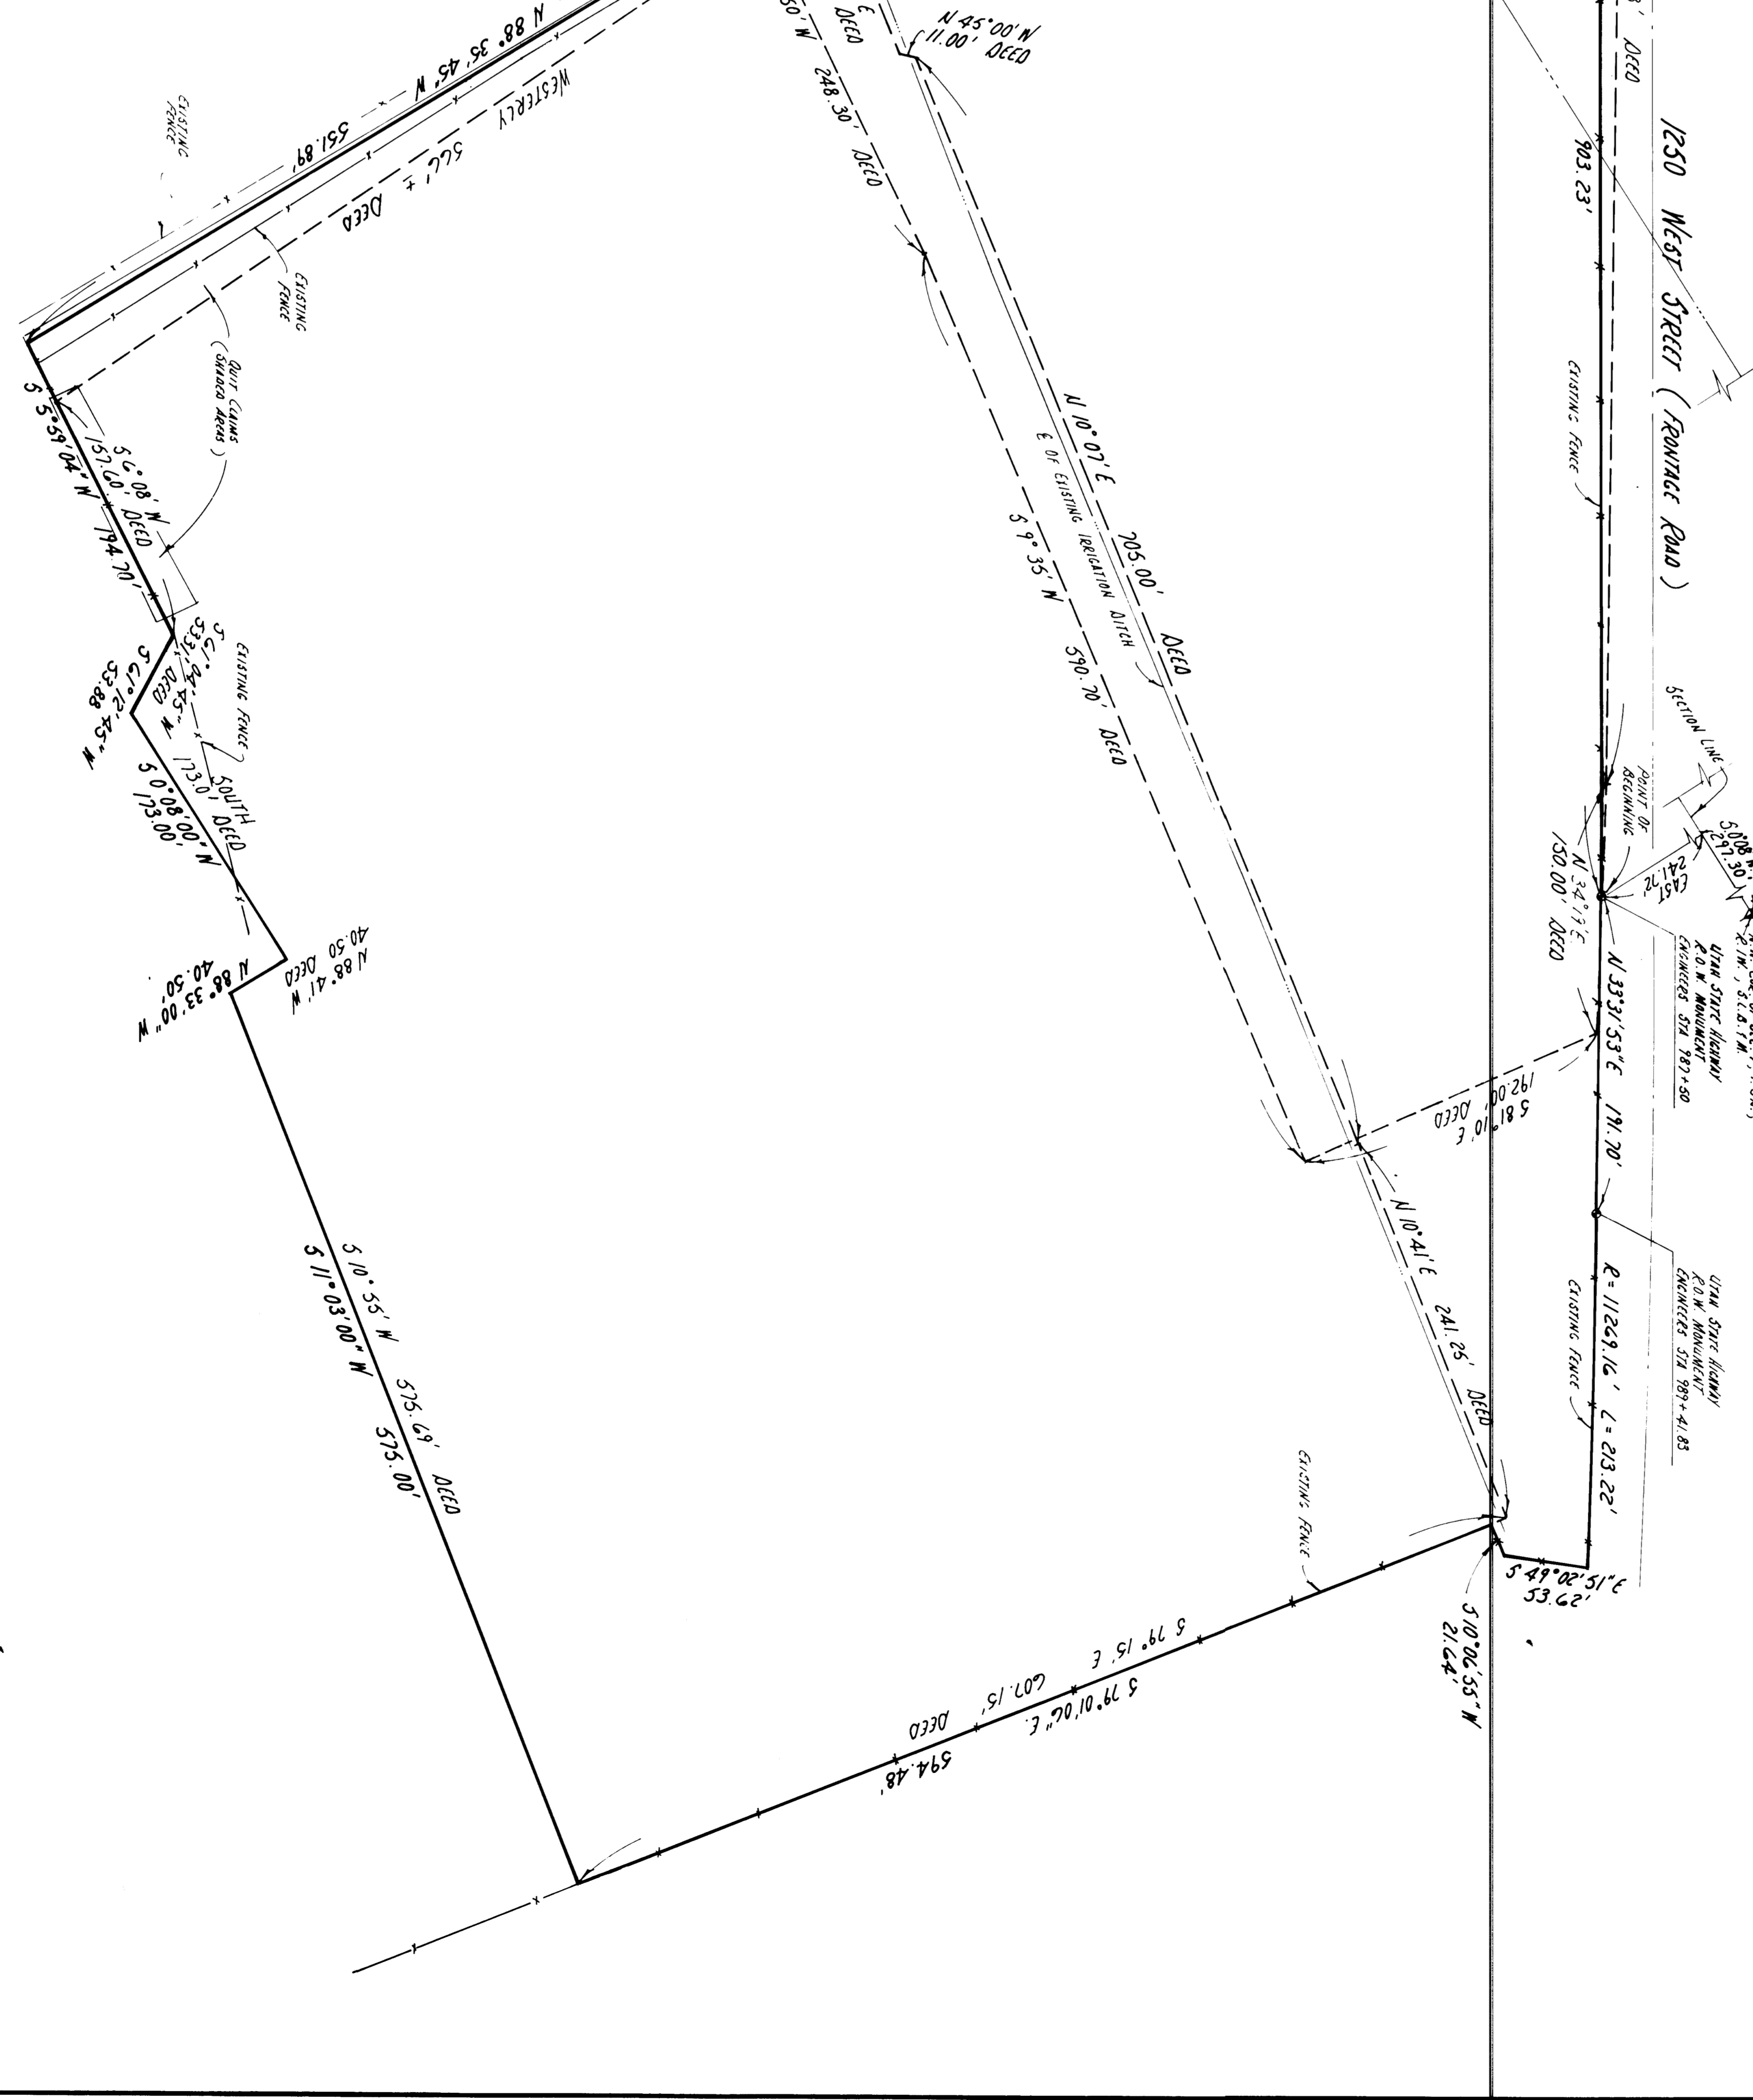

PLAT NO. 1933-001409  
 JUL 18 2020  
 1933 001409