



PROJECT NO.	DATE	STATUS	APPROVED
2		CONSTRUCTION	
3		AS-BUILT	
4		FINAL	

REEVE & REEVE, INC.
CIVIL AND ENVIRONMENTAL ENGINEERING
LAND PLANNING AND SITE DESIGN
LAND SURVEYING
CODEN, UTAH


RECORD OF SURVEY

WEBER COUNTY SCHOOL DISTRICT
PLEASANT VIEW, WEBER COUNTY, UTAH

- *LEGEND***
- EXISTING FENCE LINE
 - ▨ OVERLAP IN DEEDS
 - GAP IN DEEDS
 - ▤ EXISTING PARCELS
 - SET 5/8" REBAR & CAP
 - ◇ MARKED REVEE & REVEE
 - ◆ SECTION CORNER

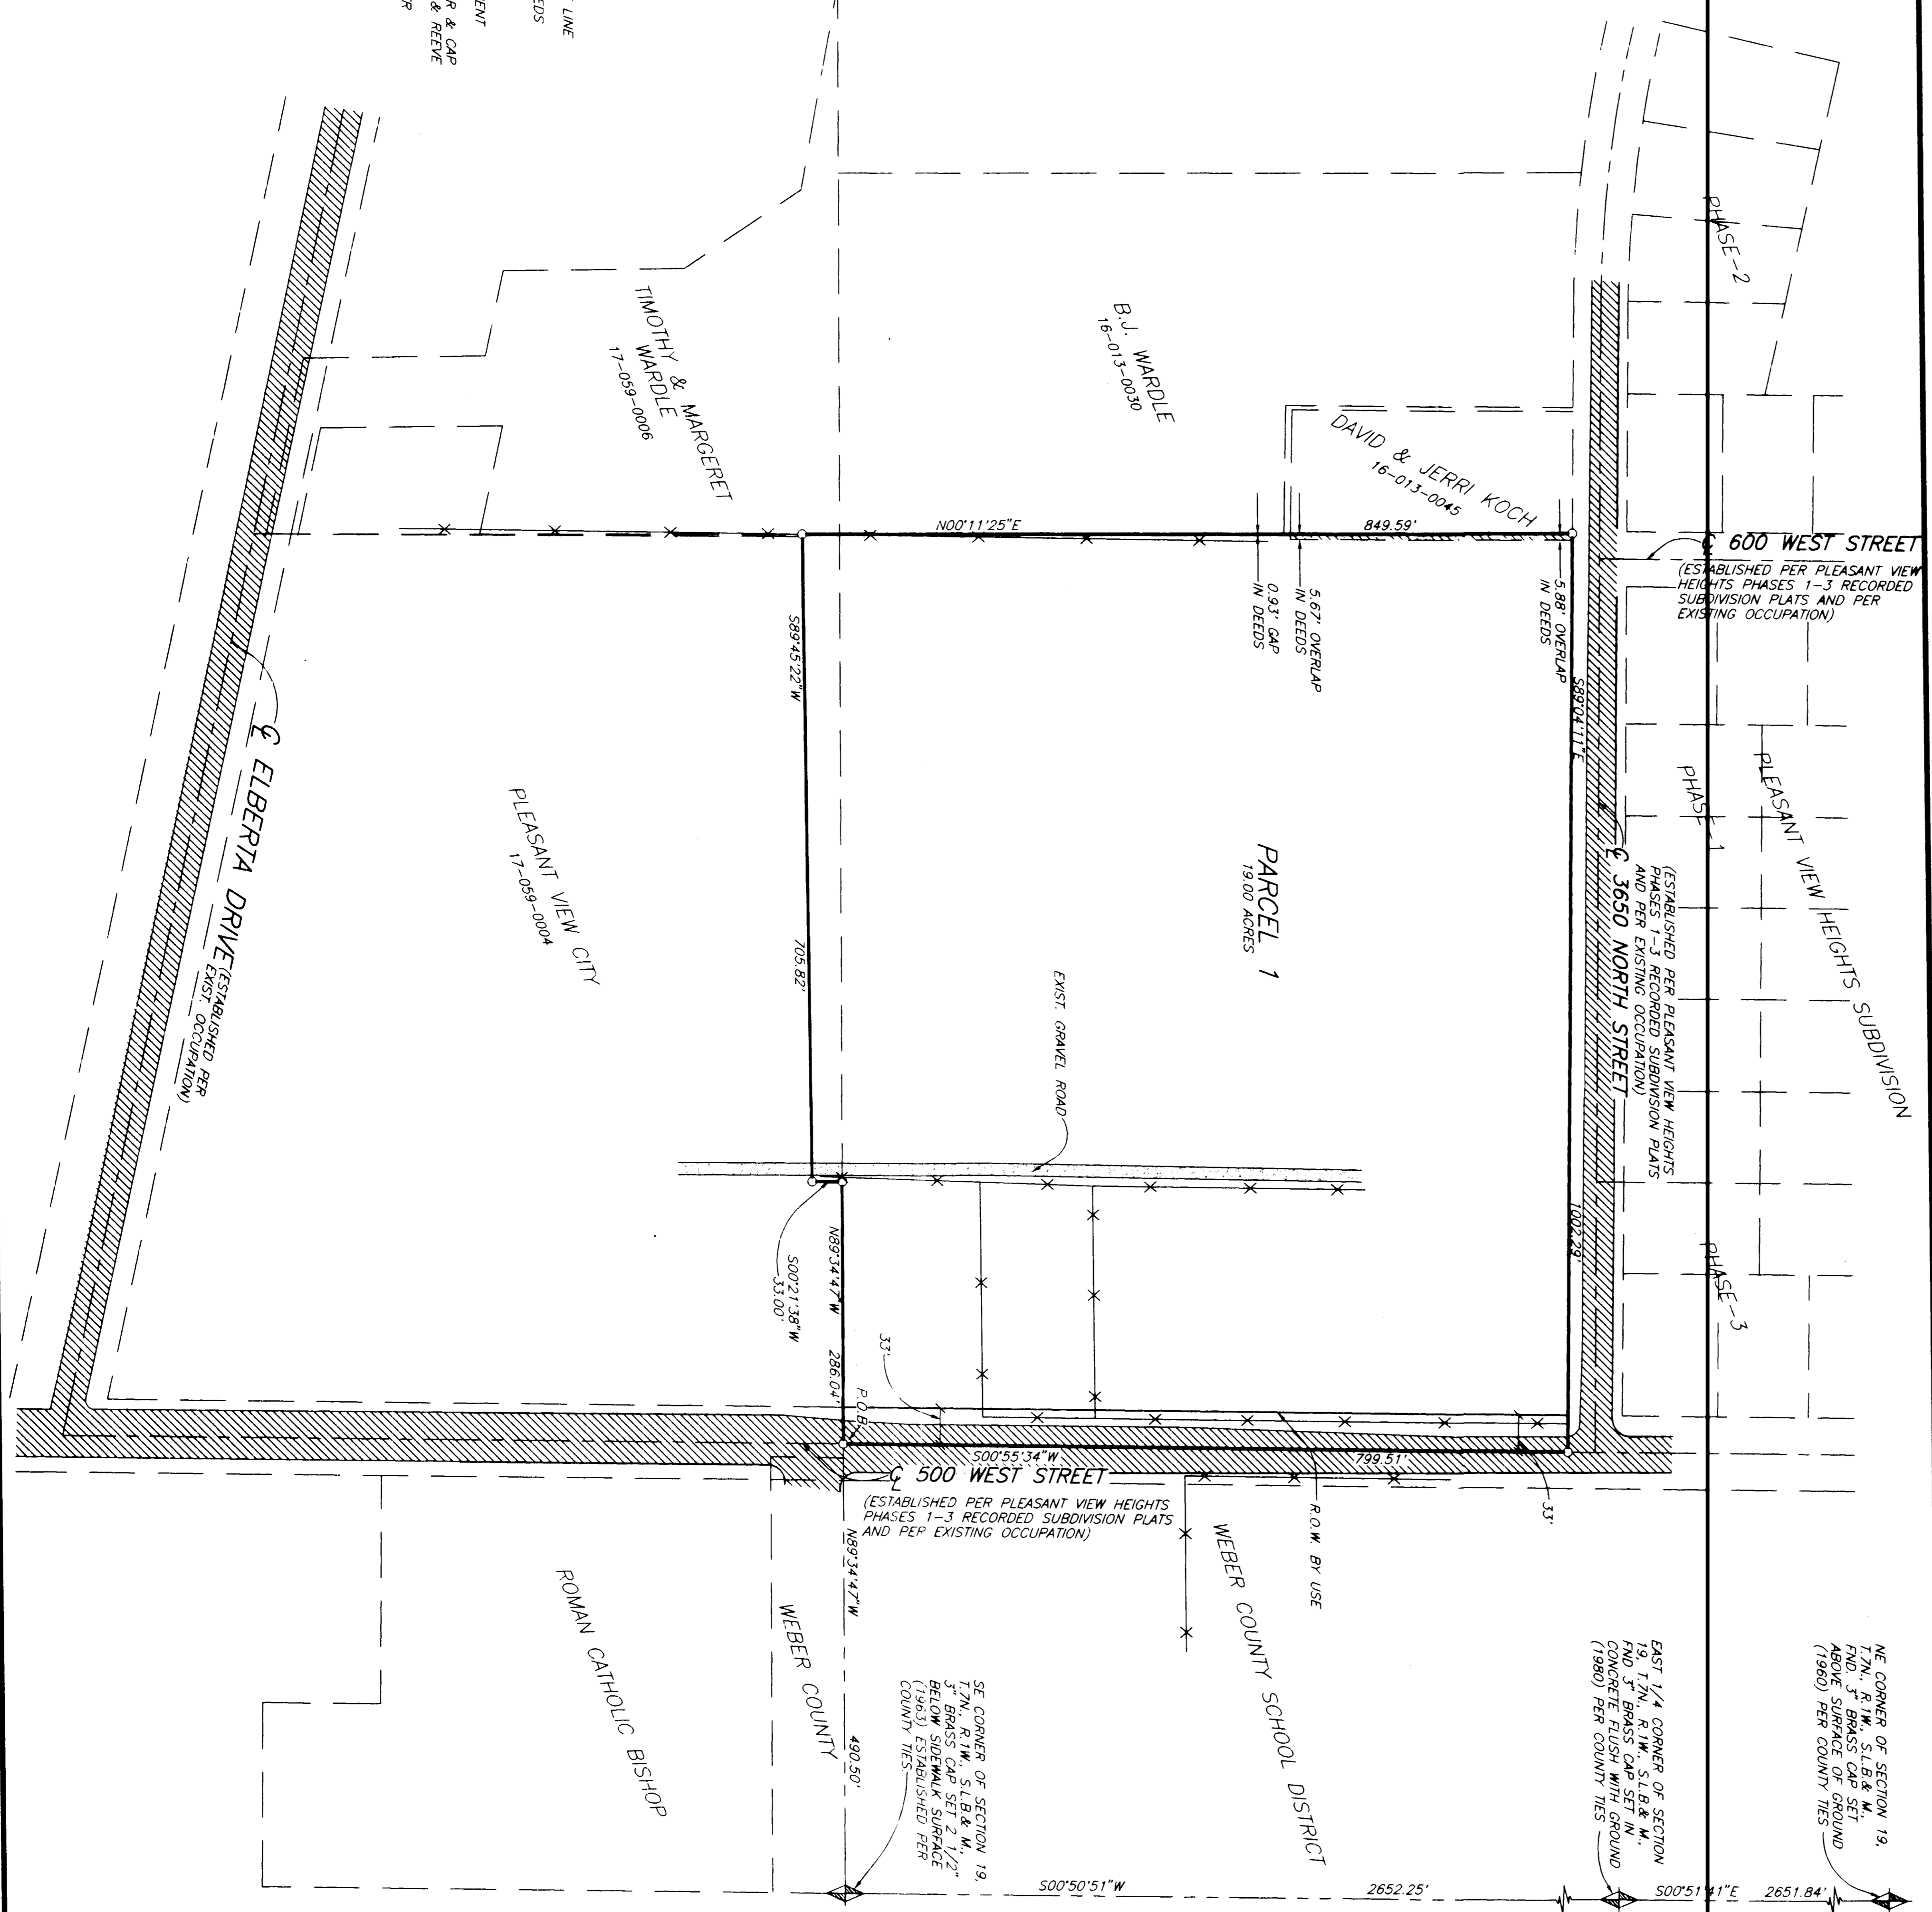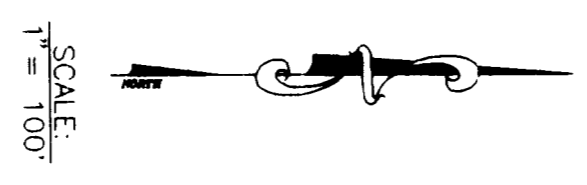

RECORD OF SURVEY

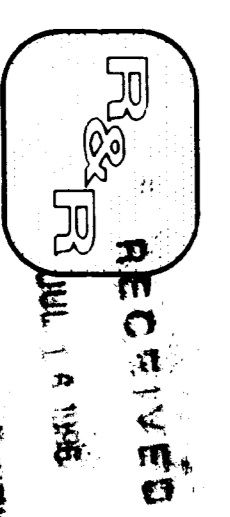

REEVE & REEVE, INC.
CIVIL AND ENVIRONMENTAL ENGINEERING
LAND PLANNING AND SITE DESIGN
LAND SURVEYING
CODEN, UTAH

NARRATIVE


BASIS OF BEARINGS


BOUNDARY DESCRIPTION

ALL THAT LAND THE TOWN OF PLEASANT VIEW, WEBER COUNTY, UTAH, BEING PART OF THE SE 1/4 OF SECTION 19 AND THE NE 1/4 OF SECTION 20, T2N, R1W, S1B&M, U.S. SURVEY, DESCRIBED AS FOLLOWS:




CONTAINS 19.00 ACRES, MORE OR LESS.

SURVEYOR'S CERTIFICATE

I, JOHN P. REEVE, UTAH REGISTERED LAND SURVEYOR NO. 22-14666-2201, DO HEREBY CERTIFY THAT THIS PLAN WAS PREPARED IN ACCORDANCE WITH THE REQUIREMENTS OF THE UTAH SURVEYING ACT AND IS TRUE AND CORRECT TO THE BEST OF MY KNOWLEDGE AND BELIEF.


UTAH LICENSE NUMBER: 22-14666-2201
SIGNATURE: JOHN P. REEVE

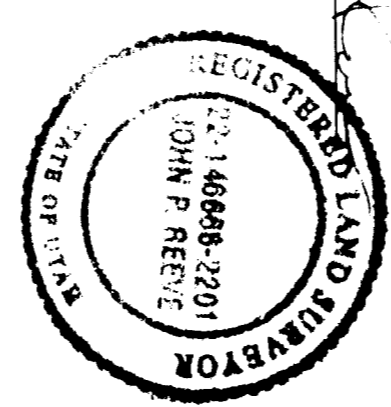


