

PROJECT NO.: 140312
 DATE: MARCH 13, 1998
 SCALE: 1" = 40'


DESIGNED BY: J. BERRY
 CHECKED BY: C. GALE

REEVE & REEVE ENGINEERING, INC.
 ENGINEERS, PLANNERS & SURVEYORS
 3670 QUINCY AVE. SUITE NO. 1
 OGDEN, UTAH 84403
 (801) 621-3100 FAX (801) 621-2666

RECORD OF SURVEY

WEBER COUNTY SCHOOLS
 WEST HAVEN CITY

SHEET
1
001415
SHEETS

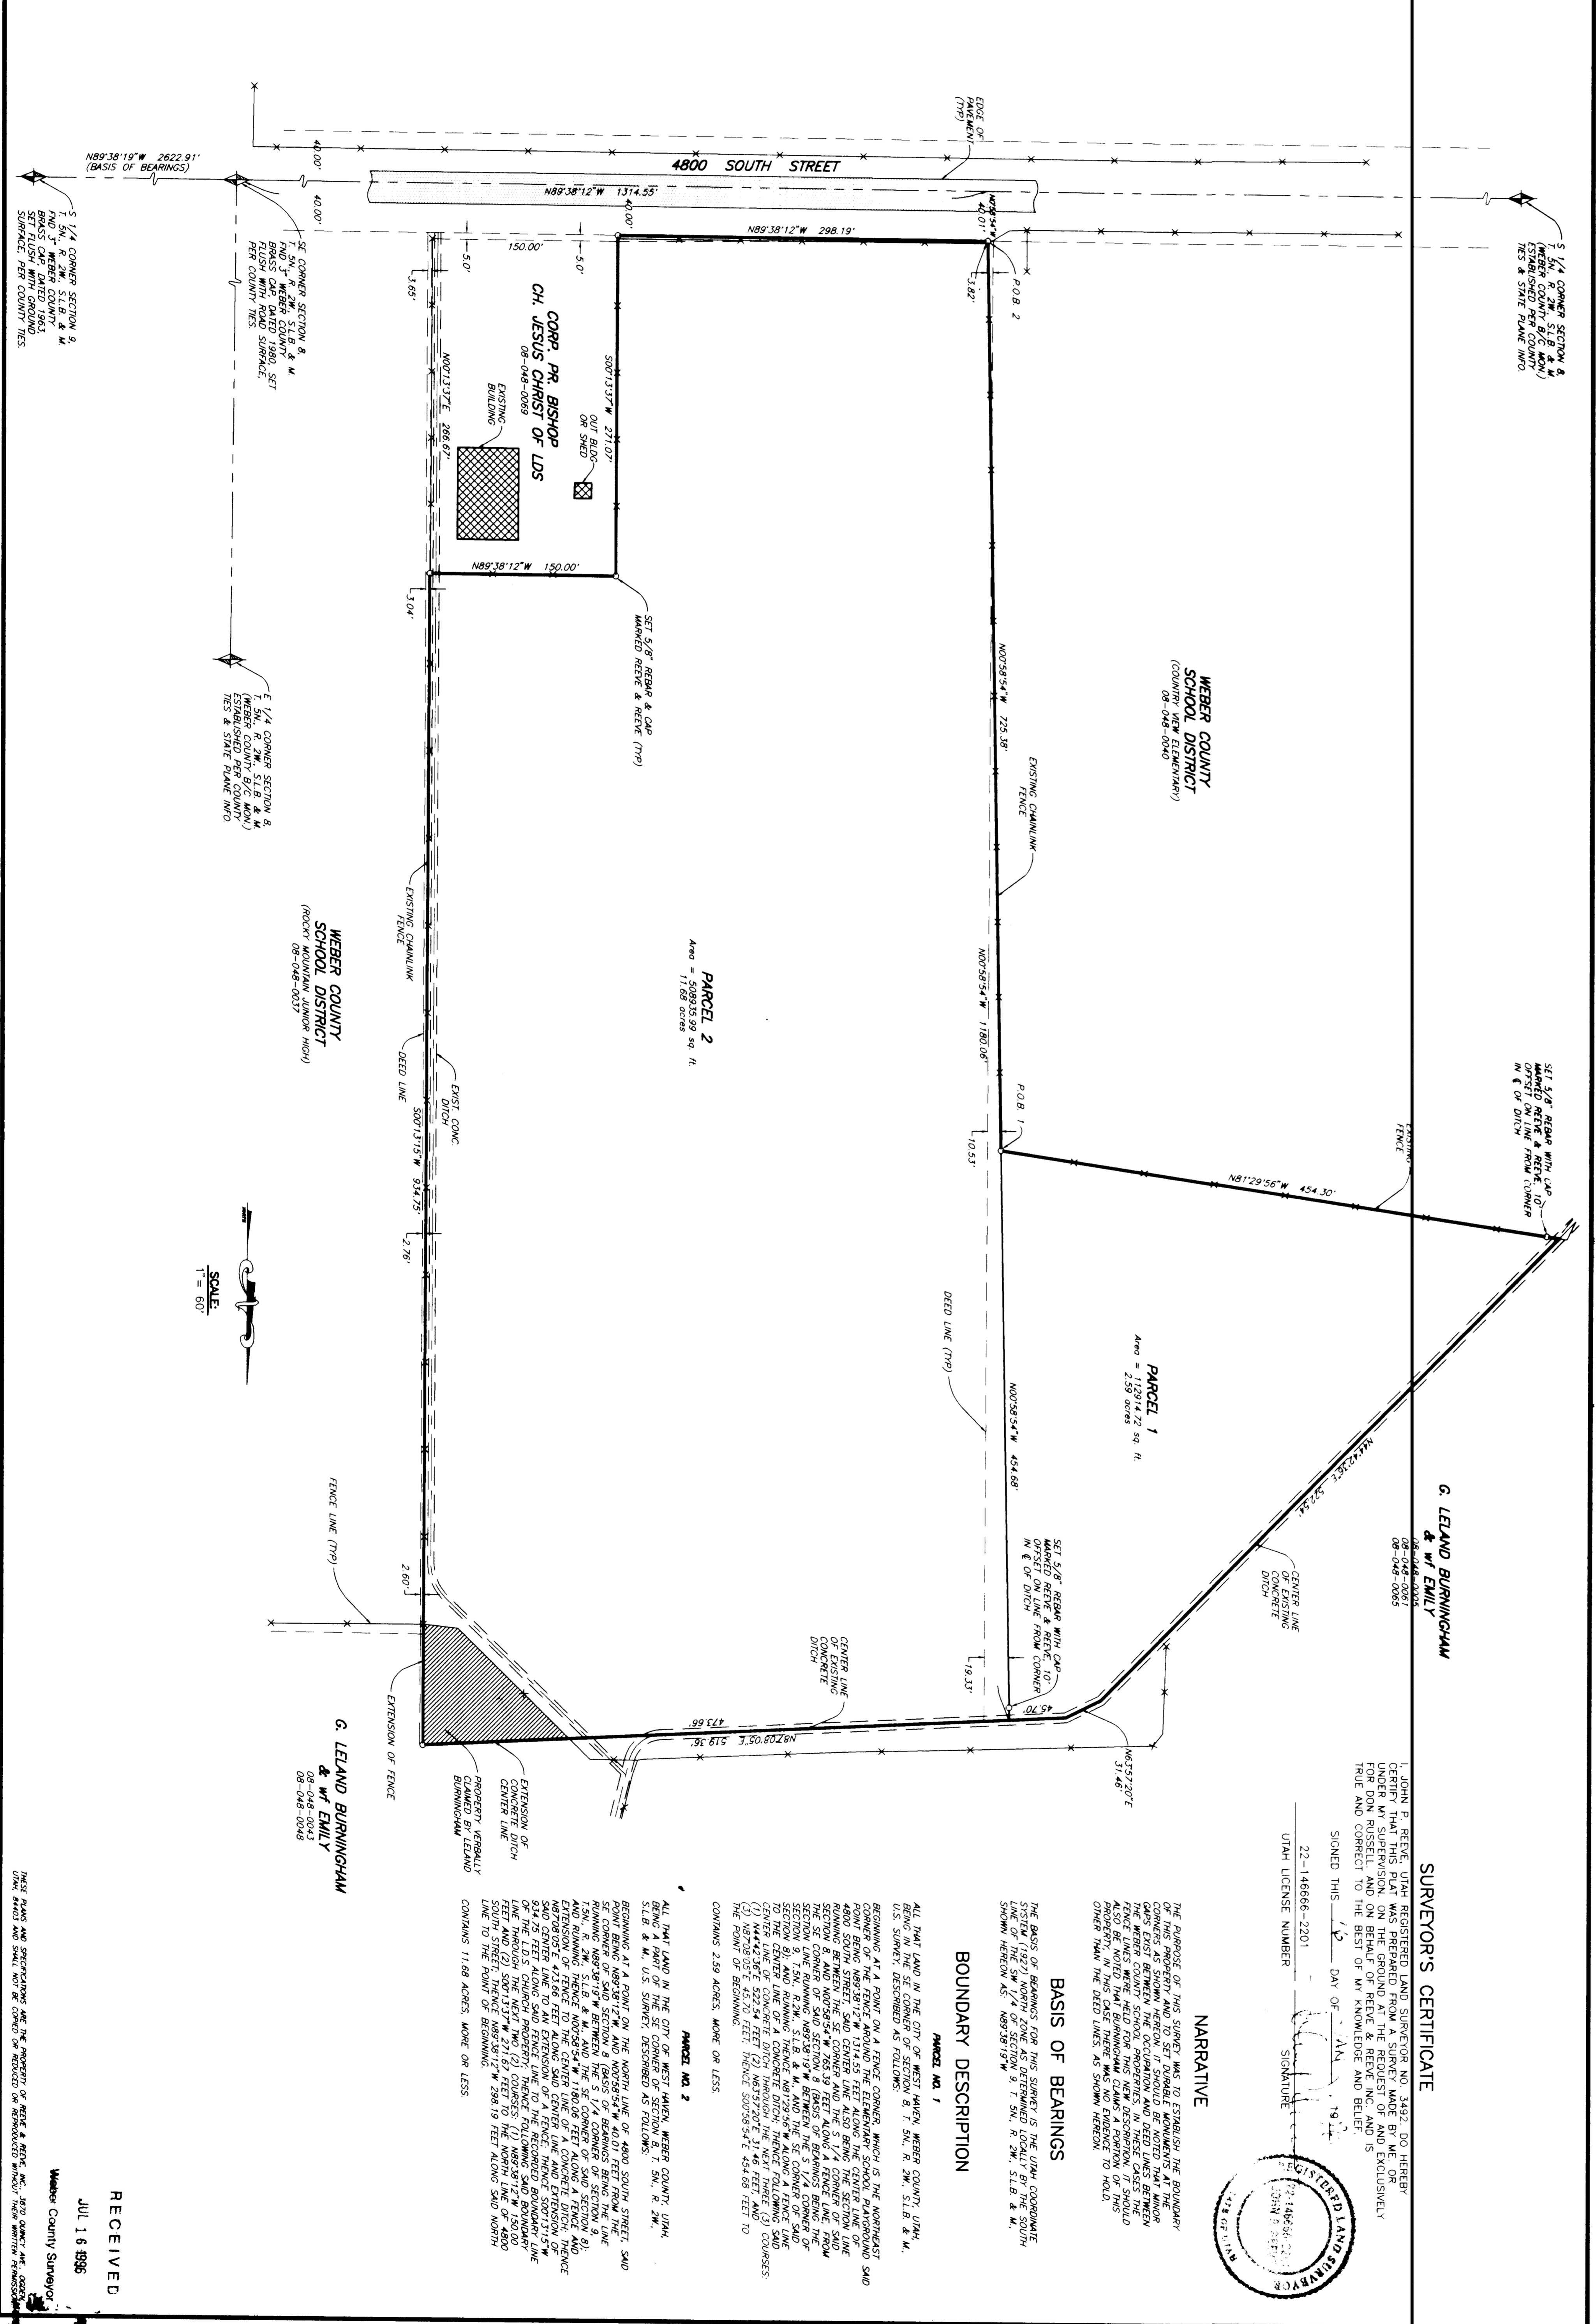

NARRATIVE



BASIS OF BEARINGS


BOUNDARY DESCRIPTION

PARCEL NO. 1



PARCEL NO. 2



SURVEYOR'S CERTIFICATE


SIGNED THIS 12th DAY OF MARCH, 1998.

22-14668-2201
 UTAH LICENSE NUMBER


RECEIVED
 Weber County Surveyors