

|   |      |         |
|---|------|---------|
| 1 | DATE | 2/21/98 |
| 2 | BY   | J.P.    |
| 3 | DATE |         |
| 4 | BY   |         |


|             |          |
|-------------|----------|
| PROJECT NO. | 218      |
| DATE        | 2-21-98  |
| SCALE       | 1" = 40' |
| APPROVED    |          |

REEVE & REEVE, INC  
CIVIL AND ENVIRONMENTAL ENGINEERING  
LAND PLANNING AND SITE DESIGN  
LAND SURVEYING  
OGDEN, UTAH


RECORD OF SURVEY

ARNOLD GAUNT, LOT #18  
CENTURY VILLAGE SUBDIVISION

|              |   |
|--------------|---|
| SHEET        | 1 |
| TOTAL SHEETS | 1 |

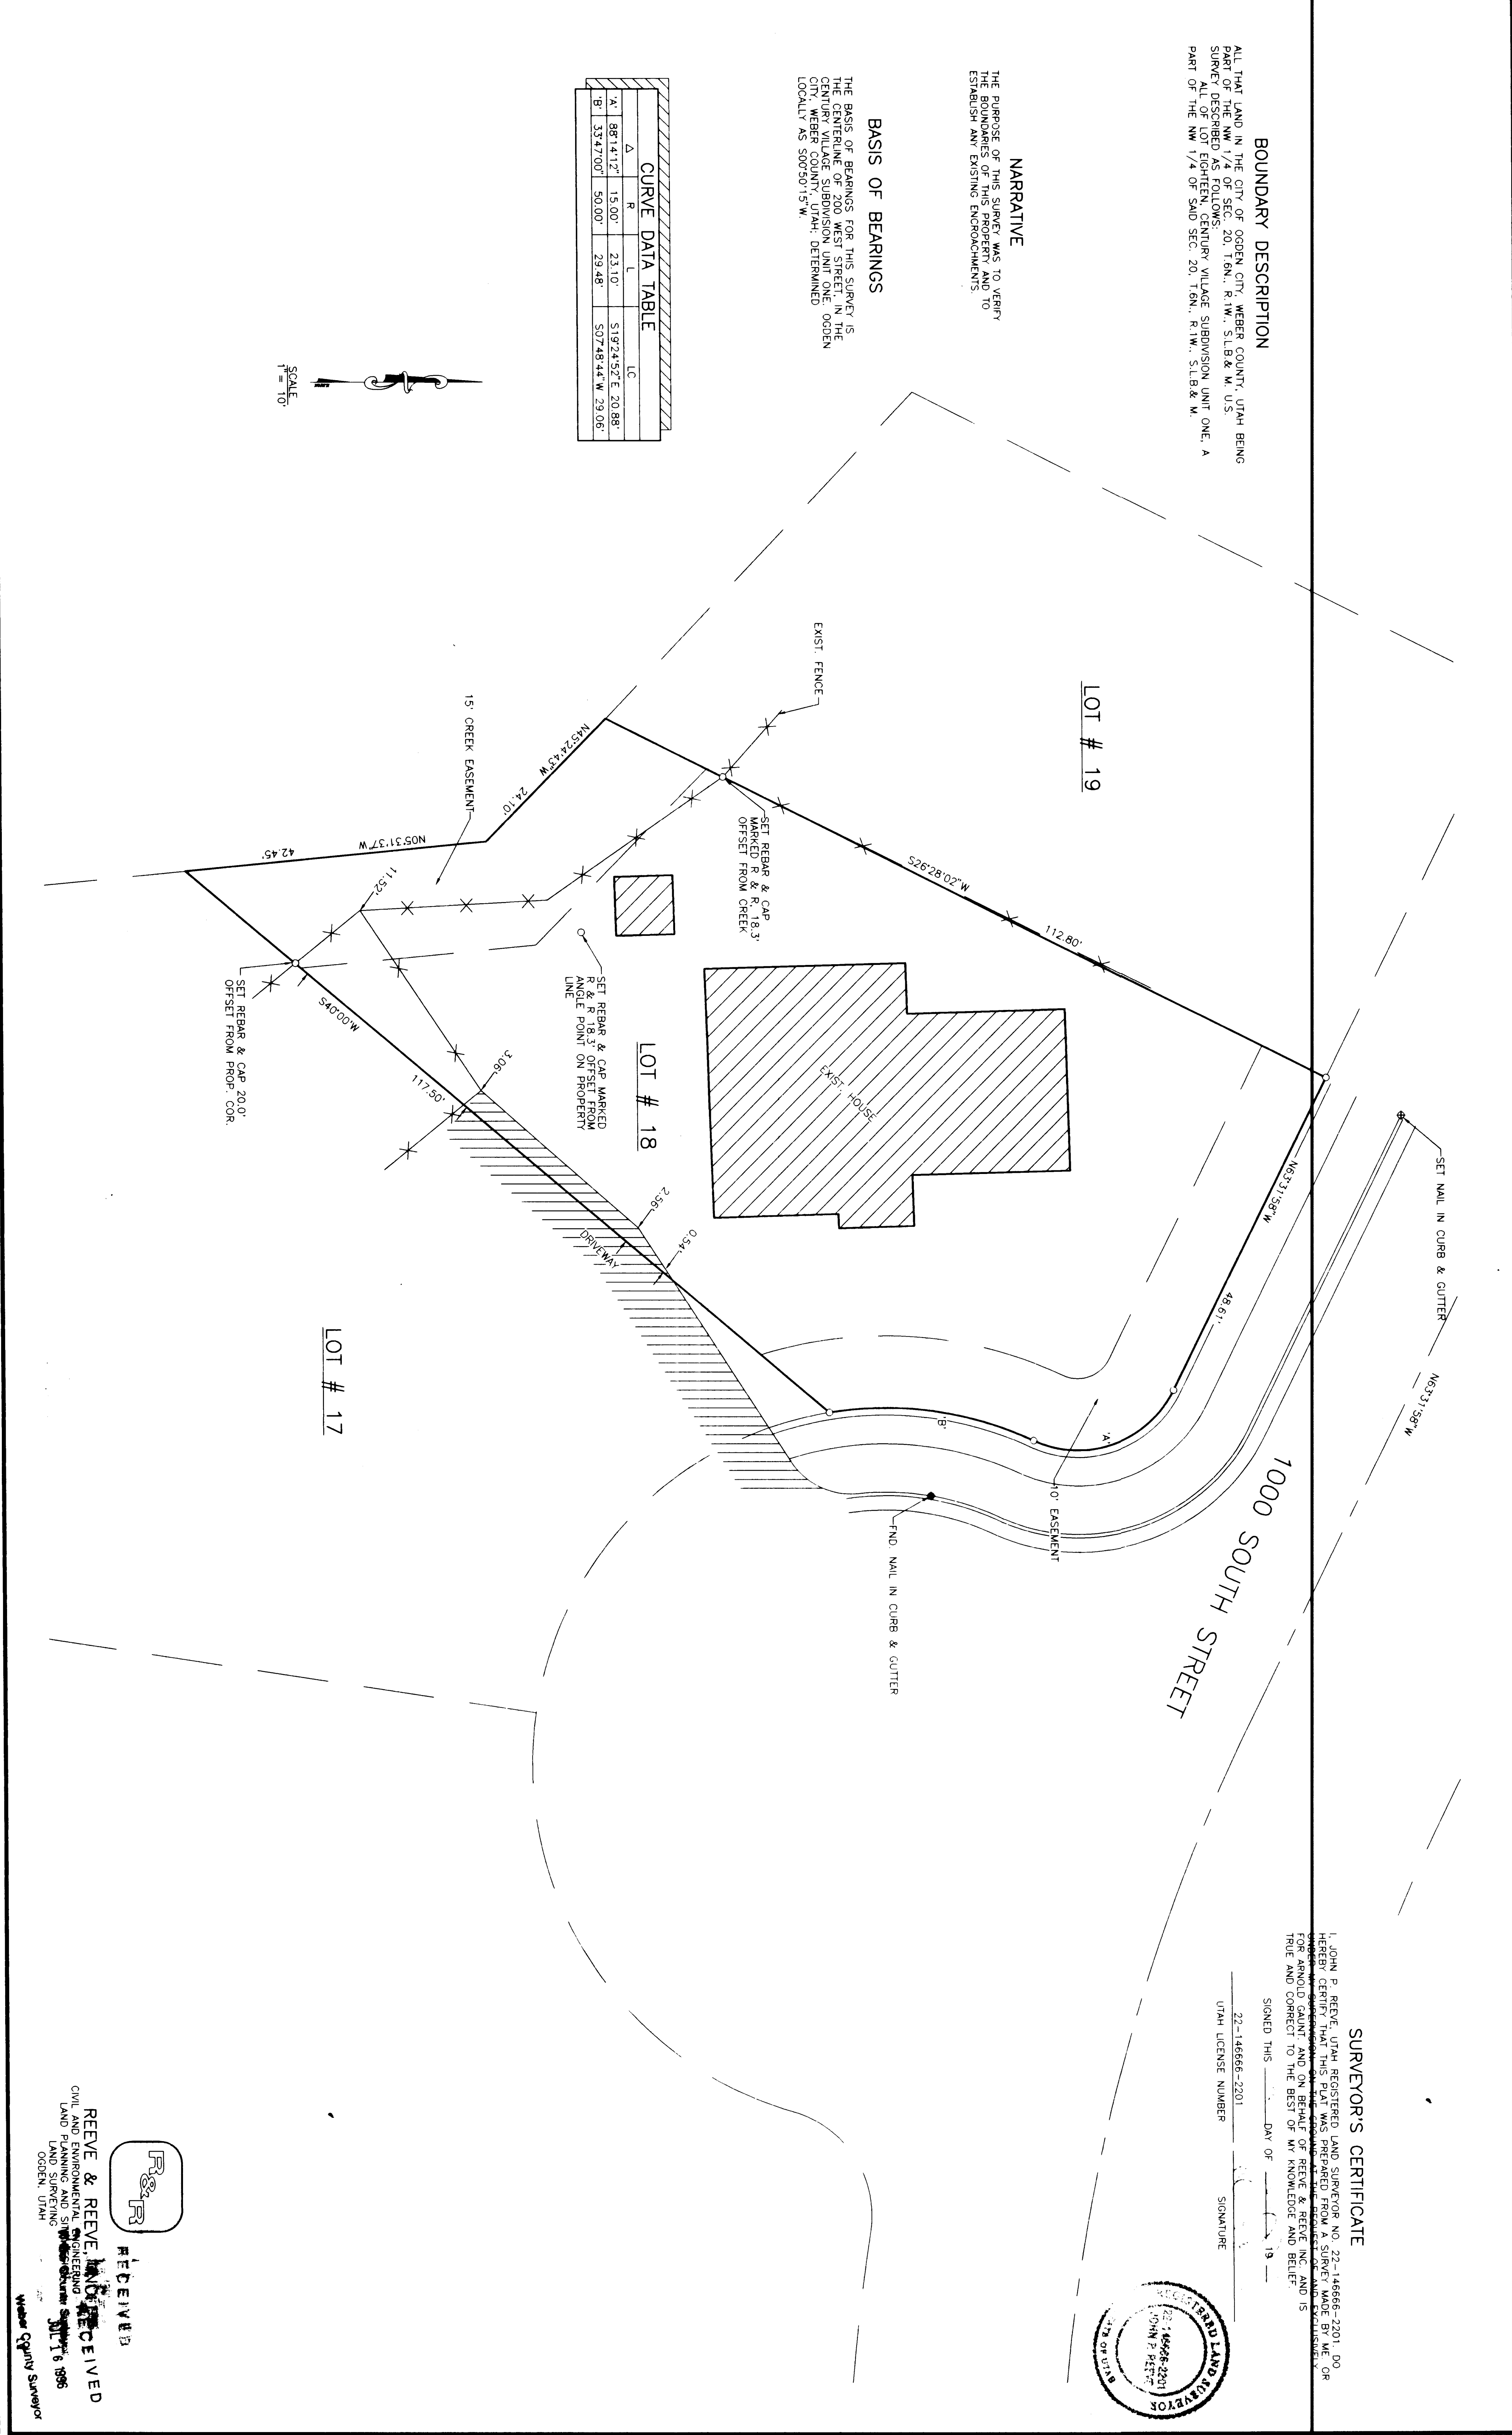

| Δ | R         | L      | LC                 |
|---|-----------|--------|--------------------|

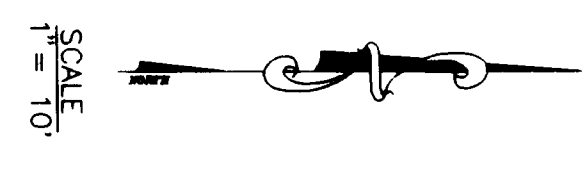

**NARRATIVE**  
THE PURPOSE OF THIS SURVEY WAS TO VERIFY THE BOUNDARIES OF THIS PROPERTY AND TO ESTABLISH ANY EXISTING ENCROACHMENTS.

**BASIS OF BEARINGS**  


**SURVEYOR'S CERTIFICATE**  
SIGNED THIS \_\_\_\_\_ DAY OF \_\_\_\_\_ 19\_\_  
22-14666-2201 UTAH LICENSE NUMBER  
SIGNATURE



REEVE & REEVE, INC  
CIVIL AND ENVIRONMENTAL ENGINEERING  
LAND PLANNING AND SITE DESIGN  
LAND SURVEYING  
OGDEN, UTAH  
