


CURVE DATA

(a) Δ = 151°23'00"
L = 63.00'
LC = 62.88'
N 31°31'01"E
(b) Δ = 1°06'41"
L = 4.6178'
LC = 4.6178'
N 23°22'20"E
(c) Δ = 85°11'02"
L = 24.0'
LC = 23.84'

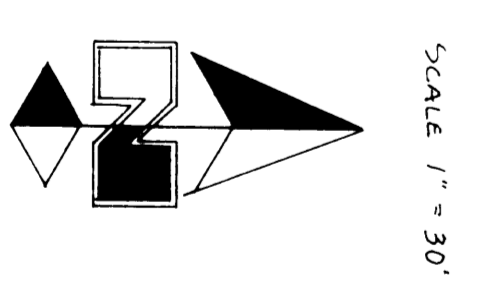


LEGEND
• Debris - Set Back Cap

NARRATIVE
This survey was requested by J. K. Smith in order to set the boundaries of the above described lots. No survey control was found within the subdivision, but by using a number of fences and curb splits, the control was reconstructed. A line bearing North 0°06' East along the center line of 325 West Street was used as a basis of bearings. Also, the Northwest corner of Section 29 (Brass cap) and the West Quarter corner of Section 20 (brass cap) were found and tied into as depicted on drawing.

Description
All of lots 8-12 Weber View Subdivision, Pleasant View City, Weber County, Utah, according to the official plat thereof.

I, Gary L. Noman, do hereby certify that I am a Registered Land Surveyor, and that I hold Certificate No. 4728, as prescribed by the Laws of the State of Utah, and I have made a survey of the above described property. I further certify that the above plat correctly shows the true dimensions of the property surveyed.

Date: 7-20-88
Gary L. Noman

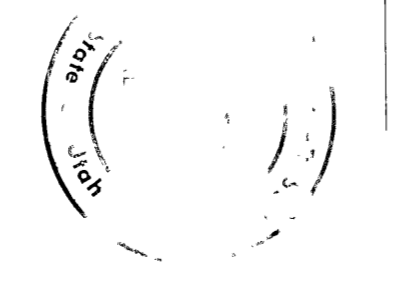

RECEIVED
JUN 11 1988
Weber County Surveyor

GREAT BASIN ENGINEERING, INC.
A Division of


PROPERTY SURVEY

LOTS 8-12 WEBER VIEW SUBDIVISION
PLEASANT VIEW WEBER COUNTY, UTAH
PART OF S 29 T 33 N R 10 E S 20