

DRAWING NUMBER

001449

PLAN HOLD CORPORATION • IRVINE, CALIFORNIA

REORDER BY NUMBER 07548

DRAWING NUMBER

001449

PLAN HOLD CORPORATION • IRVINE, CALIFORNIA

REORDER BY NUMBER 07548

DRAWING NUMBER

001449

PLAN HOLD CORPORATION • IRVINE, CALIFORNIA

REORDER BY NUMBER 07548


DRAWING NUMBER

001449

PLAN HOLD CORPORATION • IRVINE, CALIFORNIA

REORDER BY NUMBER 07548



MOUNT EYRIE PARK LEASE SITE
CASCADE NO. 108D

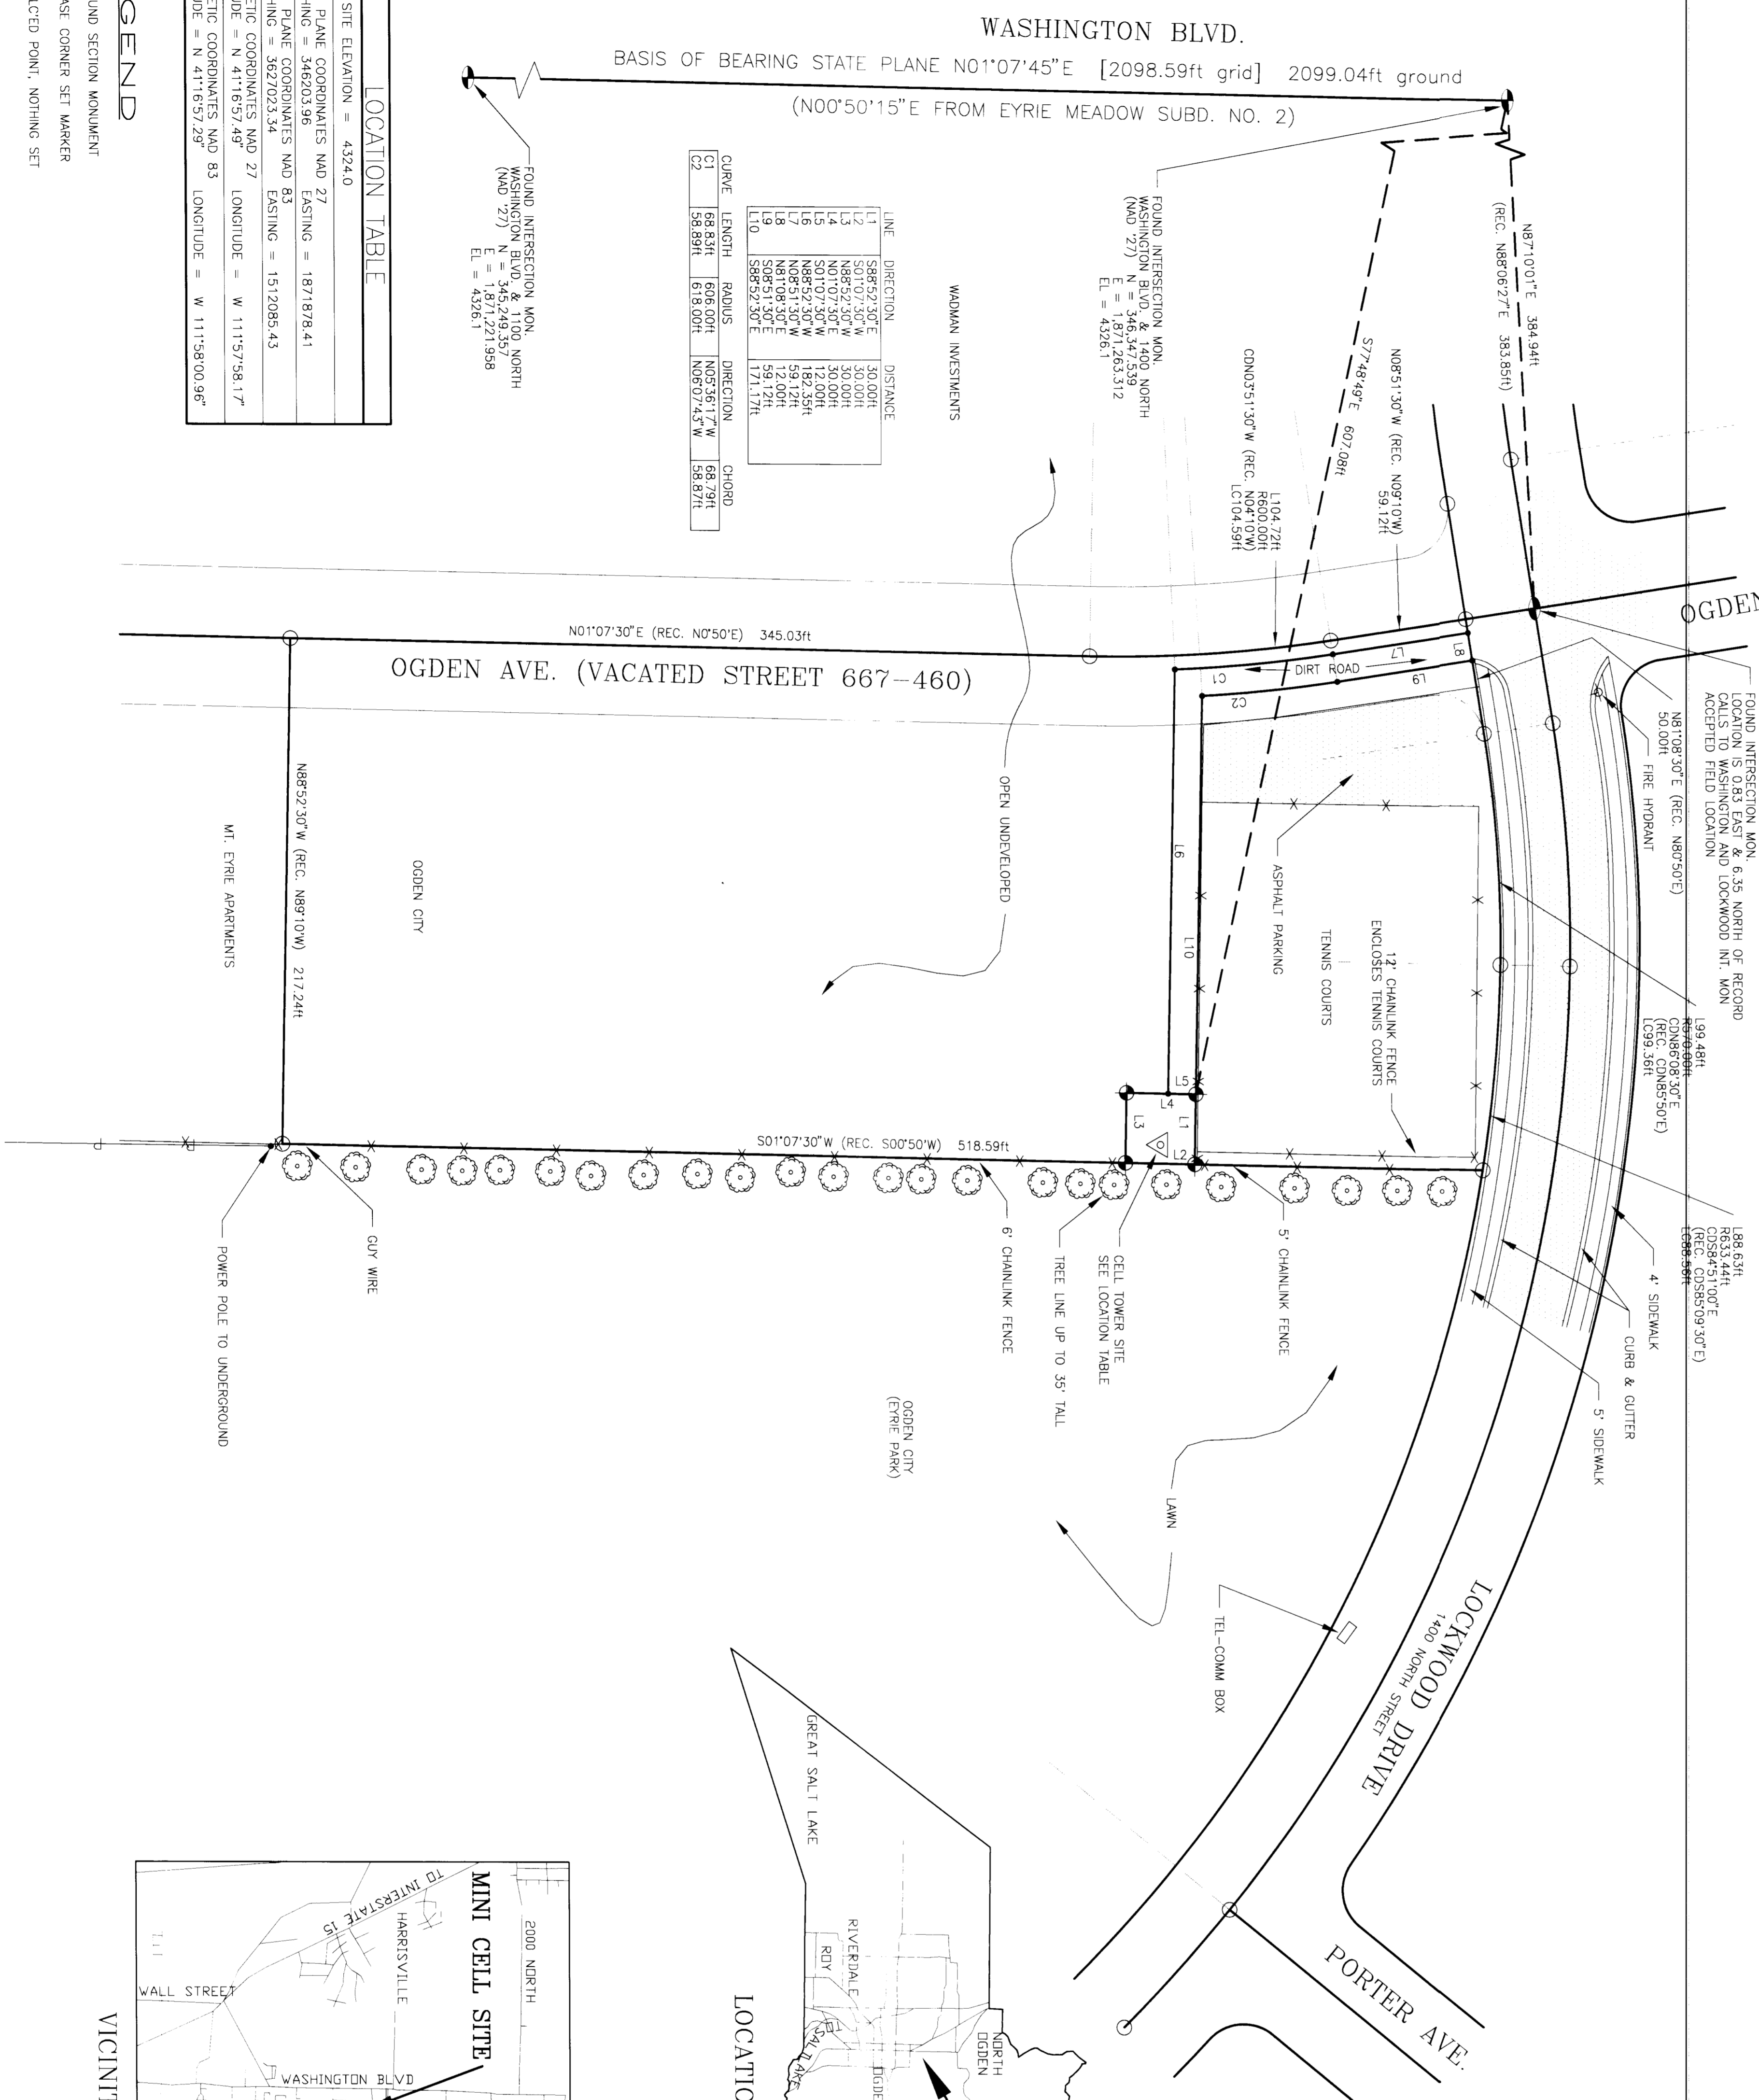

LOCATION TABLE with columns for CELL SITE ELEVATION, STATE PLANE COORDINATES, NORTHING, EASTING, etc.

WADSWORTH INVESTMENTS table with columns for LINE, DIRECTION, DISTANCE.

- LEGEND: FOUND SECTION MONUMENT, LEAST CORNER SET MARKER, CALC'D POINT, NOTHING SET

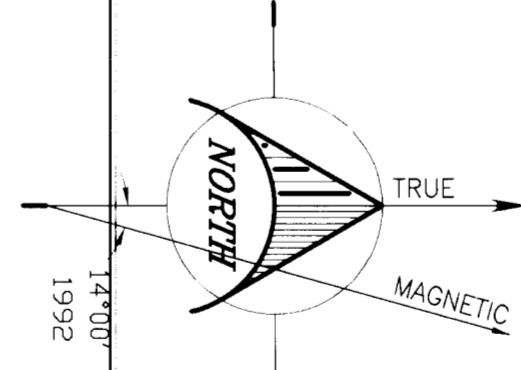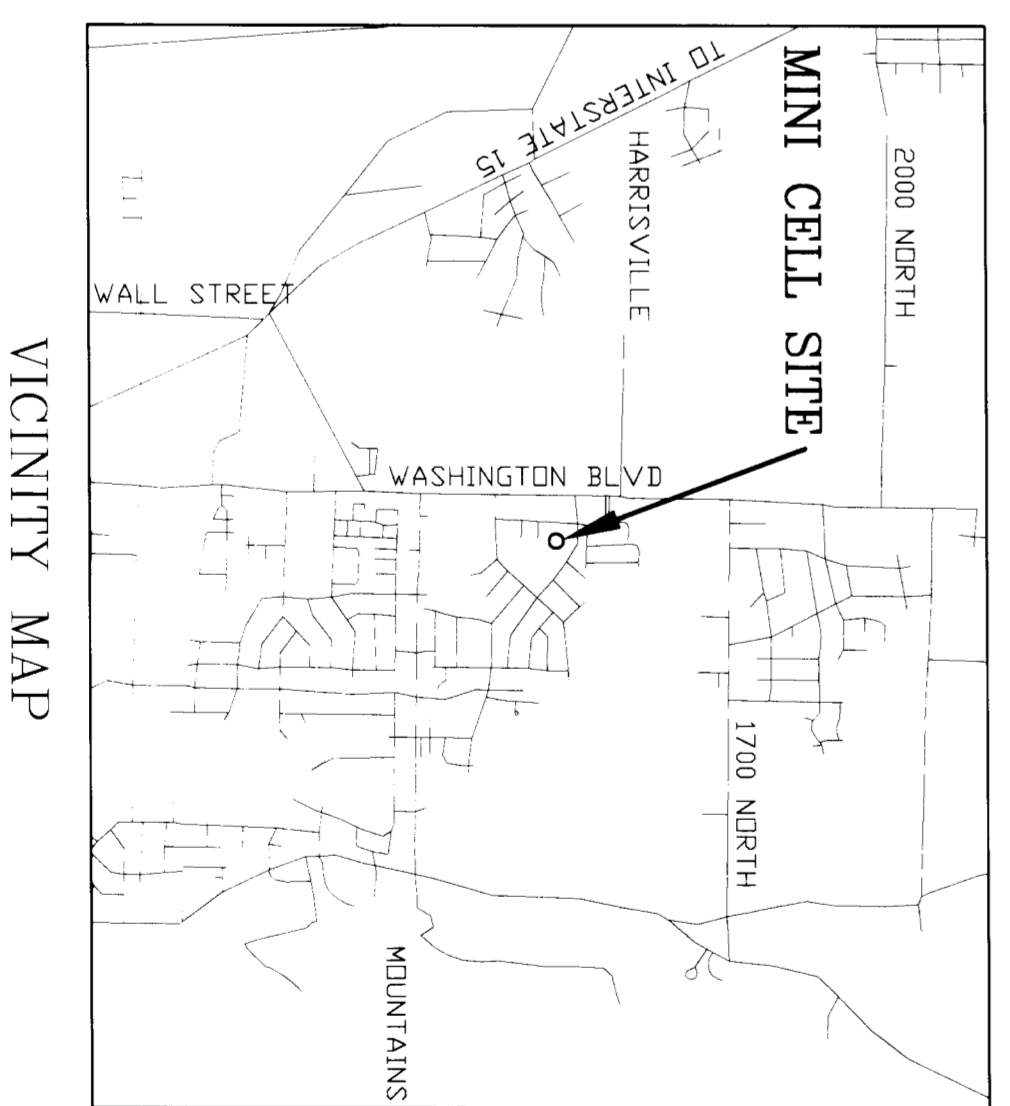

SCALE: 1"=40'

RECORD OF SURVEY

SURVEYOR'S CERTIFICATE: I, DALE J. ROBINSON, DO HEREBY CERTIFY THAT I AM A REGISTERED LAND SURVEYOR AND UNDER HOLD LICENSE...

BASIS OF BEARING: THE BASIS OF BEARING FOR THIS SURVEY IS SOUTH 01 DEGREES 07 MINUTES 45 SECONDS EAST BETWEEN INTERSECTION MONUMENTS AT WASHINGTON BOULEVARD & 1100 NORTH...

ORIGINAL DESCRIPTION: TAX DESCRIPTION: (11-013-0003) BEGINS AT A POINT SOUTH 89°45' WEST 92.80 FEET AND NORTH...

CELL SITE DESCRIPTION: Part of Block 16, Eyrie Meadow Subdivision No. 2, in Ogden City, Weber County, Utah, described as follows: Washington Boulevard...

ACCESS DEPENDENT DESCRIPTION: Part of Block 16, Eyrie Meadow Subdivision No. 2, in Ogden City, Weber County, Utah, described as follows: Washington Boulevard...

- NOTES: 1- ALL FCC AND FAA REGULATIONS / REQUIREMENTS WILL BE ADHERED TO BY THIS PROJECT. 2- ADA COMPLIANCE: FACILITY IS UNMANAGED AND NOT FOR HUMAN TRAFFIC. 3- NO TITLE REPORT WAS PROVIDED FOR THIS SURVEY. 4- THIS SURVEY WAS PREPARED BASED ON OGDEN CITY MONUMENTS (AND 271 DRAIN) AND THE EYRIE MEADOW SUBD. NO. 2.

SUNRISE ENGINEERING, INC. CONSULTING ENGINEERS & LAND SURVEYORS 12227 SOUTH BUSINESS PARK DRIVE, SUITE 280



SPRINT SPECTRUM - CAPITAL LAND SERVICES OGDEN AVE. & LOCKWOOD DR., OGDEN, UTAH

RECEIVED 11-3-09 59019 SWM/DBH

901449