

**Narrative:**  
This Survey was done for the Dry Bread Posted Hunting Unit. It was needed because a P.H.U. hunter (Bob Stanworth) of shooting a Bull Elk outside of the P.H.U. boundary.


**Certification**  
I, Joy R. Anderson, a Registered Land Surveyor in the State of Utah, do hereby certify that this plat of the West half of Section 2, 77N, R3E has been correctly drawn to the designated scale and is a true and correct representation of the location the Eik was shot.

Signed this 31<sup>st</sup> day of **October**, 1996.

License No. 2430



Joy R. Anderson

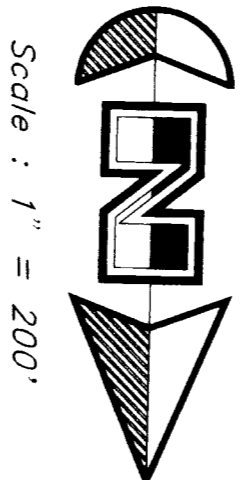

**Note:**  
This Survey based on a Dependent Resurvey of Township 7 North, Range 3 East, dated from April 21, 1939 through August 22, 1944.

Section 3

<b>Partial Survey of the West Half Section 2, 77N, R3E</b>		<b>Eik Shot in P.H.U.</b>	
GREAT BASIN ENGINEERING, INC. 3540 Redwood Avenue, Ogden, Utah, 84403 Phone: (801) 231-4111 Fax: (801) 231-3444		The West 1/2 of Section 2, 77N, R3E, Weber County, Utah	
Scale: 1" = 200'	DATE: 31 Oct, 1996	RECEIVED	
DRAWN: bjb	REVISIONS:	NOV 01 1996	
SECT 2A		Weber County Surveyor	
		001459	