

1. BASMT NOTE



4. PER COUNTY TIES

5. PER COUNTY TIES

RECEIVED
NOV 13 1988
Weber County Surveyor

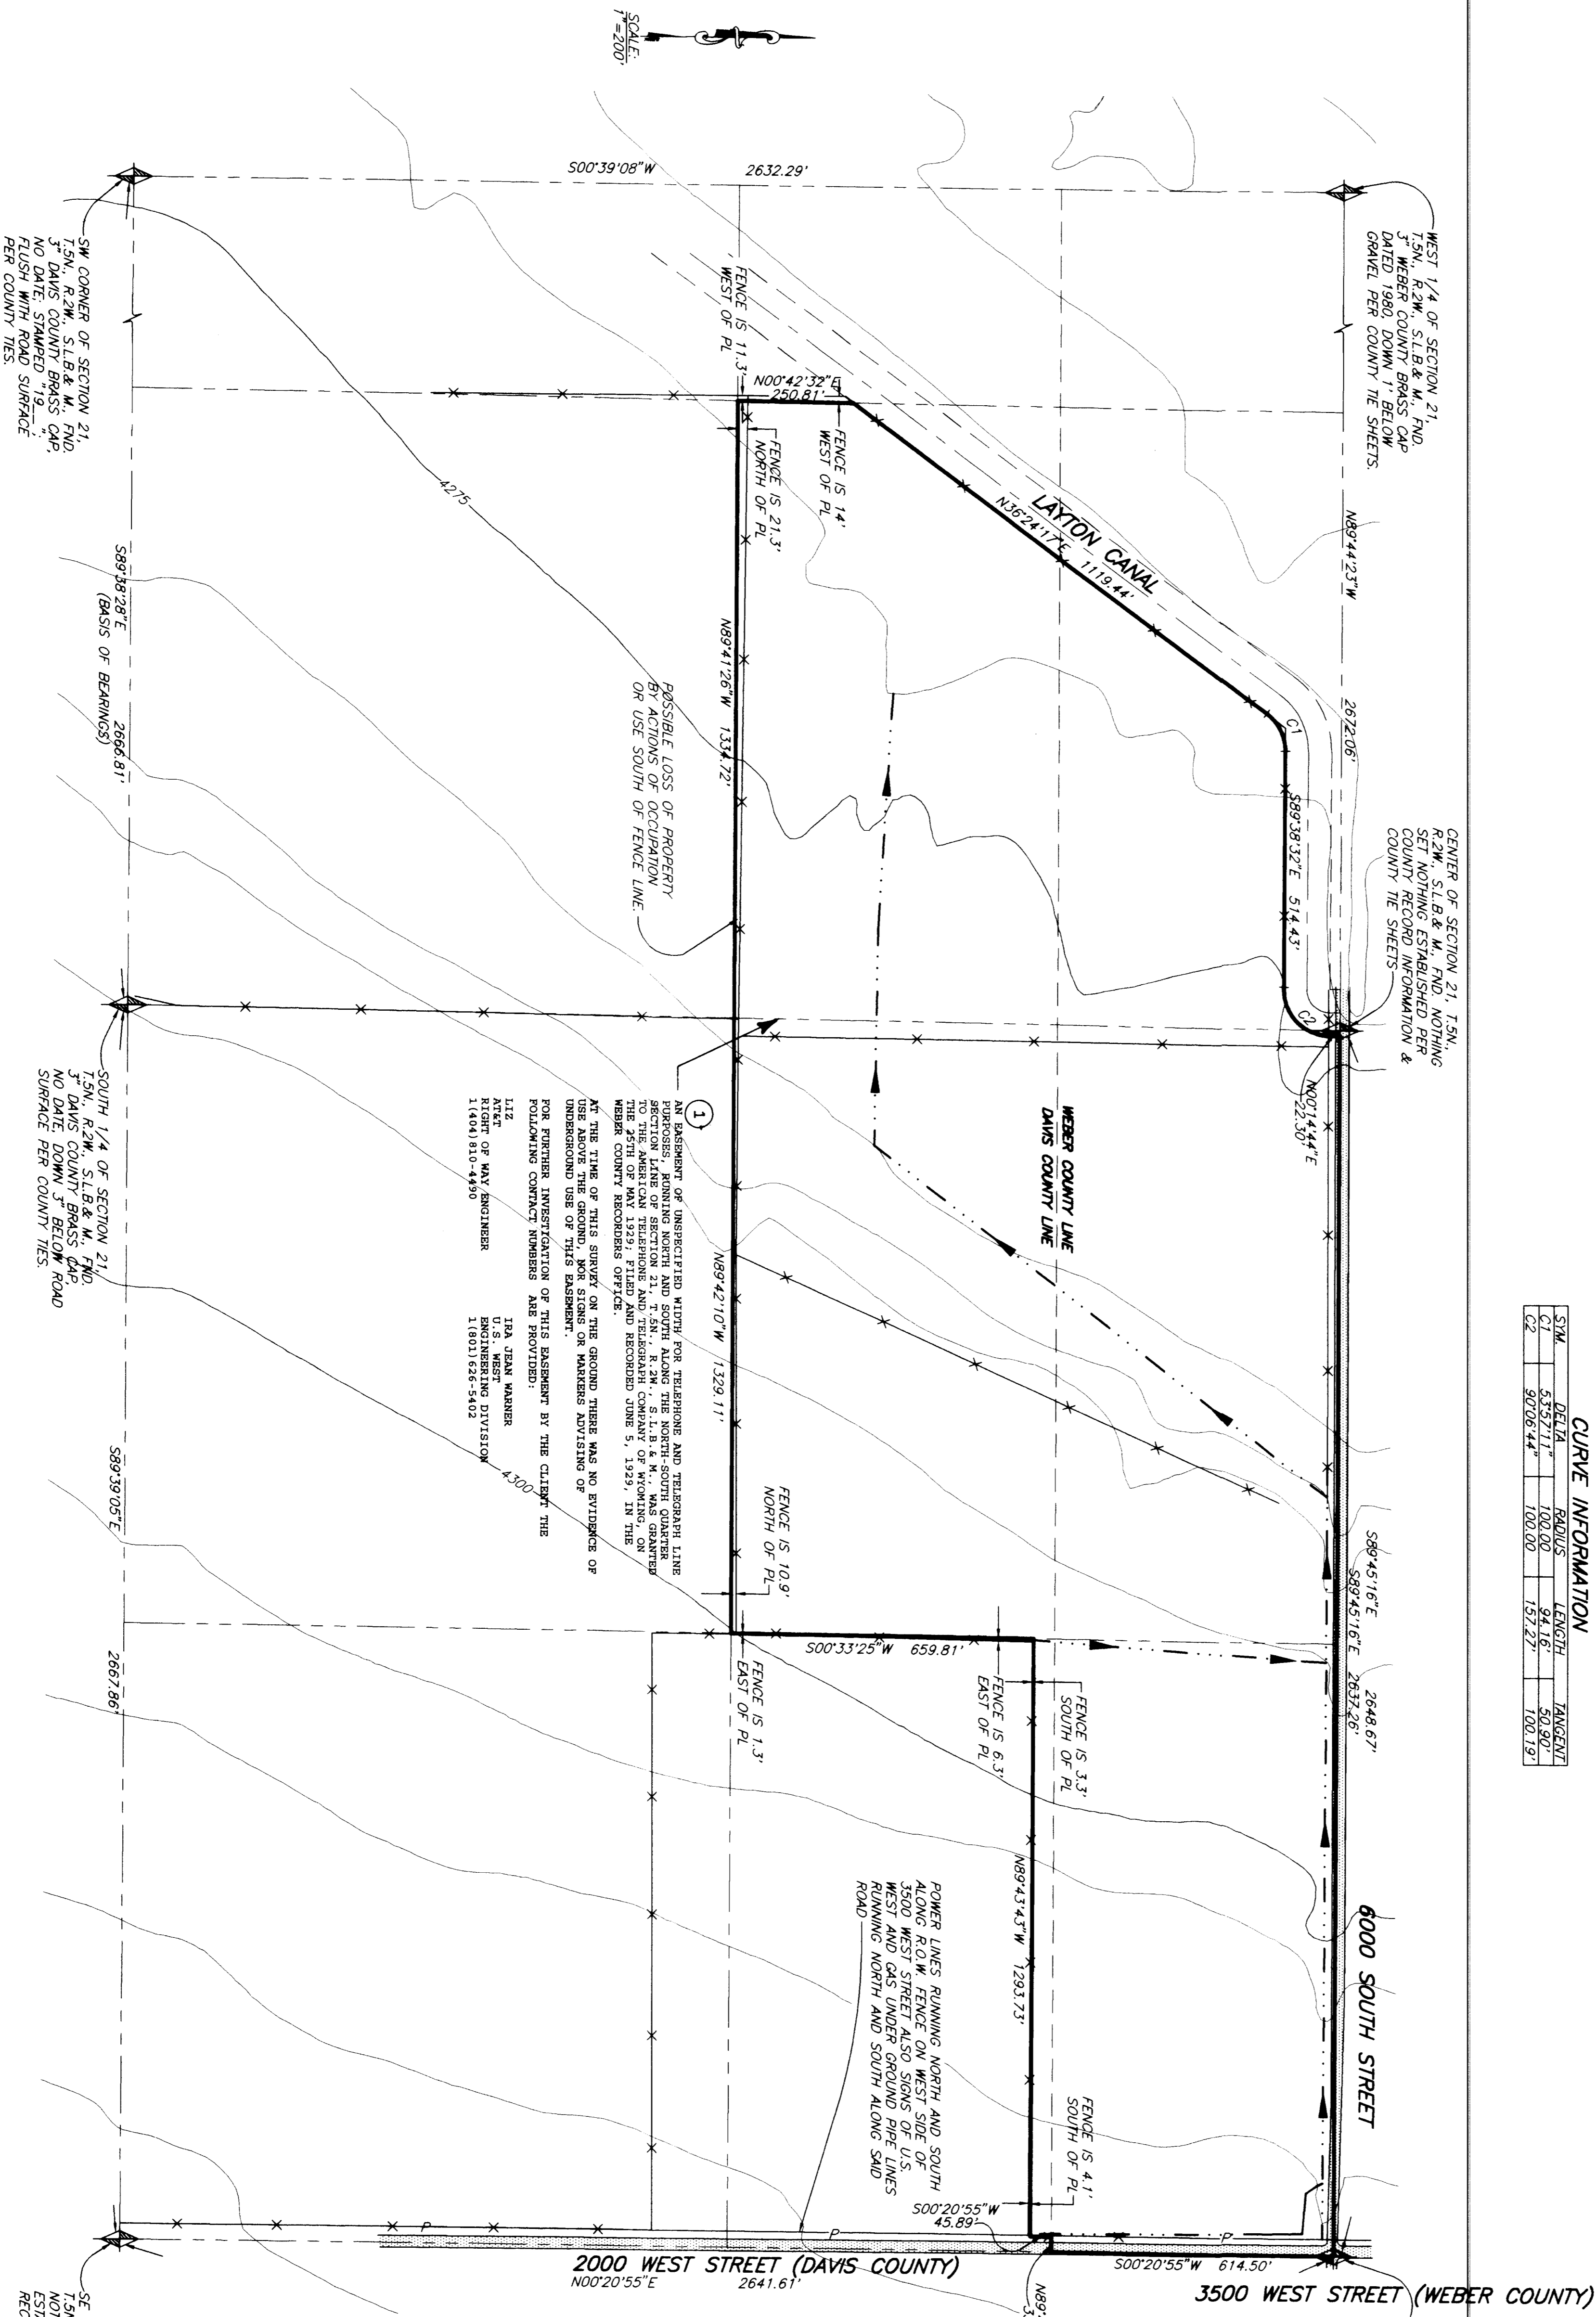



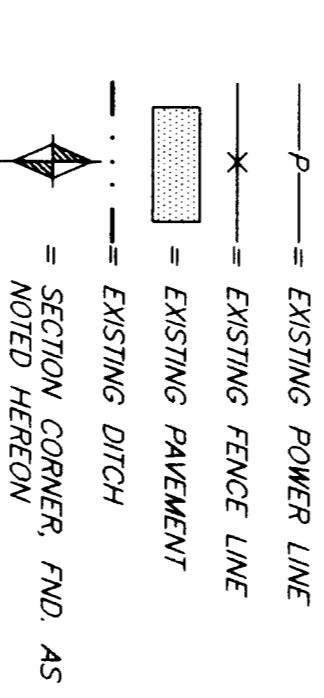

BOUNDARY DESCRIPTION ALL THAT LAND IN DAVIS COUNTY AND WEBER COUNTY, UTAH, BEING A PART OF THE SOUTH 1/2 OF SECTION 21, T.5N., R.2W., S.1&2 & M., U.S. SURVEY, MORE PARTICULARLY DESCRIBED AS FOLLOWS: THE NORTH HALF OF THE NE 1/4 OF THE SE 1/4 OF SAID SECTION 21, TOGETHER WITH THE NW 1/4 OF SAID SE 1/4 OF SECTION 21, ALSO TOGETHER WITH THE NE 1/4 OF THE SW 1/4 OF SAID SECTION 21, EXCEPTING THE ROAD R.O.W. IN DAVIS COUNTY AND ALL THE LAND WHICH LIES TO THE NORTH AND THE WEST OF THE FOLLOWING DESCRIBED EAST FENCE LINE OF THE LAYTON CANAL...

THE PURPOSE OF THIS RECORD OF SURVEY PLAT IS TO DEFINE THE BOUNDARIES OF THE LAND AND TO DEFINE THE BOUNDARIES OF THE LAYTON CANAL AND TO DEFINE THE BOUNDARIES OF THE ROAD R.O.W. AND TO DEFINE THE BOUNDARIES OF THE 6 DESCRIBED PROPERTIES, WHICH ARE ALL ALLOT PARTS OF THE SECTION BREAKDOWN THE BOUNDARY LINES HAVE BEEN HELD TO MONUMENTS AS OF THIS DATE. SEPT. 1988. THE PROPERTY HAS BEEN DESCRIBED AS ONE SINGLE PROPERTY ON THIS PLAT FOR THE PURPOSE OF THE SURVEY AND THE SURVEYOR HAS NOTED THAT THERE ARE SOME SUBSTANTIAL FENCES ALONG THE SOUTH AND WEST LINES TO ONLY BE AN APPROXIMATION OF THE 40 ACRE LINE.

UTAH LICENSE NUMBER 159412 SURVEYOR'S CERTIFICATE

1. RANDALL J. WILFORD, UTAH REGISTERED LAND SURVEYOR NO. 12482, BEING OR UNDER MY SUPERVISION ON THE GROUND AT THE REQUEST OF AND EXCELLENCE FOR THE HOLLIGAN FAMILY INVESTMENTS INC. AND THERE AGENT JEFF PEBLEY, AND HIS TRUST AND CORRECT TO THE BEST OF MY KNOWLEDGE AND BELIEF. SIGNED THIS 7th DAY OF SEPTEMBER 1988.

THESE PLANS AND SPECIFICATIONS ARE THE PROPERTY OF REVE & REVE, INC., 3670 QUINCY AVE. CAGDEN, UTAH, 84303 AND SHALL NOT BE COPIED OR REPRODUCED WITHOUT THEIR WRITTEN PERMISSION. RECORD INFORMATION.

HOLLIGAN FAMILY INVESTMENTS INC. A PART OF THE SOUTH 1/2 OF SECTION 21, T.5N., R.2W., S.1&2 & M., U.S. SURVEY. 4th DAY OF SEPTEMBER 1988.