DRAWING NUMBER
001469
PLAN HOLD CORPORATION • IRVINE, CALIFORNIA
REORDER BY NUMBER 07548

DRAWING NUMBER
001469
PLAN HOLD CORPORATION • IRVINE, CALIFORNIA
REORDER BY NUMBER 07548

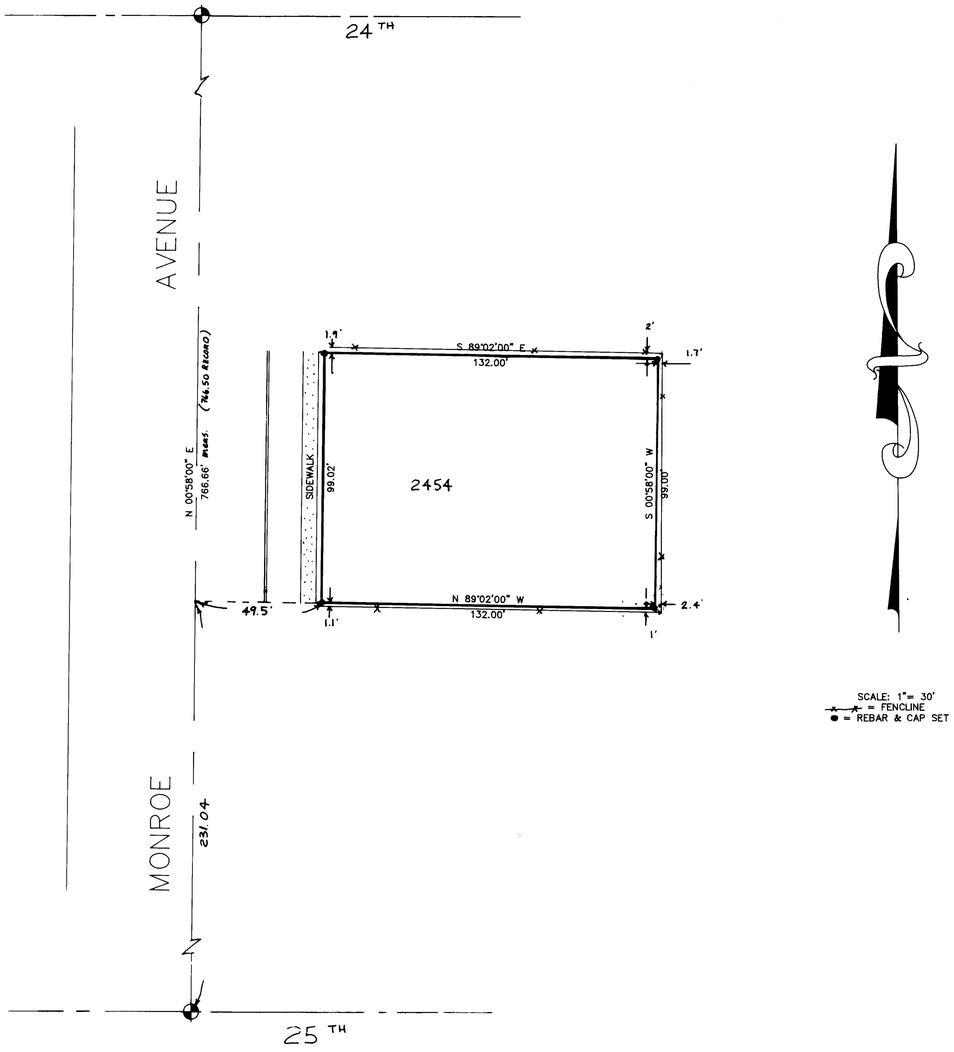

SCALE: 1"= 30'
= FENCLINE
● = REBAR & CAP SET

SURVEYORS CERTIFICATE

I, DALLAS K. BUTTARS, A REGISTERED LAND SURVEYOR AS PRESCRIBED BY THE LAWS OF THE STATE OF UTAH AND HOLDING LICENSE NUMBER 6985, DO HEREBY CERTIFY THAT I MADE A SURVEY OF THE BELOW DESCRIBED PROPERTY AND THE PLAT HEREON IS A TRUE AND CORRECT REPRESENTATION OF SAID SURVEY.
DATE: June 5 1995 SIGNED Dallas K. Buttars

DESCRIPTION

PART OF LOT 5, BLOCK 8, PLAT B, OGDEN CITY SURVEY, WEBER COUNTY, UTAH: BEGINNING AT A POINT 11 RODS NORTH OF THE SOUTHWEST CORNER OF SAID LOT 5, AND RUNNING THENCE NORTH 99 FEET, THENCE EAST 132 FEET TO THE EAST LINE OF SAID LOT, THENCE SOUTH 99 FEET, THENCE WEST 132 FEET TO THE PLACE OF BEGINNING.

NARRATIVE

THE PURPOSE OF THIS SURVEY WAS TO LOCATE THE BOUNDARY FOR IMPROVEMENT PURPOSES.

RECEIVED
NOV 15 1995
Weber County Surveyor

Client: Johnson
Location: BLK8, PlatB ogdencity survey
Date: June 1995

LANDMARK SURVEYING
A COMPLETE SURVEYING SERVICE
2485 GRANT AVE. SUITE 318-B OGDEN, UTAH 84401
PH 627-4014 392-5291

001469