


**DESCRIPTION**  
All of Lot 7, Block 11, Mob Hill Addition to Ogden City, Weber County, Utah. The East 5 feet of Lot 6, Block 11, Mob Hill Addition to Ogden City, Weber County, Utah.

**MARRIETTE**  
This survey was done for Mrs. Patricia S. Ziegler at the request of her son. The survey was done to establish the corners of her property. Ogden City Monuments were found at the intersections of 24th and Polk Avenue and 24th and Taylor Avenue. A line bearing of South  $89^{\circ}02'$  East (Ogden City Bearing) between these 2 monuments was used as a basis of bearings. All corners of the property were set as depicted on this drawing with a rubber and plastic cap stamped Great Basin Engineering.

I, Gary L. Neman, do hereby certify that I am a Registered Land Surveyor, and that I hold Certificate No. 4778, as prescribed by the Laws of the State of Utah, and I have made a survey of the above described property. I further certify that the above plat correctly shows the true dimensions of the property surveyed.

Date 8-3-88  
*Gary L. Neman*  
Gary L. Neman

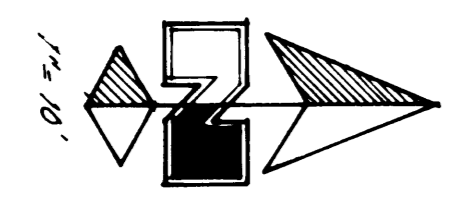

**RECEIVED**  
AUG 11 1988  
Weber County Surveyor

**GREAT BASIN ENGINEERING, INC.**  
REGISTERED LAND SURVEYORS  
SALT LAKE CITY, UTAH

**PROPERTY SURVEY**  
for  
**PATRICIA S. ZIEGLER**  
OGDEN CITY, WEBER COUNTY, UTAH

A PART OF THE S.W. 1/4 OF SEC. 21, T4N, R10E, S18M

29 JUL 1988  
1" = 10'