


DRAWING NUMBER
001509

DRAWING NUMBER
001509

DRAWING NUMBER
001509

DRAWING NUMBER
001509


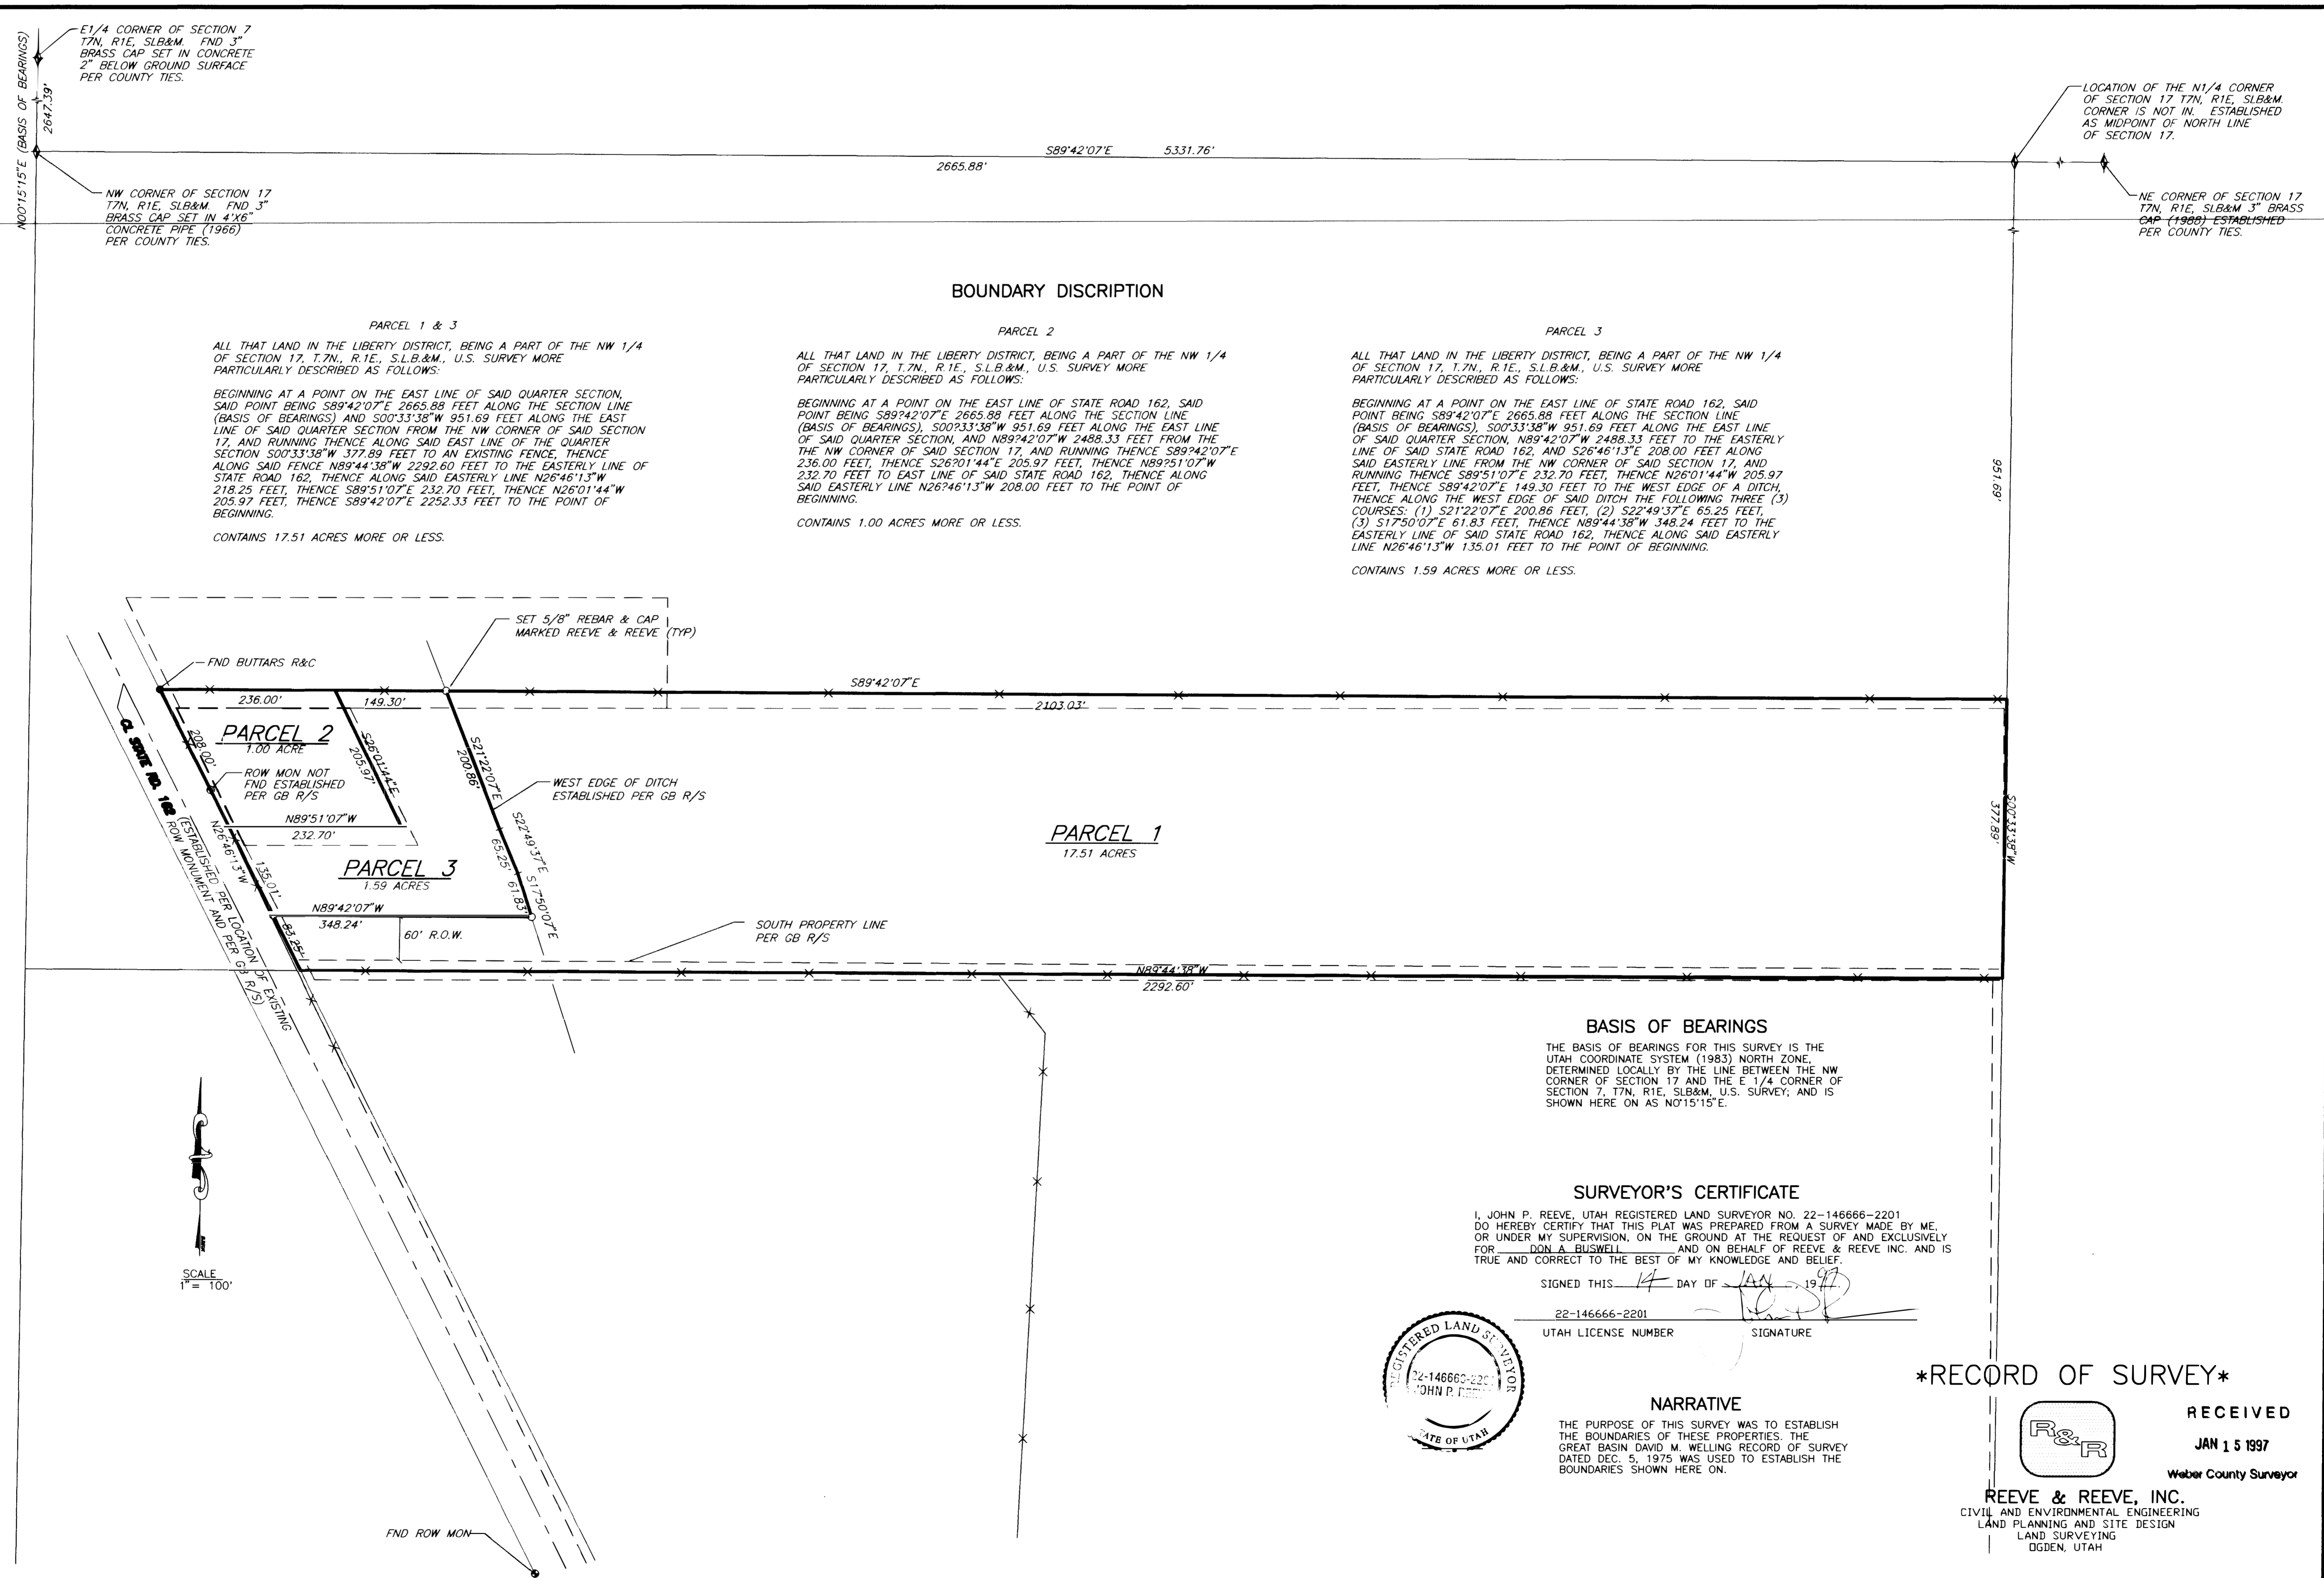

NO.	REVISIONS
1.	4
2.	5
3.	6

PROJECT NO. 2332-01	DESIGNED B. MORTENSEN
DATE 1-3-98	DRAWN ROYAN HANSEN
SCALE 1" = 100'	APPROVED

REEVE & REEVE, INC
CIVIL AND ENVIRONMENTAL ENGINEERING
LAND PLANNING AND SITE DESIGN
LAND SURVEYING
OGDEN, UTAH

RECORD OF SURVEY

DON A. BUSWELL PROPERTY

SHEET 1 1 SHEETS

001509