



NO. 1	DATE	APPROVED
1	2/17/91	TS
2	MARCH 10, 1992	APPROVED
3		
4		





REEVE & REEVE, INC.
CIVIL AND ENVIRONMENTAL ENGINEERING
LAND PLANNING AND SITE DESIGN
OGDEN, UTAH

RECORD OF SURVEY

KEN TEZAK & RICHARD
EVANS PROPERTY

SHEET	1
SHEETS	1

- LEGEND**
 - = SET 5/8" REBAR & CAP MARKED
 - ◇ = SECTION CORNER FOUND AS NOTED HEREON

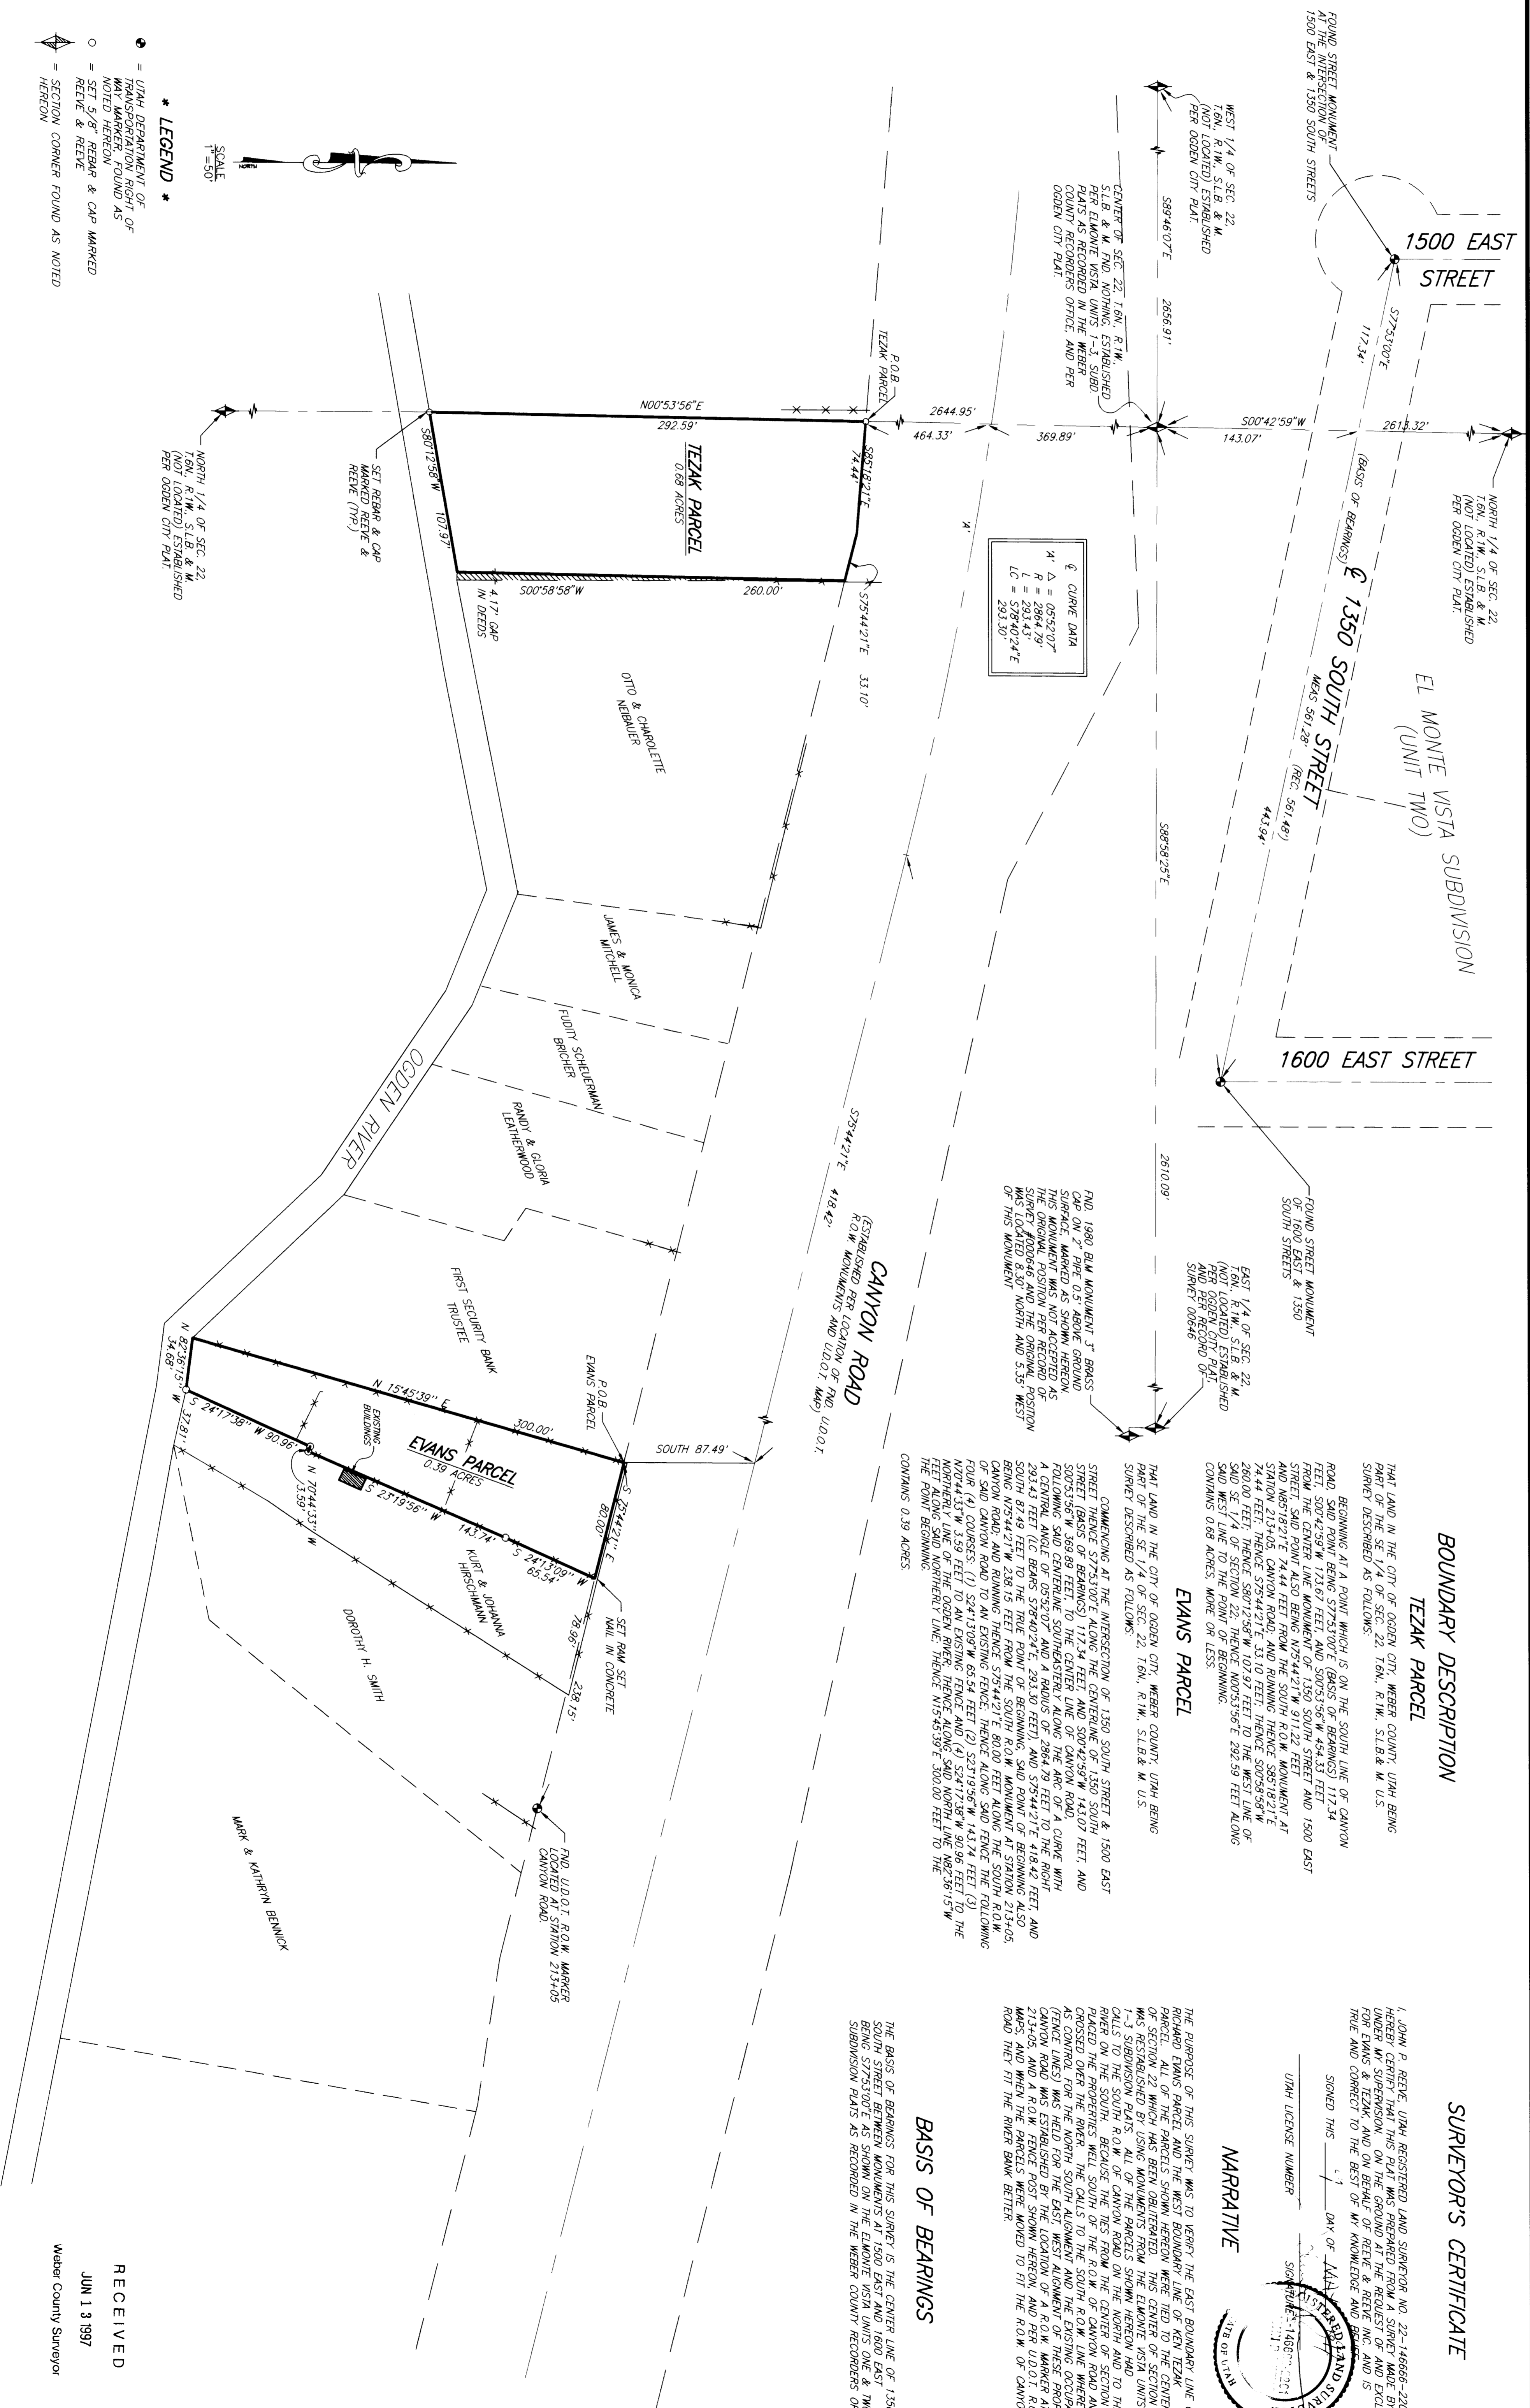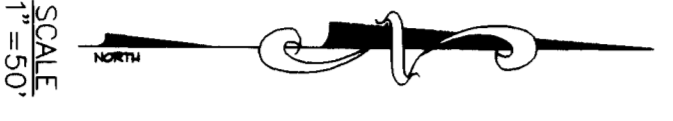

BASIS OF BEARINGS

THE BASIS OF BEARINGS FOR THIS SURVEY IS THE CENTER LINE OF 1350 SOUTH STREET BETWEEN MONUMENTS AT 1500 EAST AND 1600 EAST TWO SUBDIVISION PLATS AS RECORDED IN THE WEBER COUNTY RECORDERS OFFICE.

NARRATIVE



SURVEYOR'S CERTIFICATE



JOHN P. REEVE
SURVEYOR

STATE OF UTAH
COUNTY OF WEBER

RECEIVED
JUN 1 3 1997
Weber County Surveyor