

G:\DRAWINGS\SHARED\2685\02-PLUMB\PLUMSUR Thu Jun 5 15:03:41 1997 JAE

REVISIONS

1	
2	
3	
4	
5	
6	




PROJECT NO. 2685-02 SURVEYOR # M. WILSON
DATE 5-15-97 DRAWN BY JAE
SCALE 1"=50' CHECKED

REEVE & REEVE, INC.
ENGINEERS PLANNERS & SURVEYORS
3670 QUINCY AVE. SUITE NO. 100
(801) 621-5100 FAX (801) 621-2666

RECORD OF SURVEY

WALT PLUMB PROPERTY

SHEET 1 OF 1 SHEETS

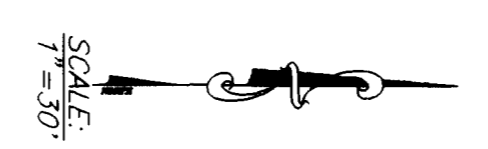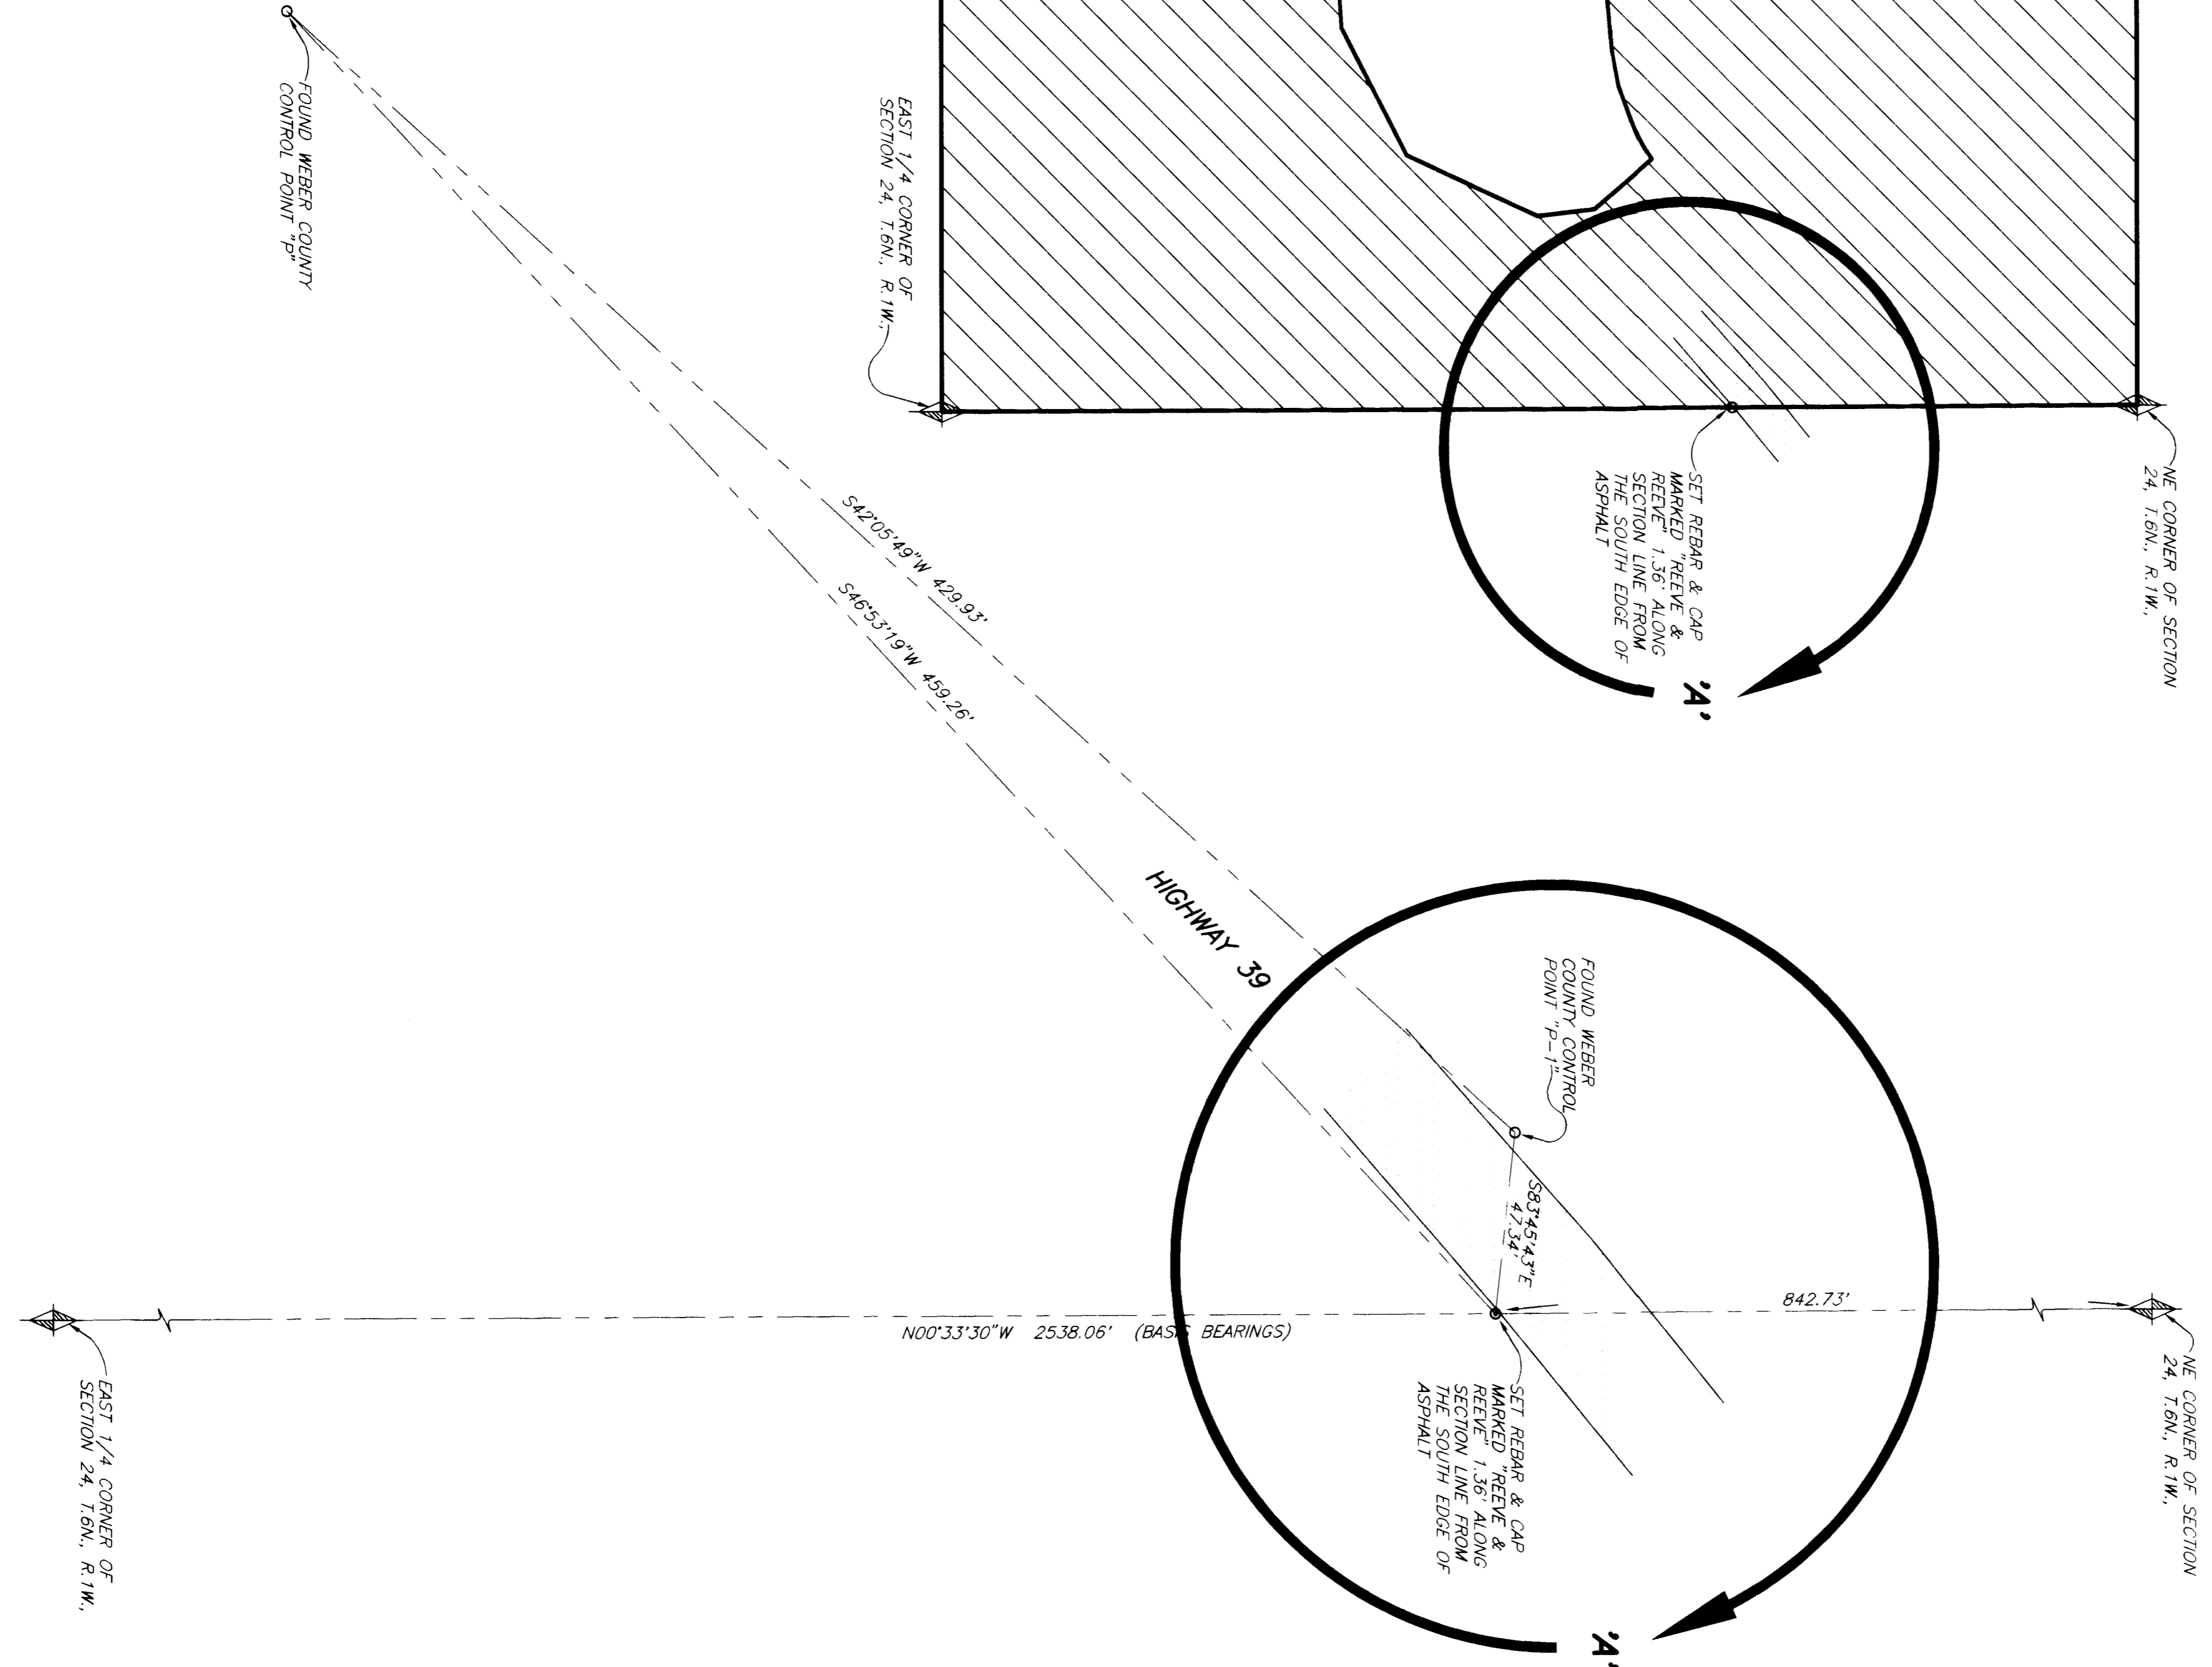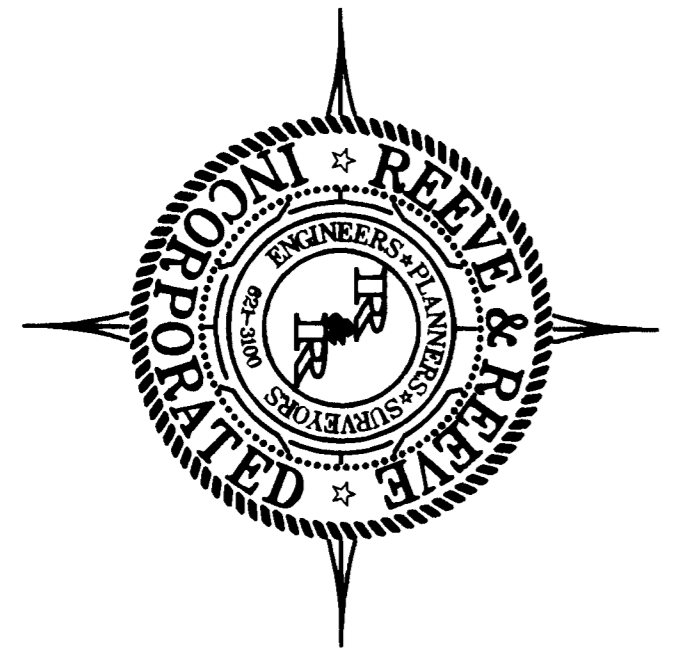

- LEGEND**
- = SECTION CORNER FOUND AS NOTED HEREON.
 - = FOUND WEBER COUNTY CONTROL POINT
 - = SET CONTROL POINT
 - = EXISTING ASPHALT

BOUNDARY DESCRIPTION (NOT SURVEYED)



NARRATIVE



RECEIVED
JUN 13 1997
Weber County Surveyor

SURVEYORS CERTIFICATE
I, RANDALL J. WILFORD, DEPOSE AND SAY THAT I AM A LICENSED PROFESSIONAL LAND SURVEYOR, HOLDING UTAH LICENSE NUMBER 159437, AND THAT I HAVE PERSONALLY CONDUCTED THE SURVEY AND THAT THIS PLAN CORRECTLY DEPICTS THE FINDINGS OF THAT SURVEY.
SIGNED THIS 7TH DAY OF _____ 19 97.
159437
UTAH LICENSE NUMBER
[Signature]

