


00100

659

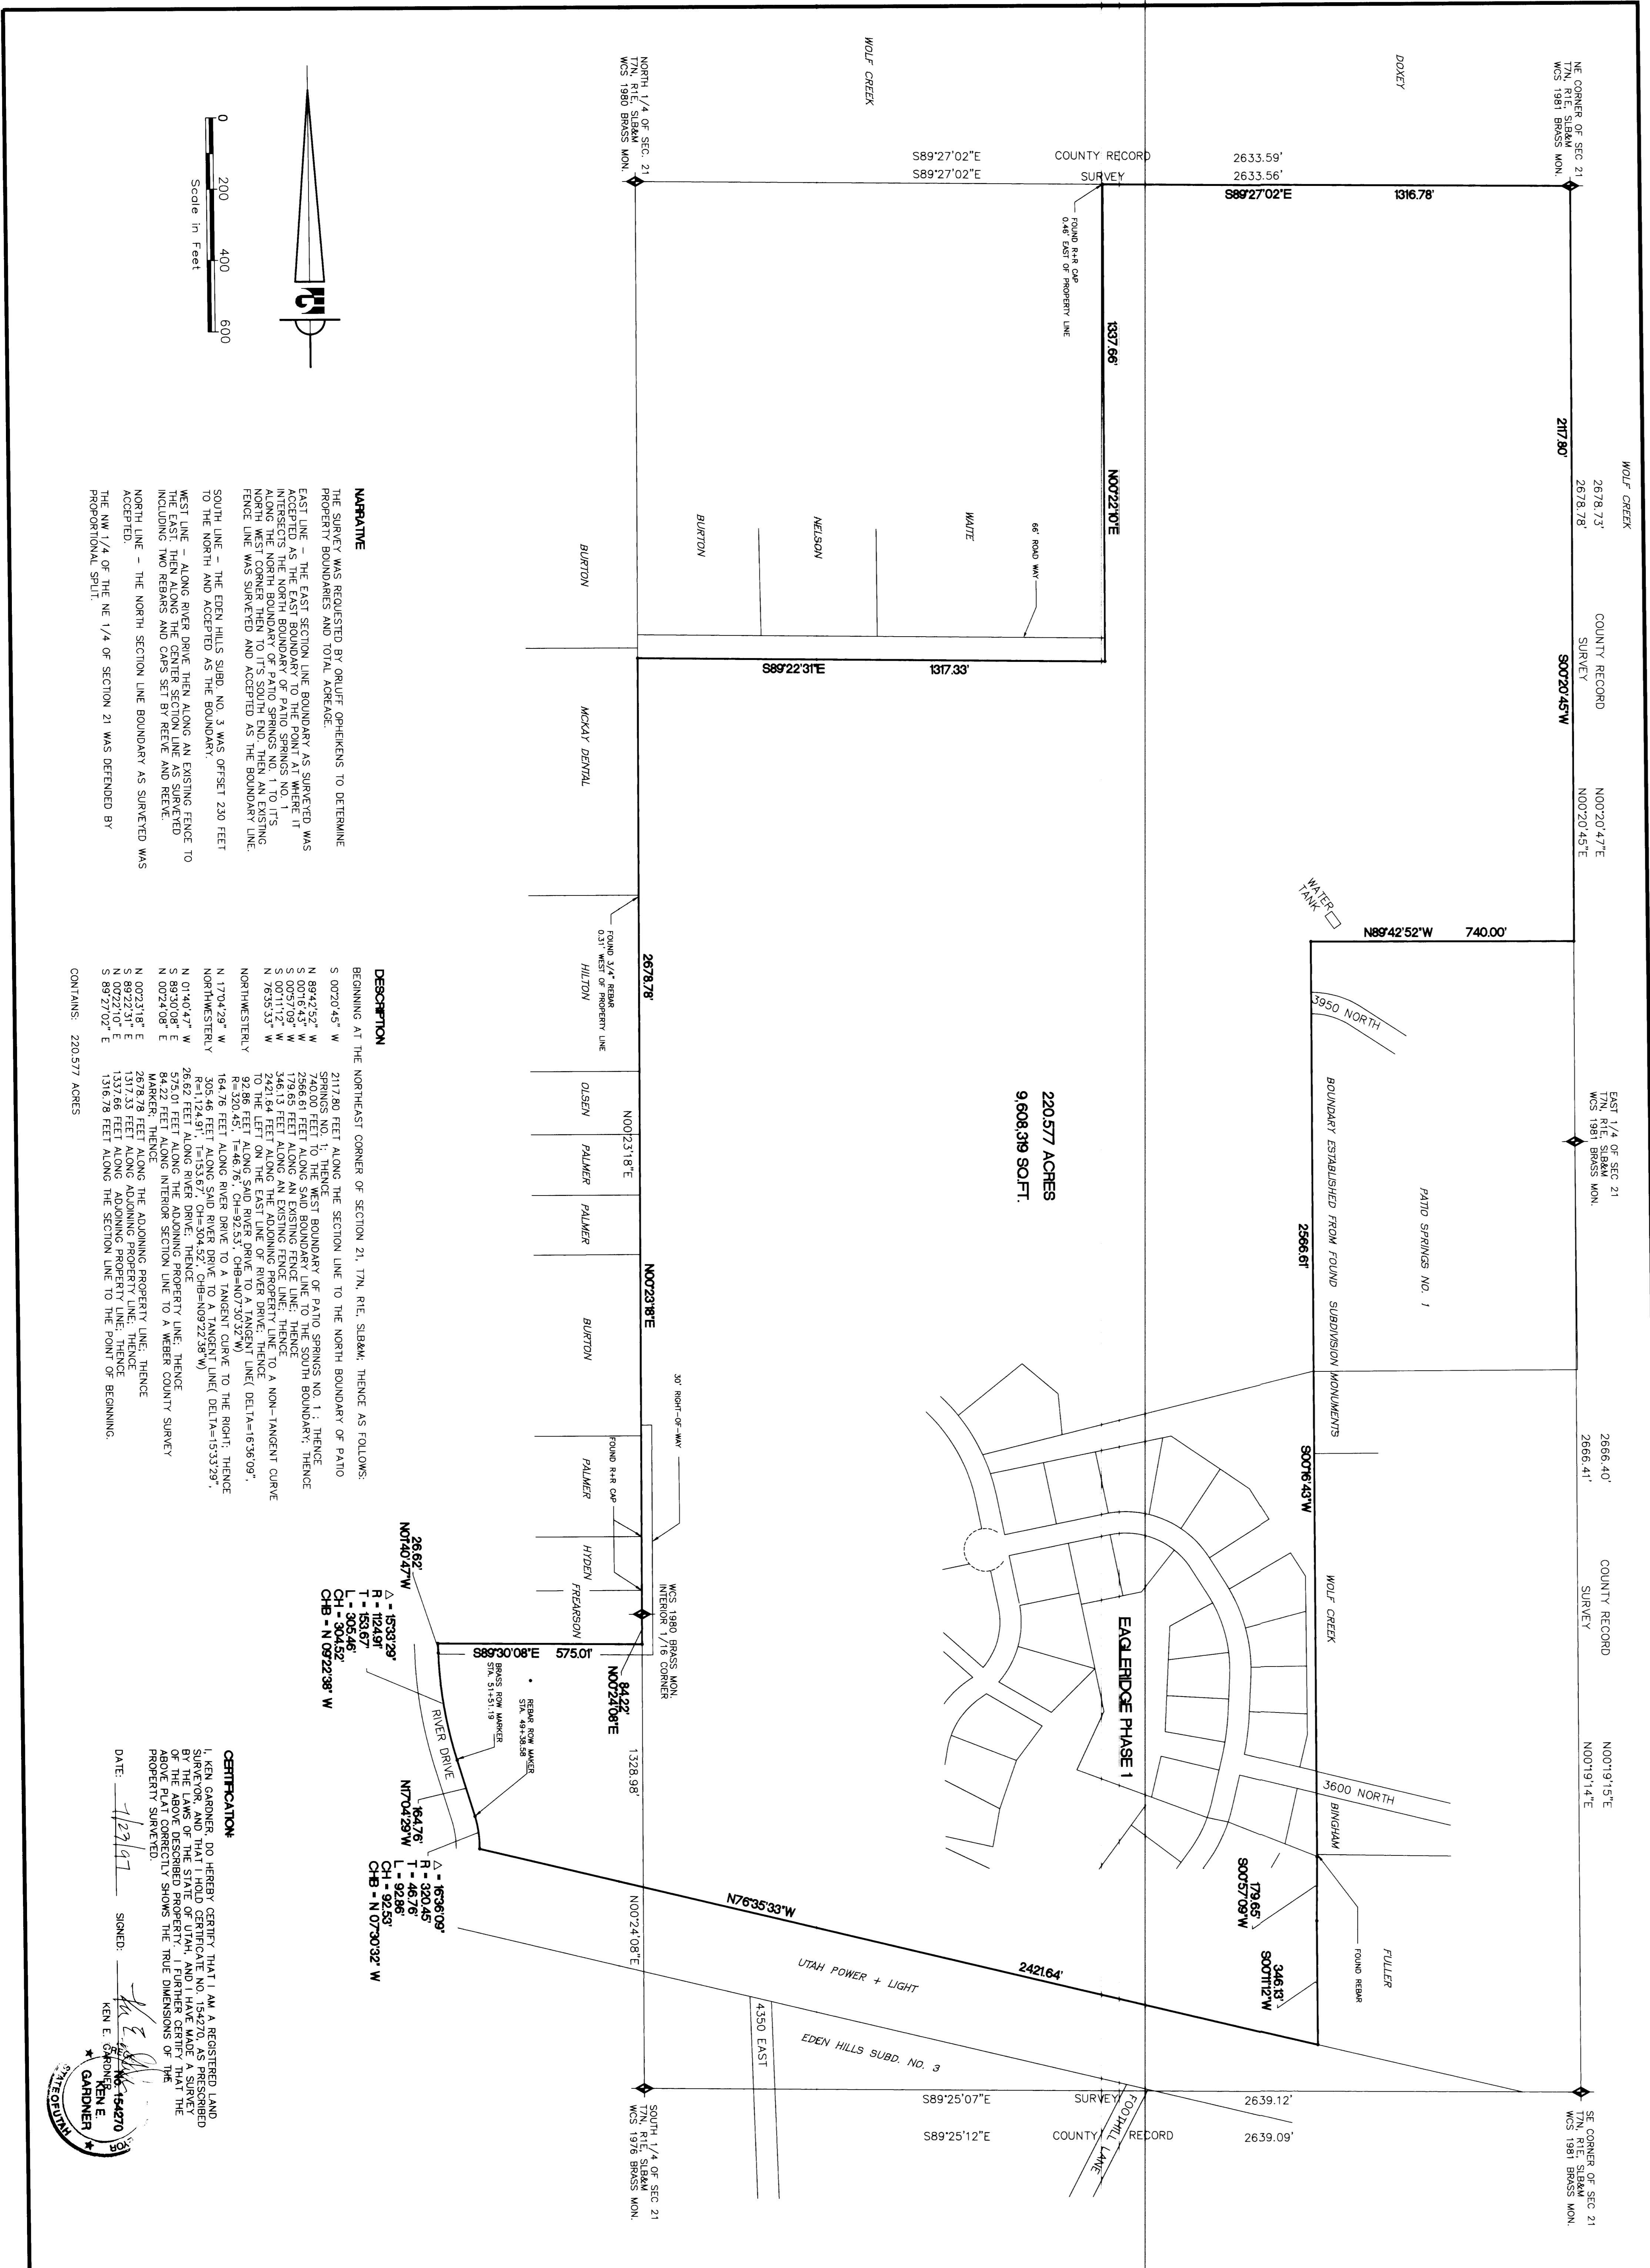

NARRATIVE
THE SURVEY WAS REQUESTED BY ORLUFF OPHEIKENS TO DETERMINE PROPERTY BOUNDARIES AND TOTAL ACREAGE.
SOUTH LINE - THE EDEN HILLS SUBD. NO. 3 WAS OFFSET 230 FEET TO THE NORTH AND ACCEPTED AS THE BOUNDARY.
NORTH LINE - THE NORTH SECTION LINE BOUNDARY AS SURVEYED WAS ACCEPTED.
THE NW 1/4 OF THE NE 1/4 OF SECTION 21 WAS DEFENDED BY PROPORTIONAL SPLIT.

DESCRIPTION
BEGINNING AT THE NORTHEAST CORNER OF SECTION 21, T7N, R1E, S1B&M, THENCE AS FOLLOWS:



CERTIFICATION
I, KEN GARDNER, DO HEREBY CERTIFY THAT I AM A REGISTERED LAND SURVEYOR AND THAT I HOLD CERTIFICATE NO. 134270, AS PRESCRIBED BY THE LAWS OF THE STATE OF UTAH, AND I HAVE MADE A SURVEY ABOVE THAT CORRECTLY SHOWS THE TRUE DIMENSIONS OF THE PROPERTY SURVEYED.
DATE: 7/29/97 SIGNED: KEN E. GARDNER
KEN E. GARDNER
STATE OF UTAH
LAND SURVEYOR

1
1

Gardner Engineering LLC
5150 Washington Blvd.
Ogden, Utah 84405
(801) 476-0202

ORLUFF OPHEIKENS PROPERTY SURVEY
A PART OF THE EAST HALF OF SECTION 21
T7N, R1E, S1B&M
WEBER COUNTY, UTAH

REVISIONS	
NO.	DATE

RECEIVED
AUG 01 1997
Weber County Surveyor

SCALE: 1" = 200' H
DATE: JULY 97
DESIGN: D.D.S.
DRAWN: D.D.S.
PROJ. NO.:
DWG.: