

DRAWING NUMBER  
001665

PLAN HOLD CORPORATION • IRVINE, CALIFORNIA  
REORDER BY NUMBER 07548

DRAWING NUMBER  
001665

PLAN HOLD CORPORATION • IRVINE, CALIFORNIA  
REORDER BY NUMBER 07548



ALTA Thu Jul 17 17:57:16 1997 ENSIGN ENGINEERING/PHM

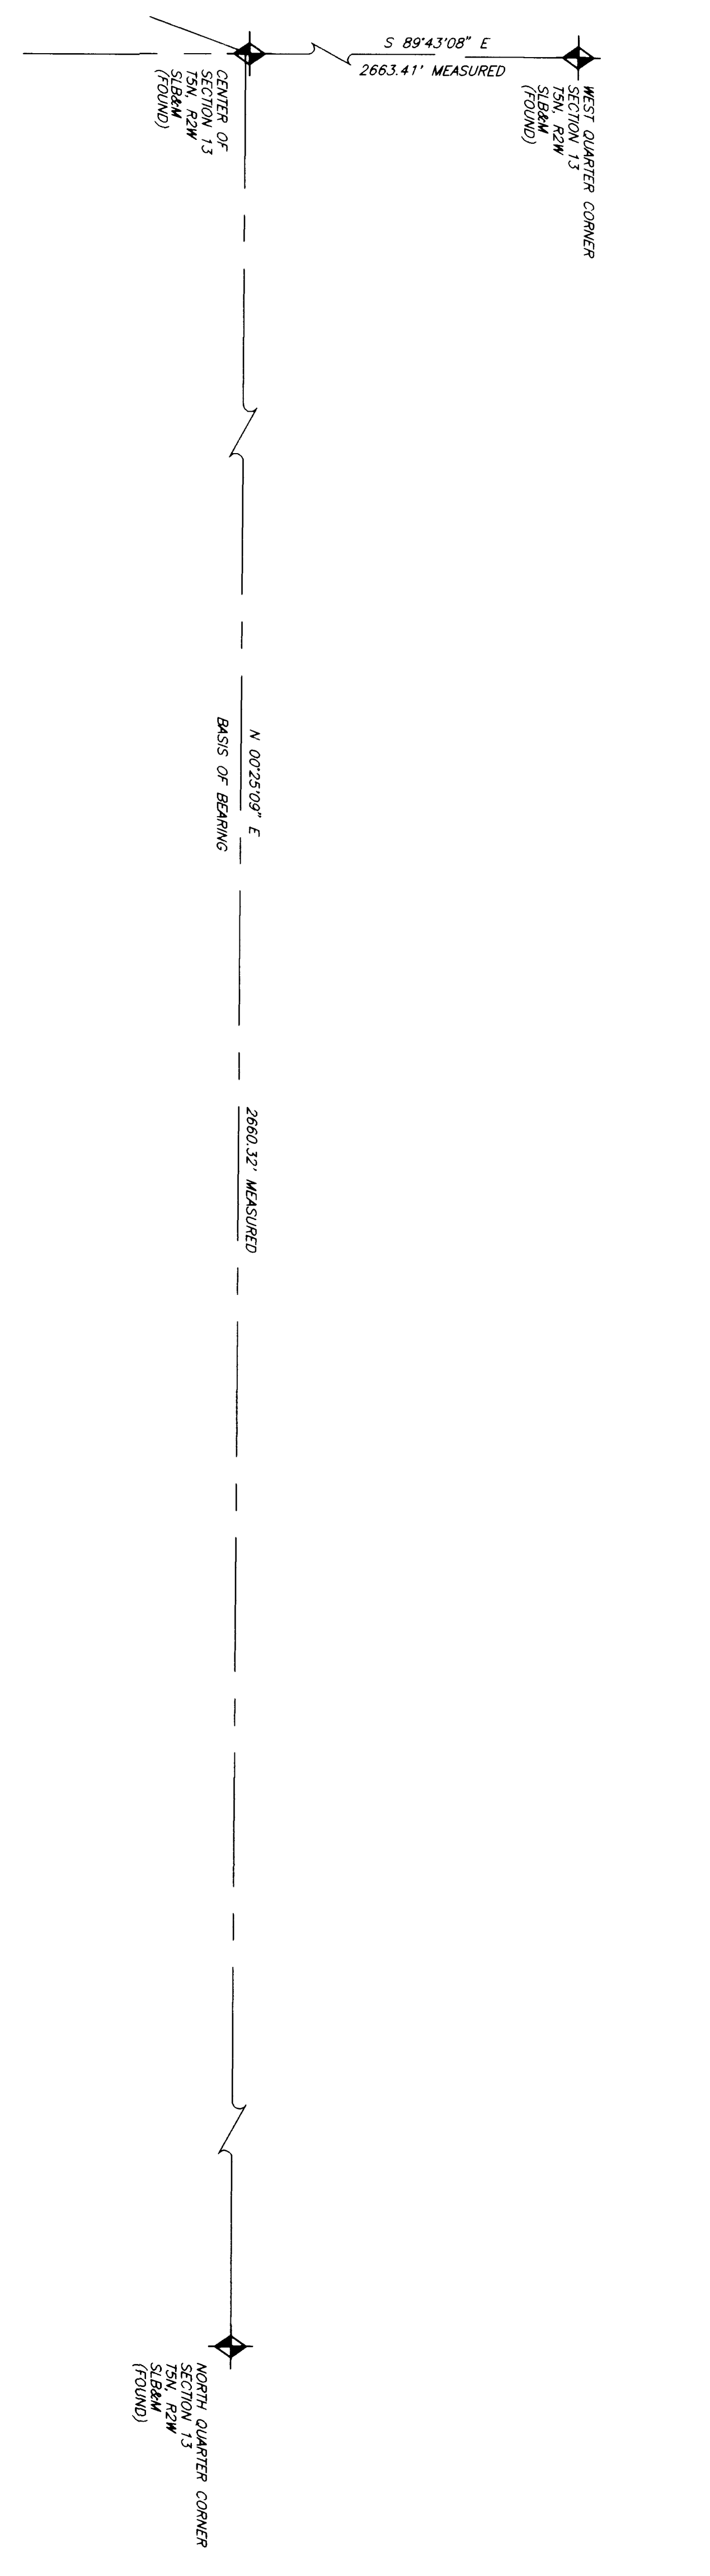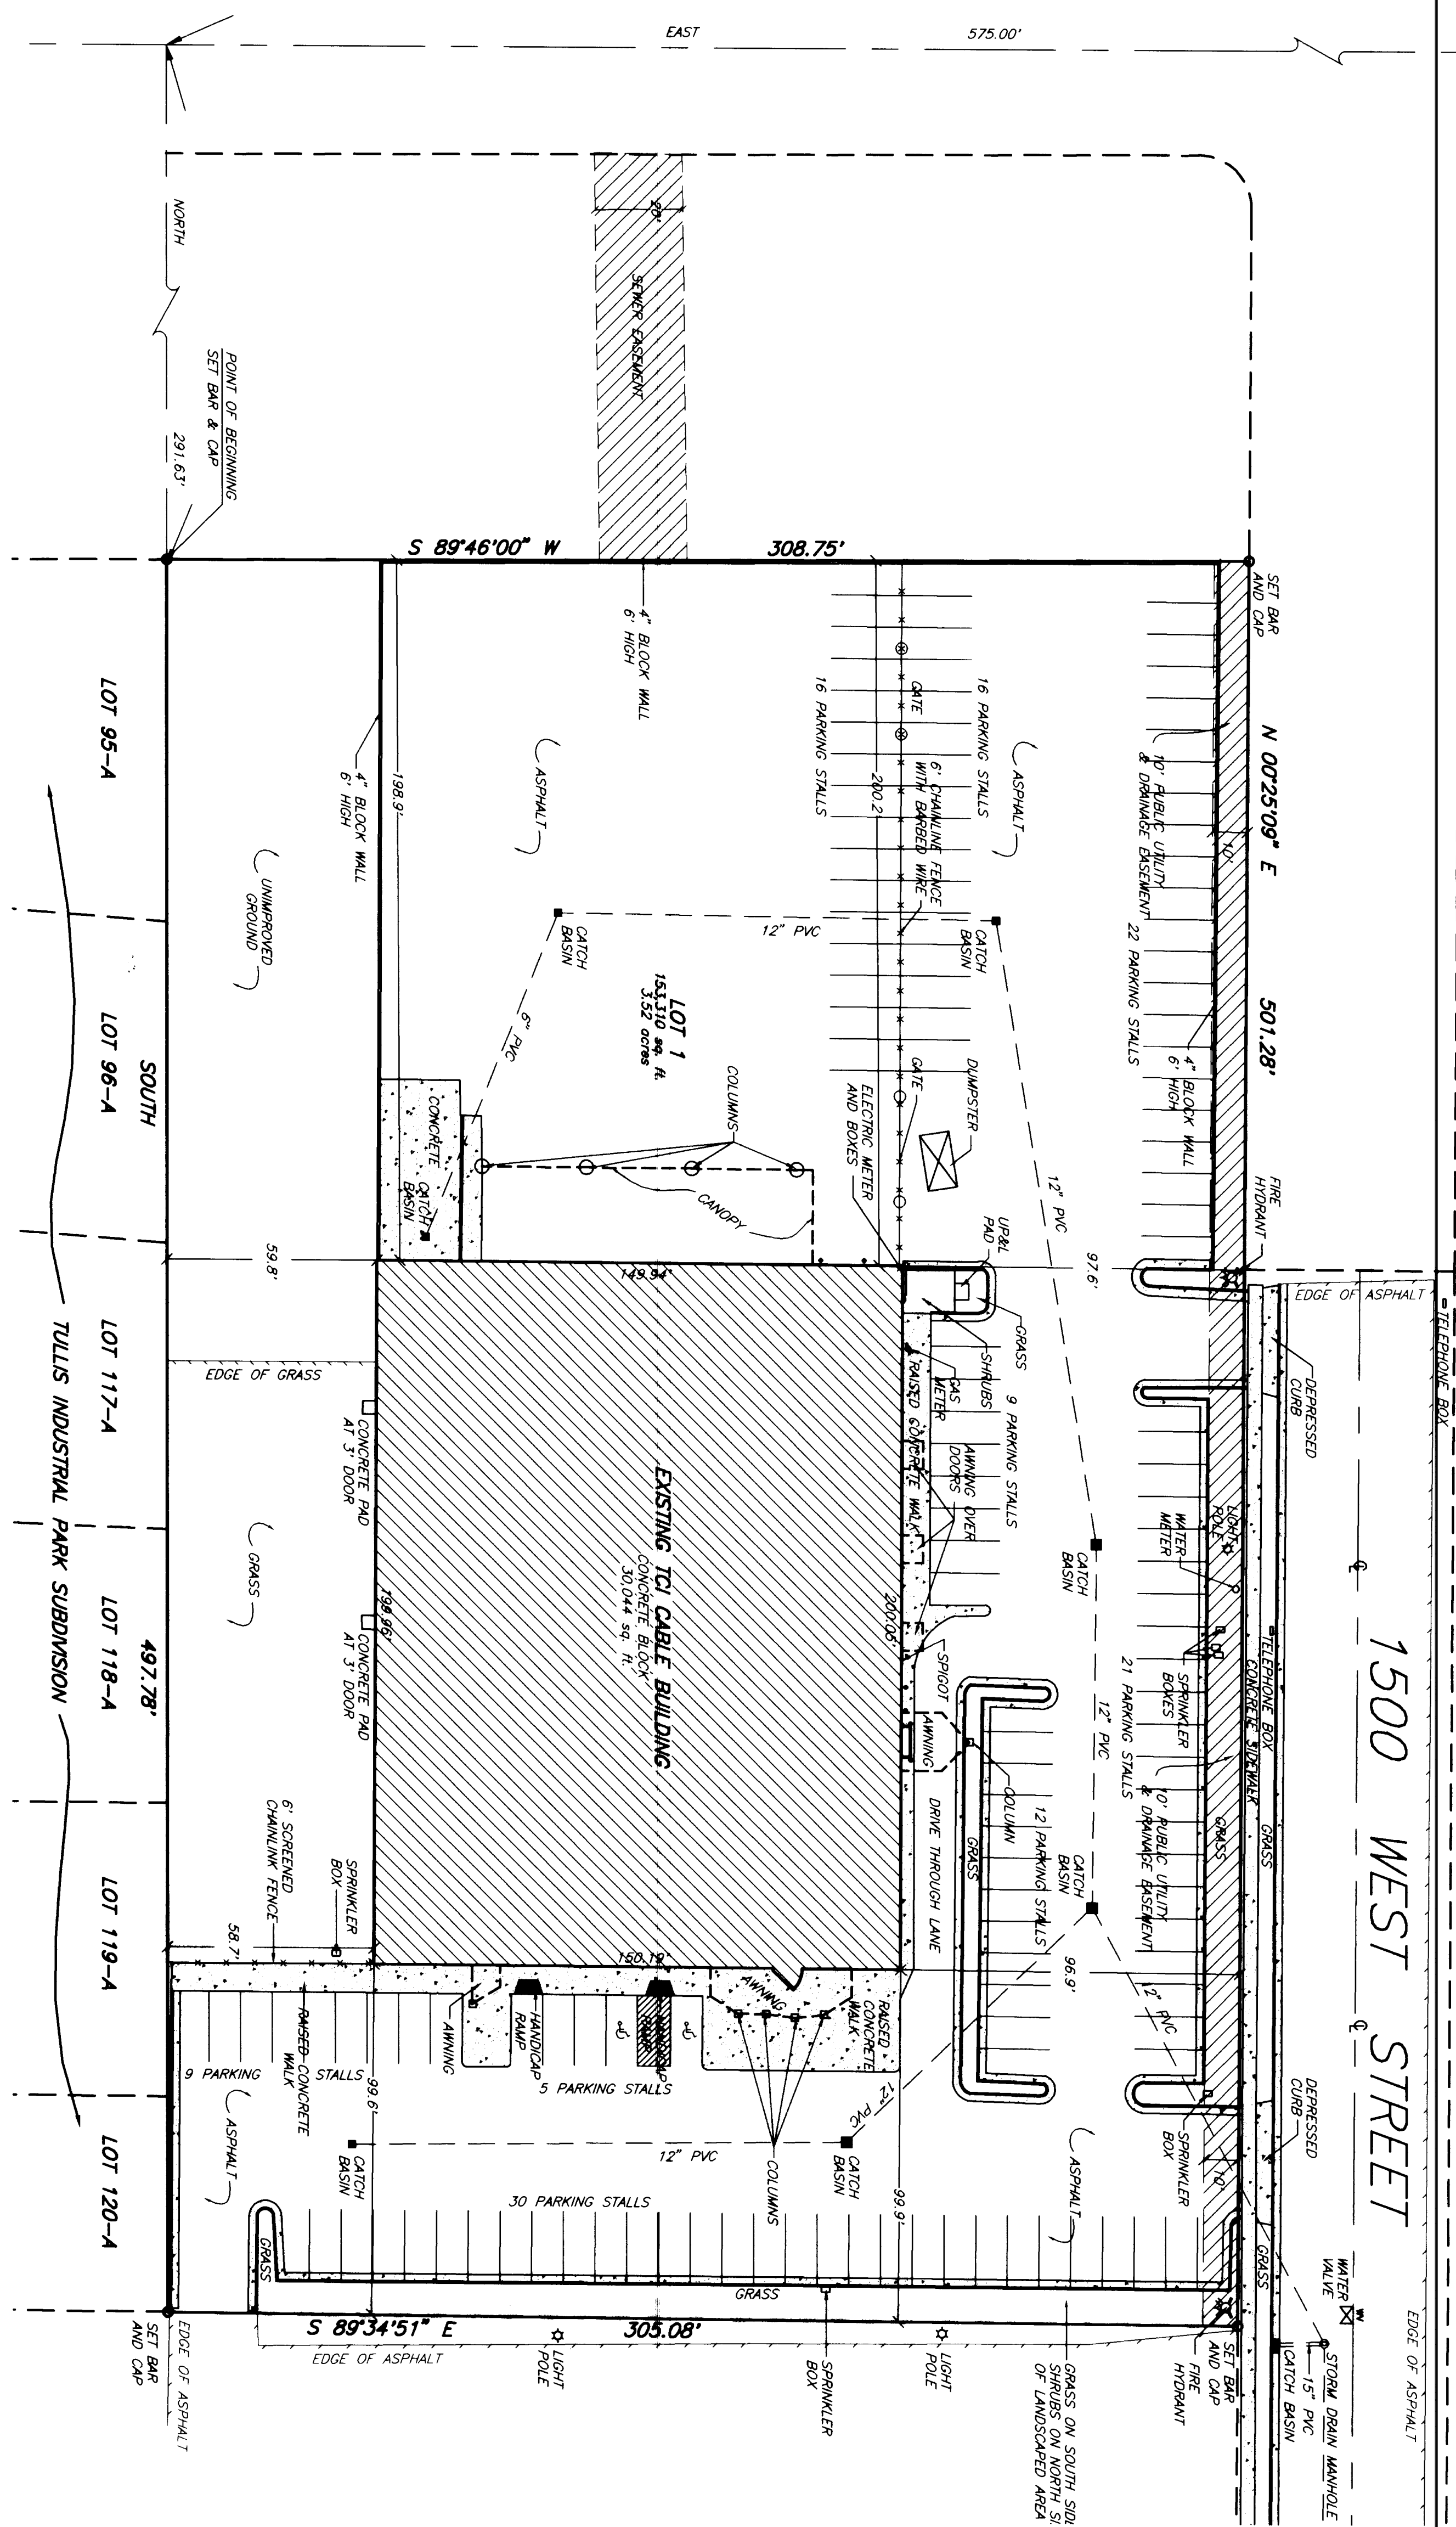

RECEIVED  
AUG 01 1997  
Utah County Surveyor

LOCATED IN THE NORTHEAST QUARTER  
TOWNSHIP 5 NORTH RANGE 2 WEST  
SALT LAKE BASIN & MERIDIAN  
RIVERDALE CITY, WEBER COUNTY, UTAH

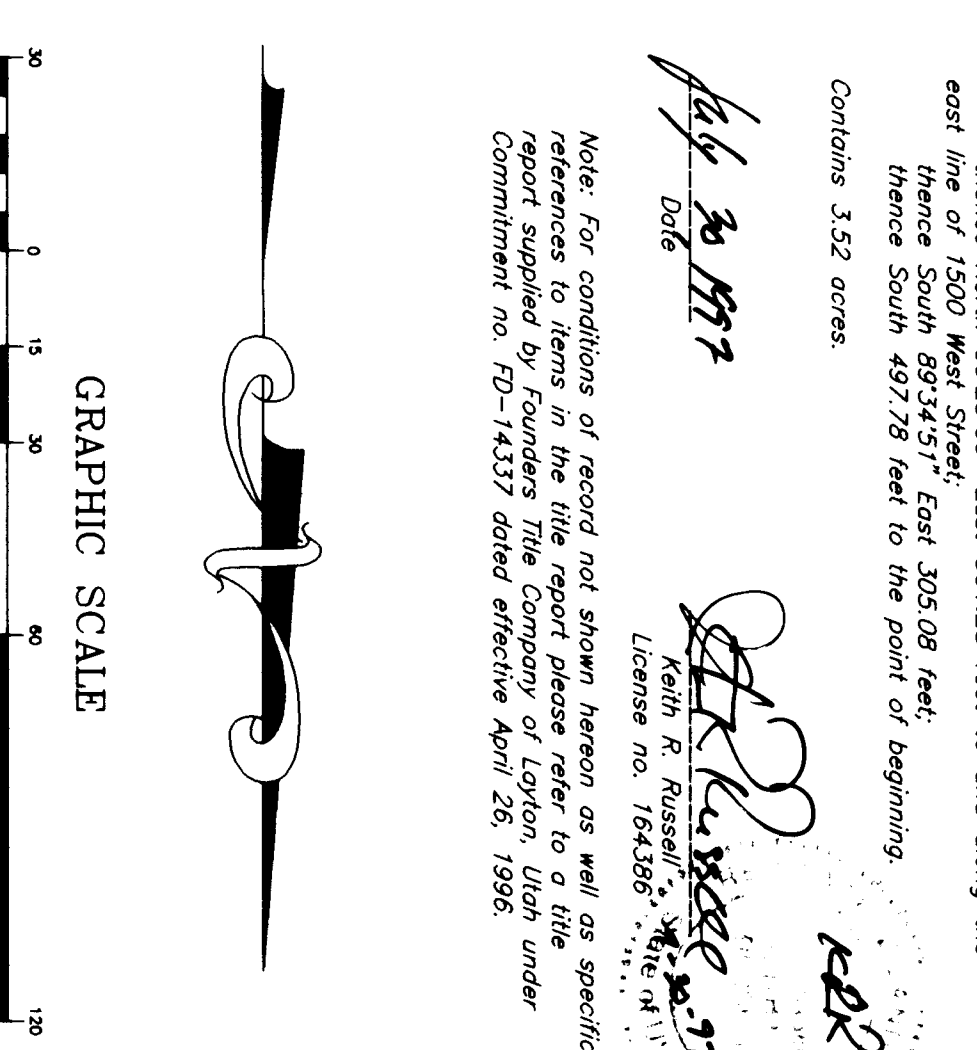

**BOUNDARY DESCRIPTION**

ALL OF LOT 1 OF A PROPOSED INDUSTRIAL PARK SUBDIVISION (NOT YET RECORDED) BEING THE SOUTHWEST QUARTER OF SECTION 13, TOWNSHIP 5 NORTH, RANGE 2 WEST OF THE SALT LAKE BASIN & MERIDIAN, WEBER COUNTY, UTAH, AS SHOWN ON THE ATTACHED SURVEY OF SAID LOT 1, IS DESCRIBED AS FOLLOWS:


thence South 89°46'00" West 308.75 feet;


thence South 89°34'51" East 305.08 feet;



*K. R. Russell*  

TITLE  
**TCI CABLE BUILDING**  
1500 WEST RIVERDALE ROAD  
RIVERDALE, UTAH  
FOR  
**DEVCOR**  
**ALTA/ASCM LAND TITLE SURVEY**

date of job: JULY 17, 1996  
project no.: 95-127  
sheet: 1 OF 1

design:	drawn: WJM
project engineer:	scale:
no. date:	revision:

**ENSIGN**  
engineering • planning • surveying

4455 South 700 East, Suite 201  
Salt Lake City, Utah 84107

(801) 263-2456  
fax (801)-263-2742

001665

001665