


LEGEND

- Set rebar and cap
- Existing Brass Monument
- △ Existing PK Nail
- Tree


SURVEYOR'S CERTIFICATE

I, Peter Rodney Thompson, do hereby certify that I am a Professional Land Surveyor Registered in the State of Utah, and that I hold certificate No. 8213, as prescribed under the laws of the State of Utah. I further certify that by authority of June Heiser the Owner, I have made a survey of lot 21, Donita #4 Sub. shown in this drawing, and that same has been surveyed and stake on the ground as shown in this drawing.

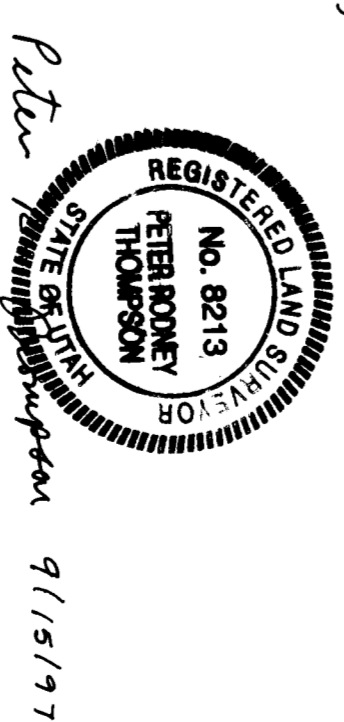

NARRATIVE

The basis of bearing for this survey was the existing monument at the intersection as shown and the PK nail found at the PC of the curve in the centerline of the road. The survey was requested to determine the property line between lot 21 Donita #4 Subdivision, as recorded in the Weber County, Utah Records Office and the lot to the North so that a fence could be placed on the property line to replace an existing fence that fell over.

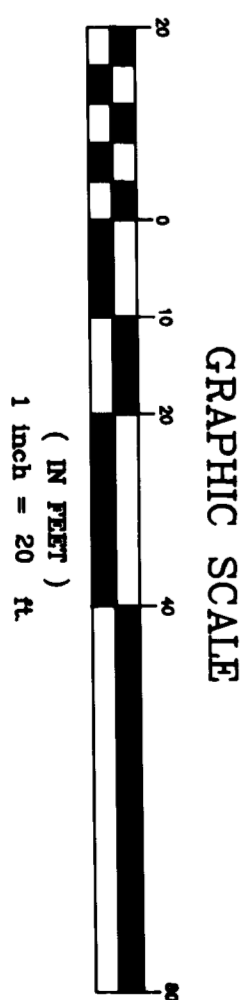

RECEIVED  
SEP 1 9 1997  
WEBER COUNTY SURVEYOR

PART OF THE NW 1/4 OF Sec. 14, T44N, R2W, S488M  
Surveyed by Peter R. Thompson, P.S. 482 County Club Stonebury Park Utah 84074  
(801) 882-3751