
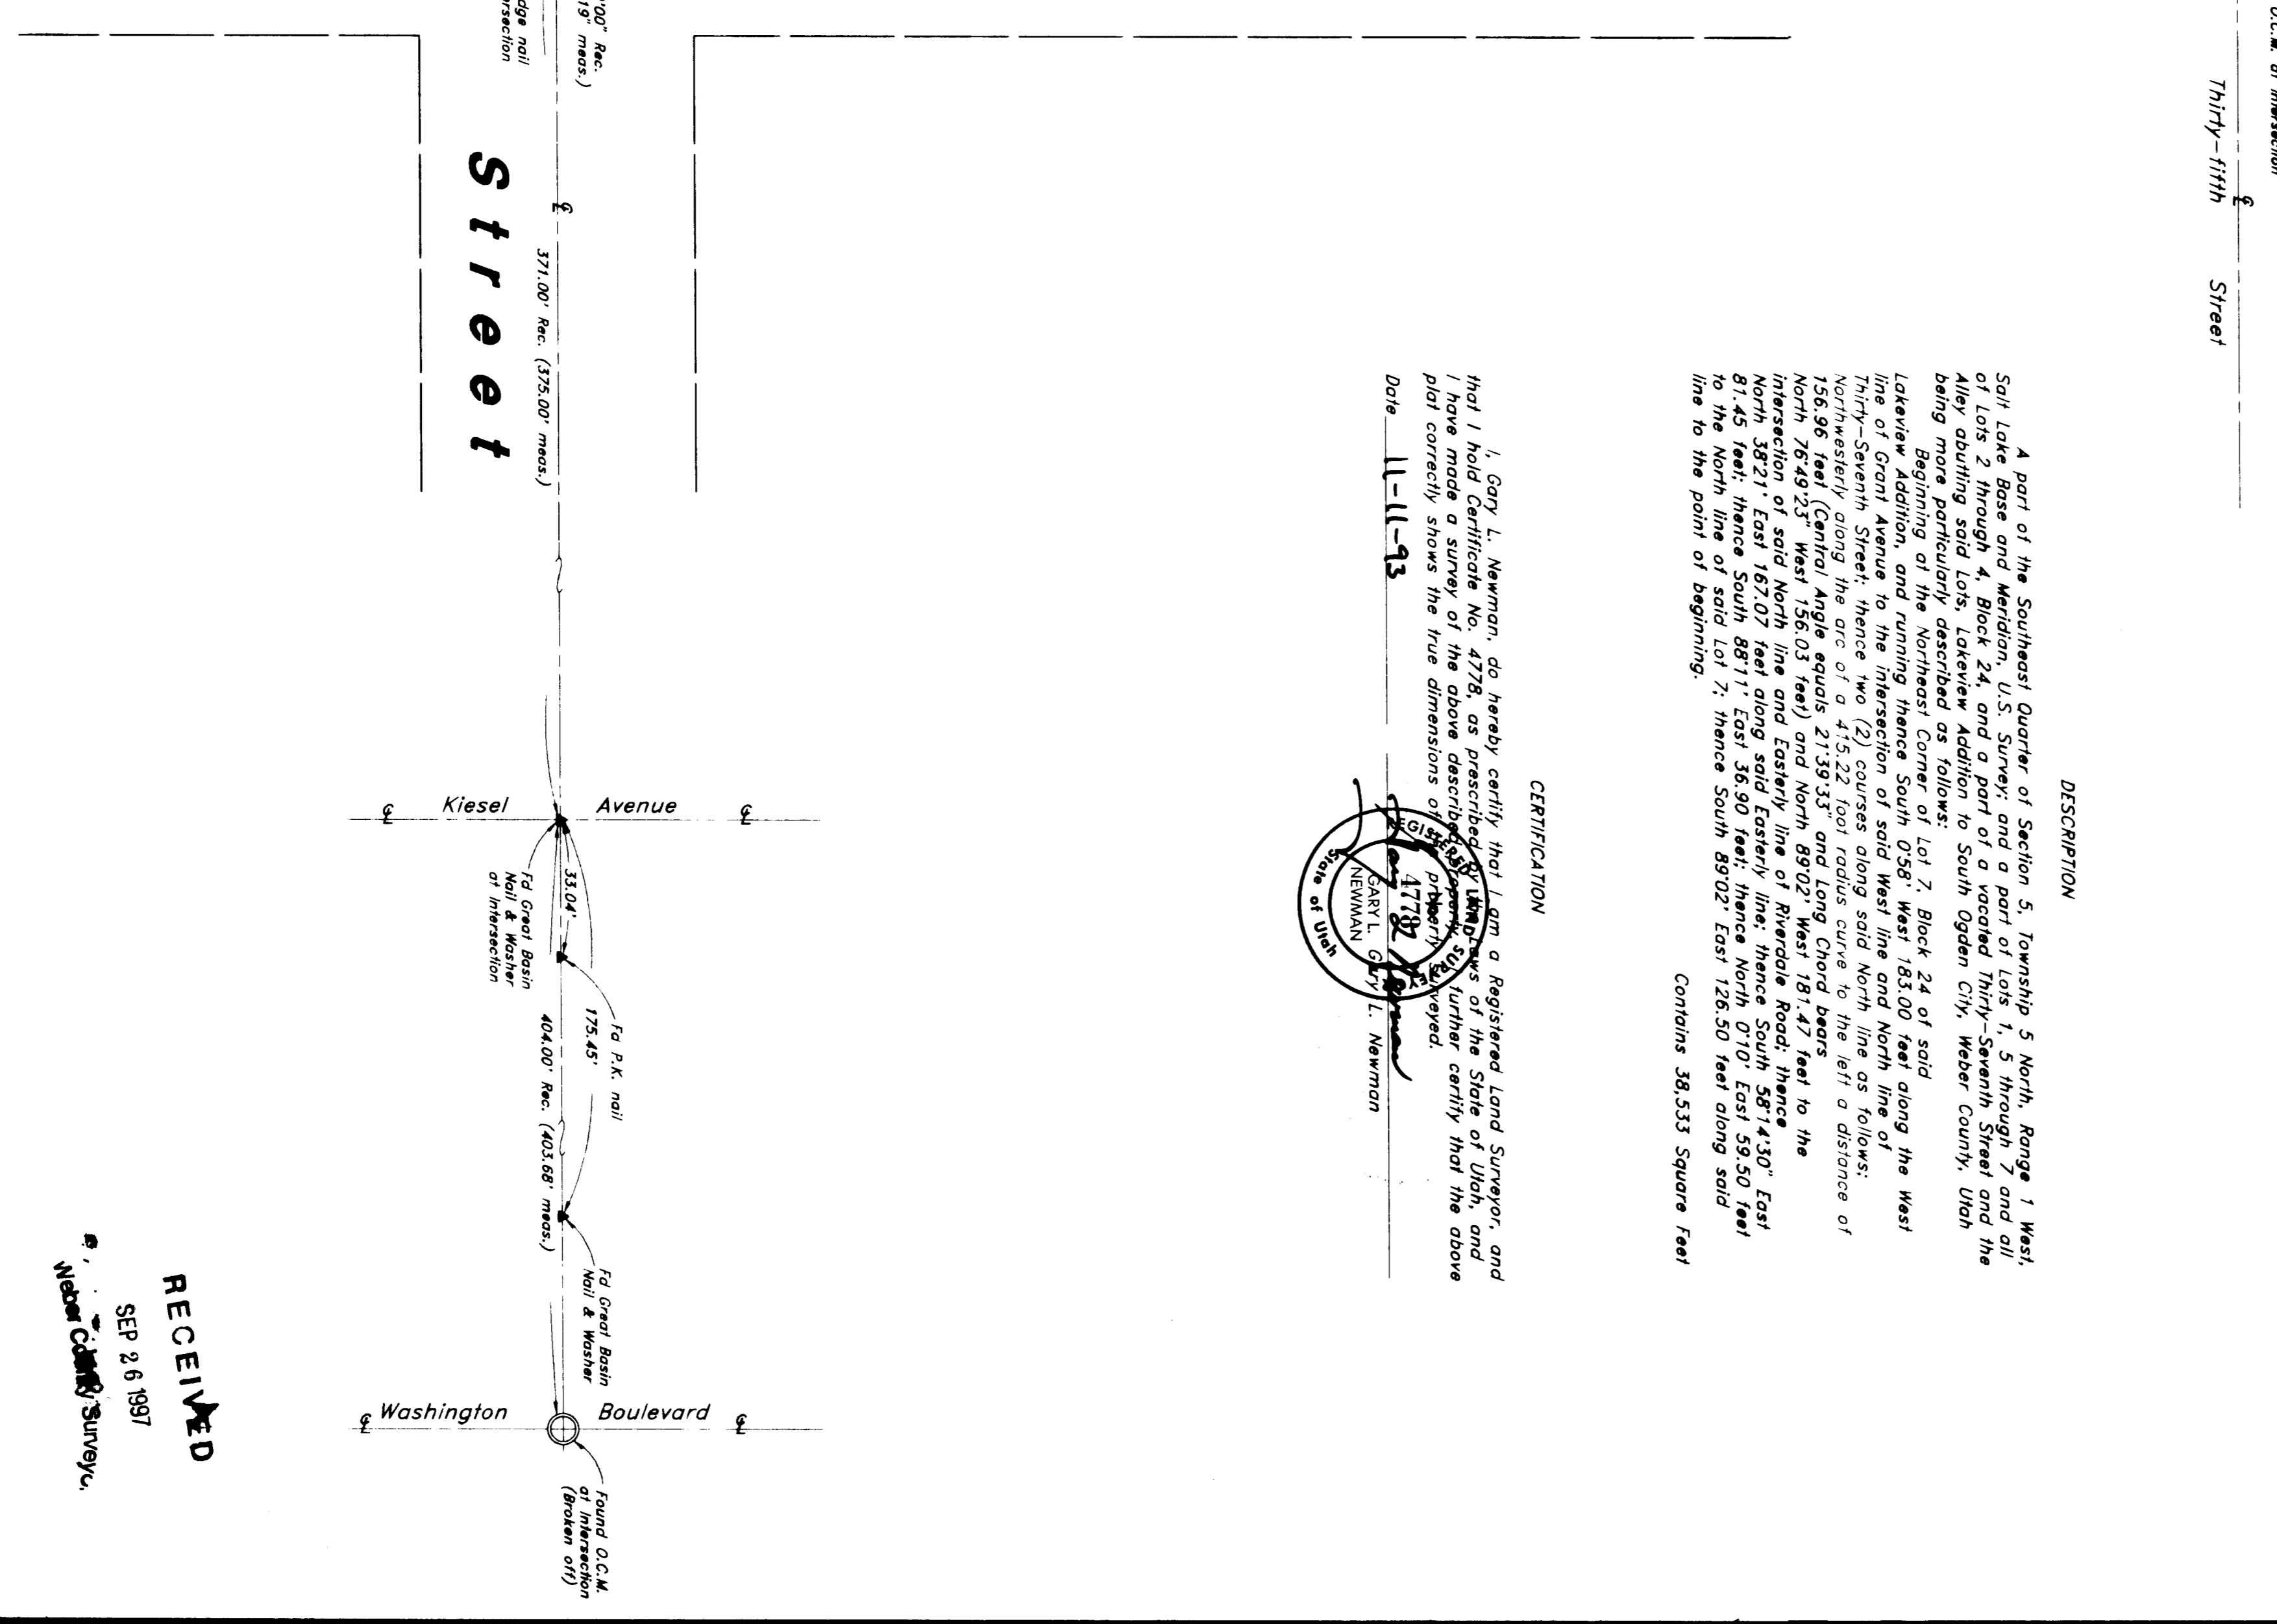


Scale: 1" = 30'

MAPS:

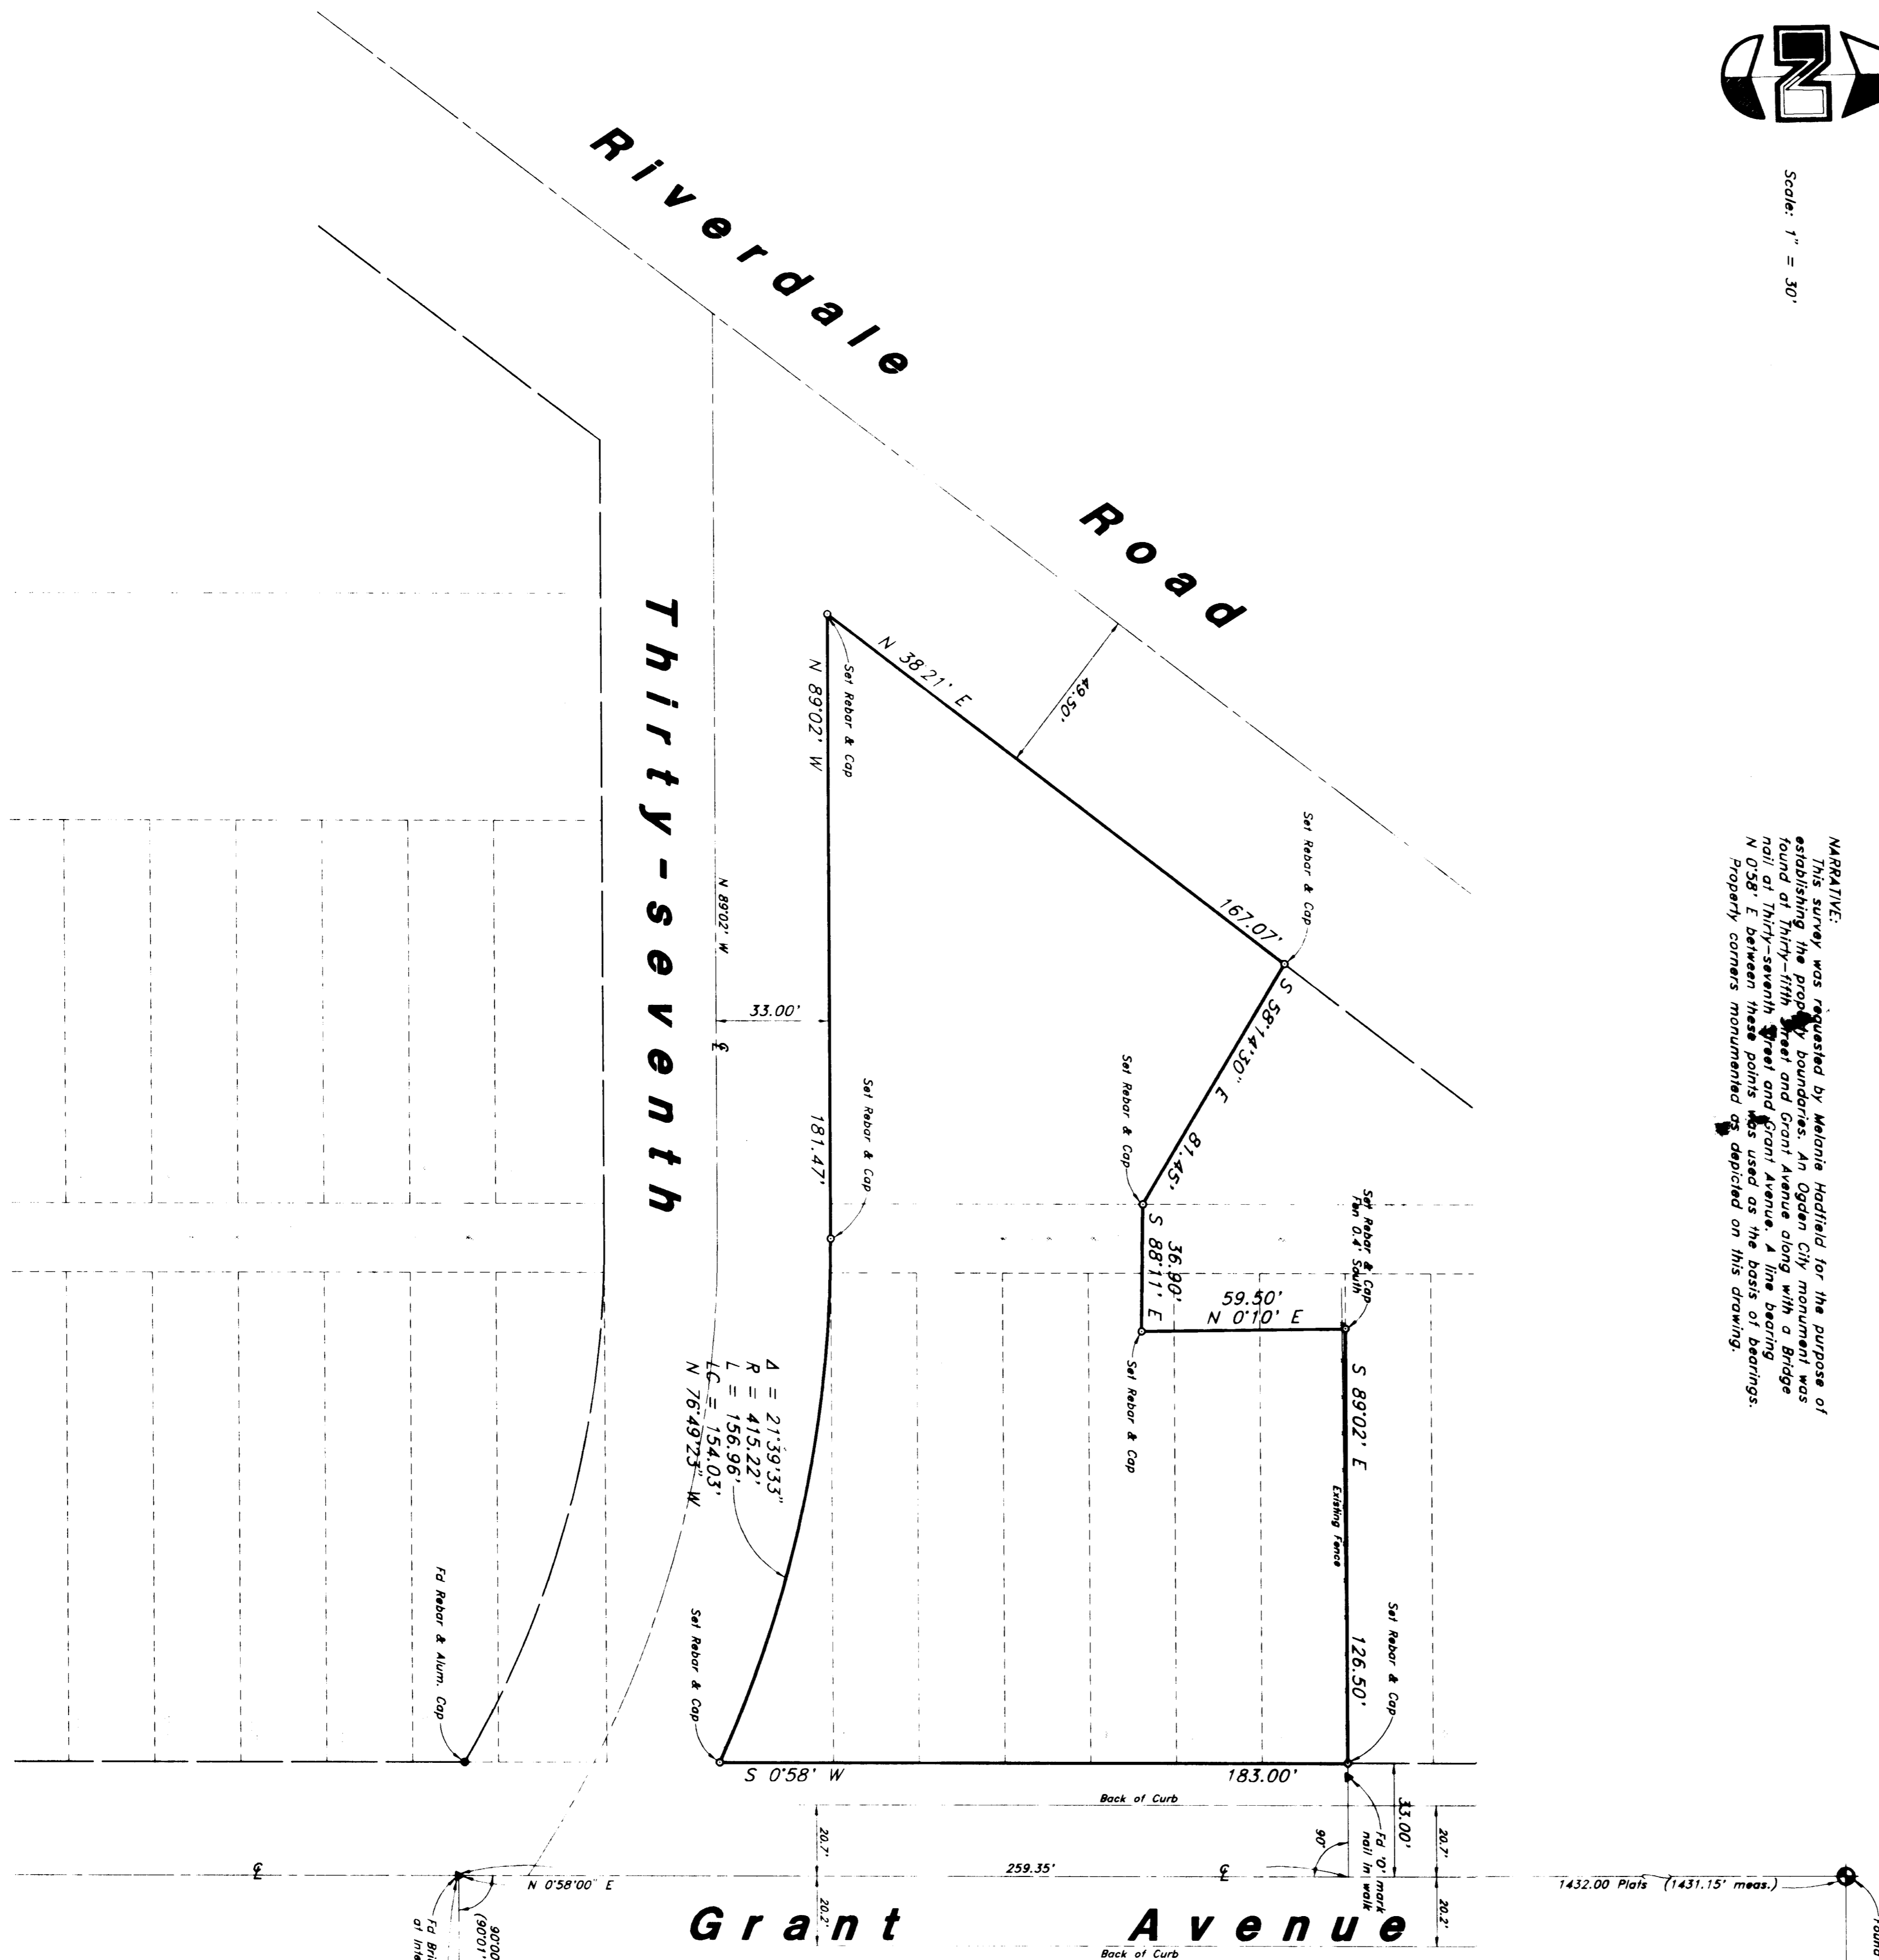

DESCRIPTION

Contains 38,533 Square Feet

CERTIFICATION
Date 11-11-93
GARY L. NEWMAN
REGISTERED LAND SURVEYOR
UTAH

RECEIVED
SEP 26 1997

Property Survey
GREAT BASIN ENGINEERING, INC.
3140 Van Buren Avenue
Ogden, Utah 84401
Scale: 1" = 30'
DATE: 11 Nov., 1993
PS-93-91