

WEBER COUNTY SCHOOL DISTRICT

CORPORATION OF THE PRESIDENT BISHOP OF THE CHURCH OF
JESUS CHRIST OF LATTER DAY SAINTS

LOT 5
REPLANT OF PLYONS PL. ACC.
(2.4 acre approx.)

300.00'

396' (396.56' average)

WEST STREET

5200 South Street
Rt. Roy City
Mojave


5800 South Street
Rt. Roy City
Mojave

PROPERTY DESCRIPTION

PART OF THE SOUTHWEST QUARTER OF SECTION 14, TOWNSHIP 5 NORTH, RANGE 120 EAST, AND 30 FEET WEST OF THE SOUTHWEST CORNER OF THE SOUTHWEST QUARTER OF SAID QUARTER SECTION, ON THE WEST LINE OF 2100 WEST STREET, BEING 300 FEET TO THE WEST SIDE OF SAID 2100 WEST STREET, THENCE SOUTH ALONG THE WESTERNLY SIDE OF SAID STREET, 396 FEET TO THE POINT OF BEGINNING, BEING 300 FEET TO THE WEST SIDE OF SAID STREET, A HIGH-CORNER WITH THE MORE OR LESS OF STILL EXISTENT.


I, Gary L. Neman, do hereby certify that I am a Registered Land Surveyor, and that I hold Certificate No. 4738, as prescribed by the Laws of the State of Utah, and I have made a survey of the North line of the above described property. I further certify that the above data correctly shows the true dimensions of the property surveyed.

Date: NOV-27-88 *Gary L. Neman*
Gary L. Neman

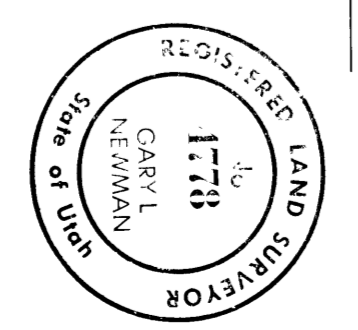

NARRATIVE

This survey was requested by Mr. George Stark for the Roy Utah Stake, 4th and 5th Wards of the Church of Jesus Christ of Latter Day Saints to stake the North line of their property and locate existing sections of 5600 South Street and 2100 West Street (representing a point 49.50 feet North of the Northeast Corner of the Northwest Quarter of the Southeast Quarter of Section 14). A bearing survey was run from the Northeast Corner of the Northwest Quarter of the Southeast Quarter of Section 14, a bearing of 0.56 feet was measured through the quarter section which was placed entirely in the church property due to (1) a survey to the North and (2) a survey to the South for the Weber County School District. The survey was performed by Great Basin Engineering, Inc., (JOB NO. PB-79-188) which uses a total station and shows no claim to any portion of the overage. Only North line was staked, placing a 44 Rebar 24 inches in length with a Great Basin Cap at each corner.

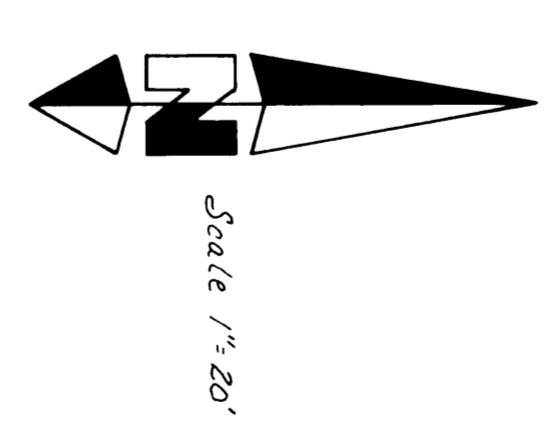

RECEIVED
NOV 11 1988
Weber County Survey

GREAT BASIN ENGINEERING, INC.
CONSULTING ENGINEERS & SURVEYORS
ODDEN & SALT LAKE CITY, UTAH

Property Survey

Roy Utah Stake, 4th and 5th Wards

2 Ward of the 4th and 5th of Section 14, Township 5 North, Range 120 East

Date: NOV-27-88 Scale: 1"=20'

Drawn by: [Signature] Date: NOV-27-88

Checked by: [Signature] Date: NOV-27-88