

G:\DRAWINGS\SHARED\2662\01-HYDE\KHYDESPV Thu Oct 23 11:30:03 1997 JAE

REVISIONS

1.		4.
2.		5.
3.		6.



PROJECT NO. 288E-211 SURVEYOR: R. BULLARD  
DATE: 7-2-97 DRAWN: JAC  
SCALE: 1"=40' CHECKED:

**REEVE & ASSOCIATES, INC.**  
ENGINEERS PLANNERS & SURVEYORS  

**RECORD OF SURVEY**

**HYDE & PERRY PROPERTIES**  

SHEET 1 OF 1 SHEETS

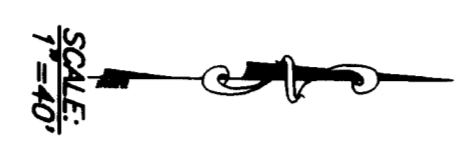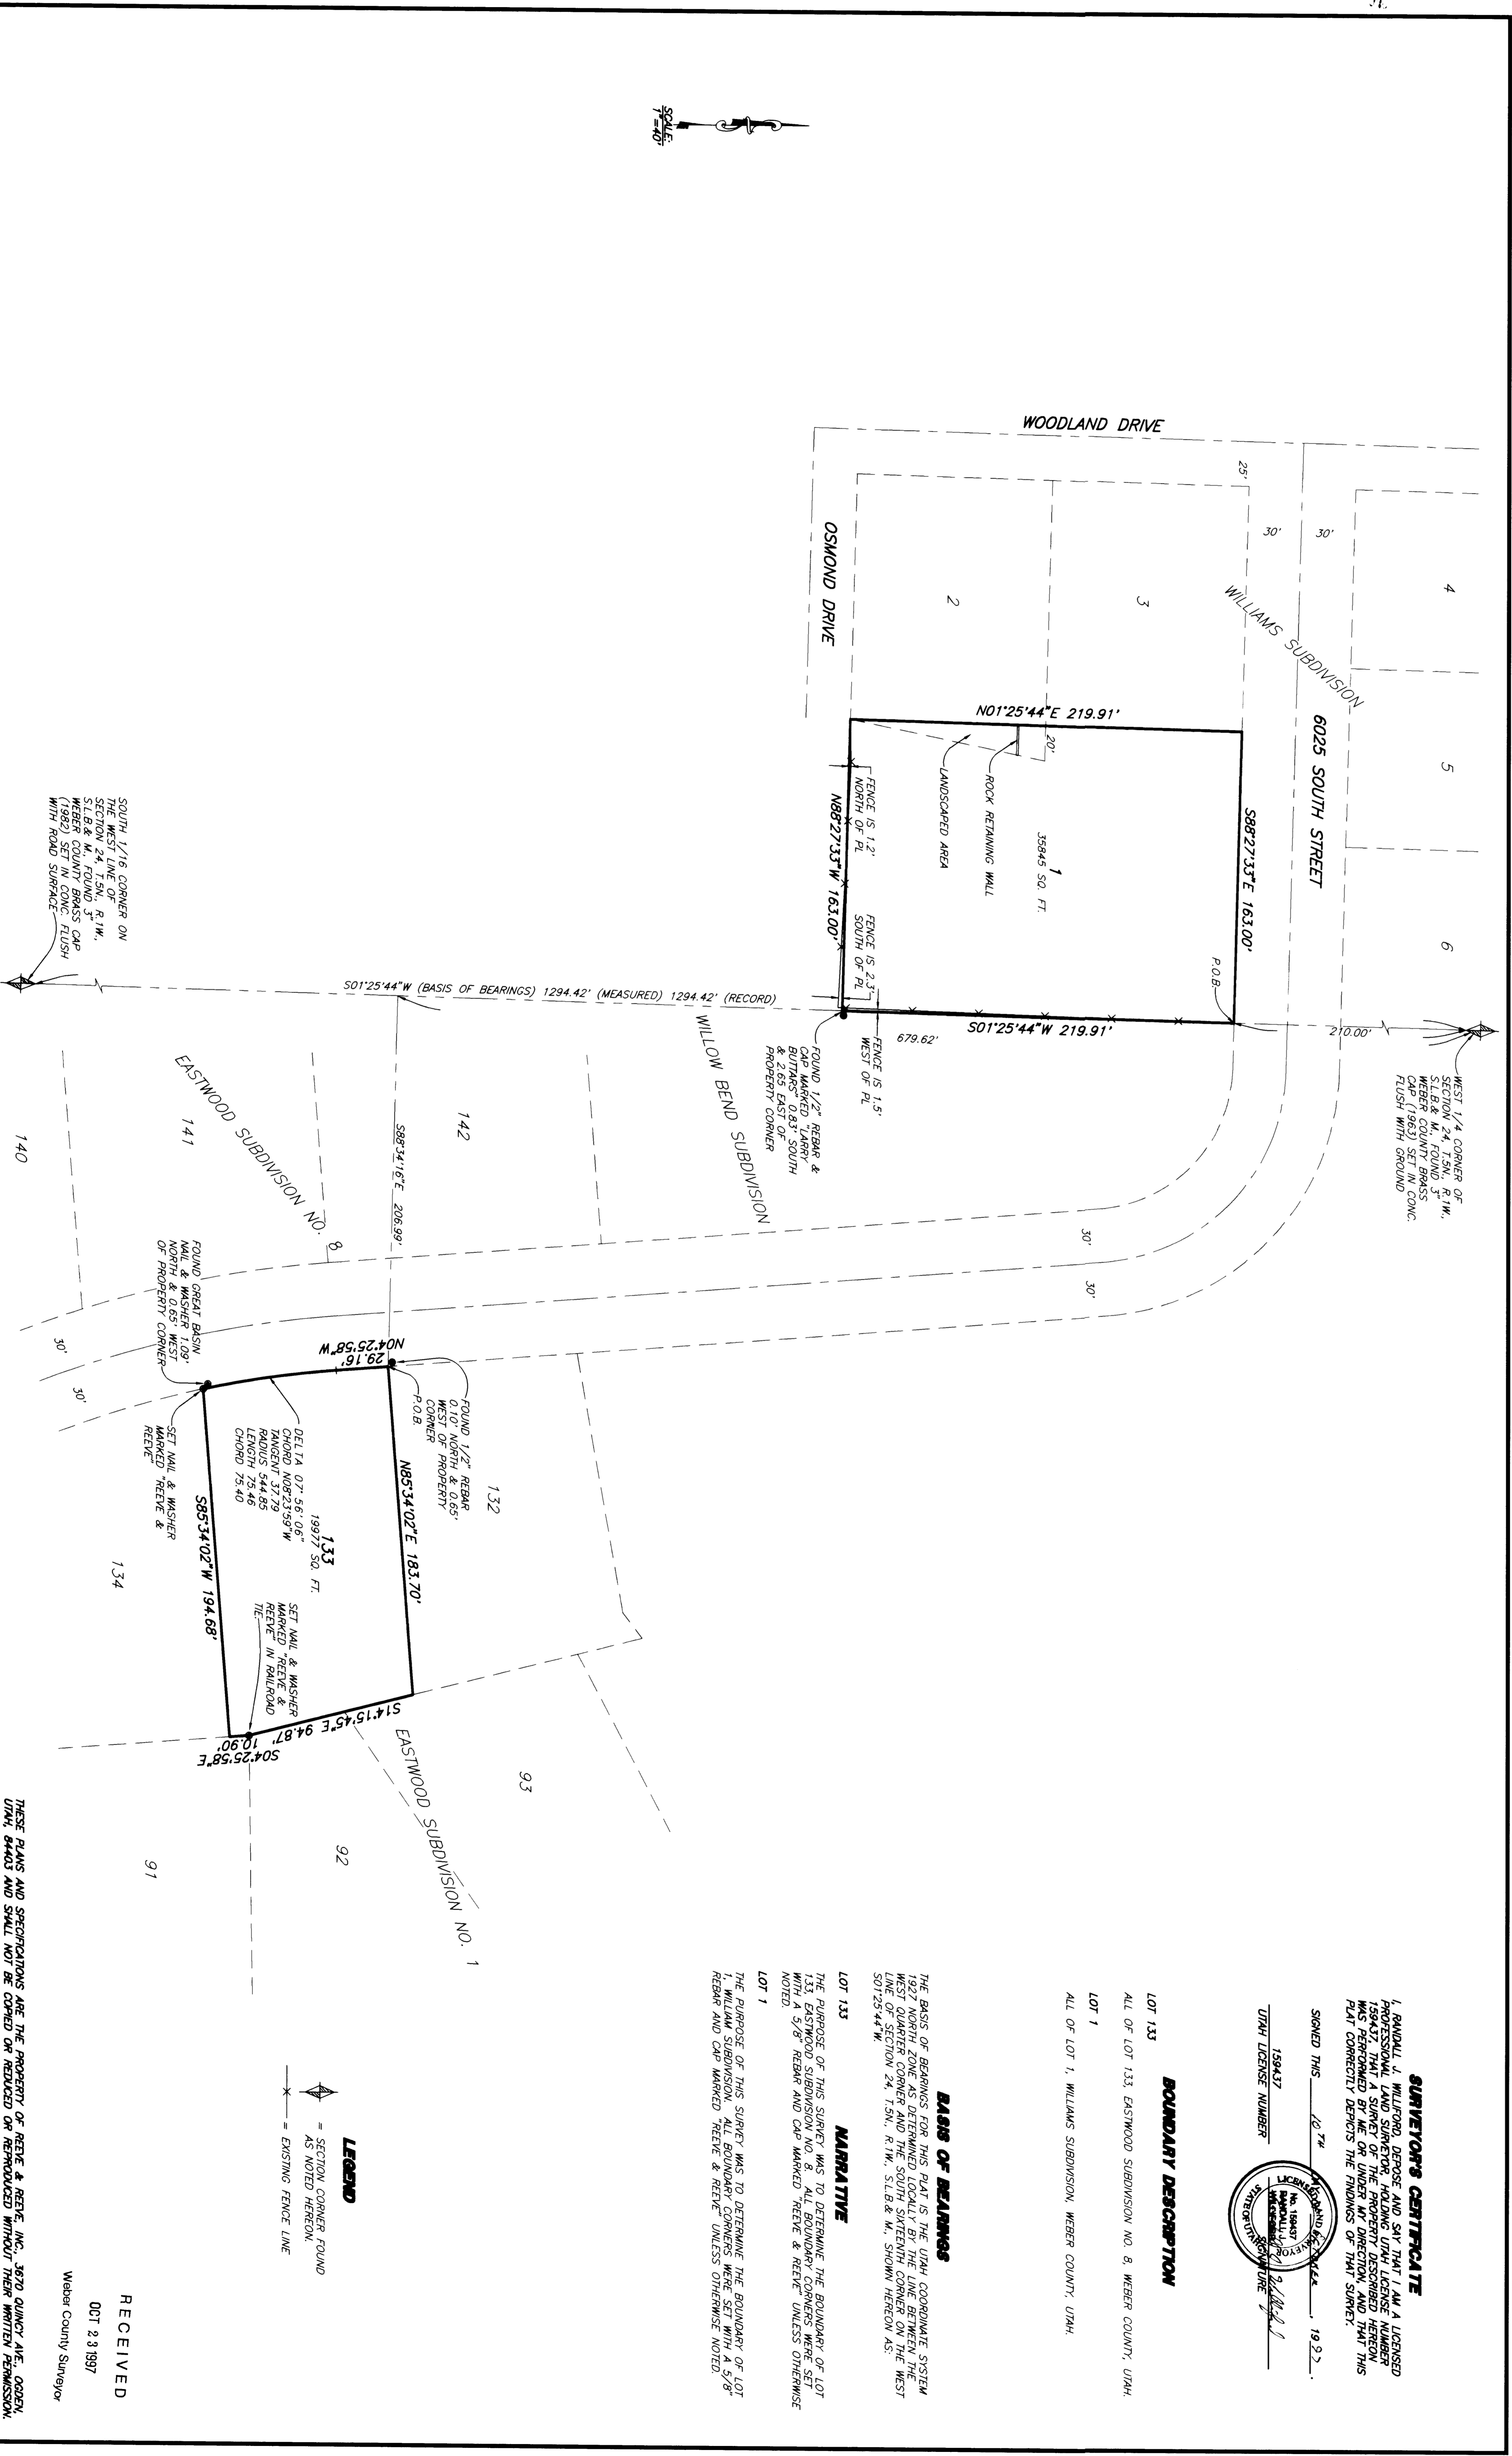






**LEGEND**  
- S SURVEY CORNER FOUND  
- AS NOTED HEREON  
- EXISTING FENCE LINE

**BASES OF BEARINGS**  

**NARRATIVE**  
THE PURPOSE OF THIS SURVEY WAS TO DETERMINE THE BOUNDARY OF LOT 133 EASTWOOD SUBDIVISION NO. 8. ALL BOUNDARY CORNERS WERE SET WITH 5/8\"/>

**BOUNDARY DESCRIPTION**  
LOT 133 ALL OF LOT 133, EASTWOOD SUBDIVISION NO. 8, WEBER COUNTY, UTAH.  
LOT 1 ALL OF LOT 1, WILLIAMS SUBDIVISION, WEBER COUNTY, UTAH.

**SURVEYOR'S CERTIFICATE**  
SIGNED THIS 10<sup>TH</sup> DAY OF SEPTEMBER, 1997.  
UTAH LICENSE NUMBER

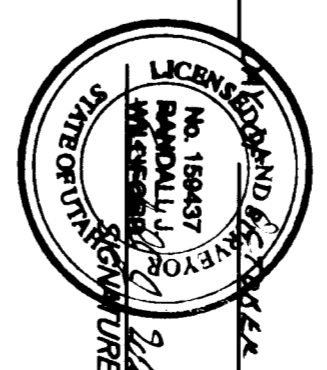

RECEIVED  
OCT 2 9 1997  
Weber County Surveyor