

1	REVISION
2	REVISION
3	REVISION
4	REVISION


PROJECT NO. _____
DATE: _____
SCALE: _____

REEVE & REEVE, INC.
CIVIL AND ENVIRONMENTAL ENGINEERING
LAND PLANNING AND SITE DESIGN
LAND SURVEYING
ODDEN, UTAH

RECORD OF SURVEY

SCOTT & JULIE DIXON
PROPERTY

SHEET 1 OF 1 SHEETS

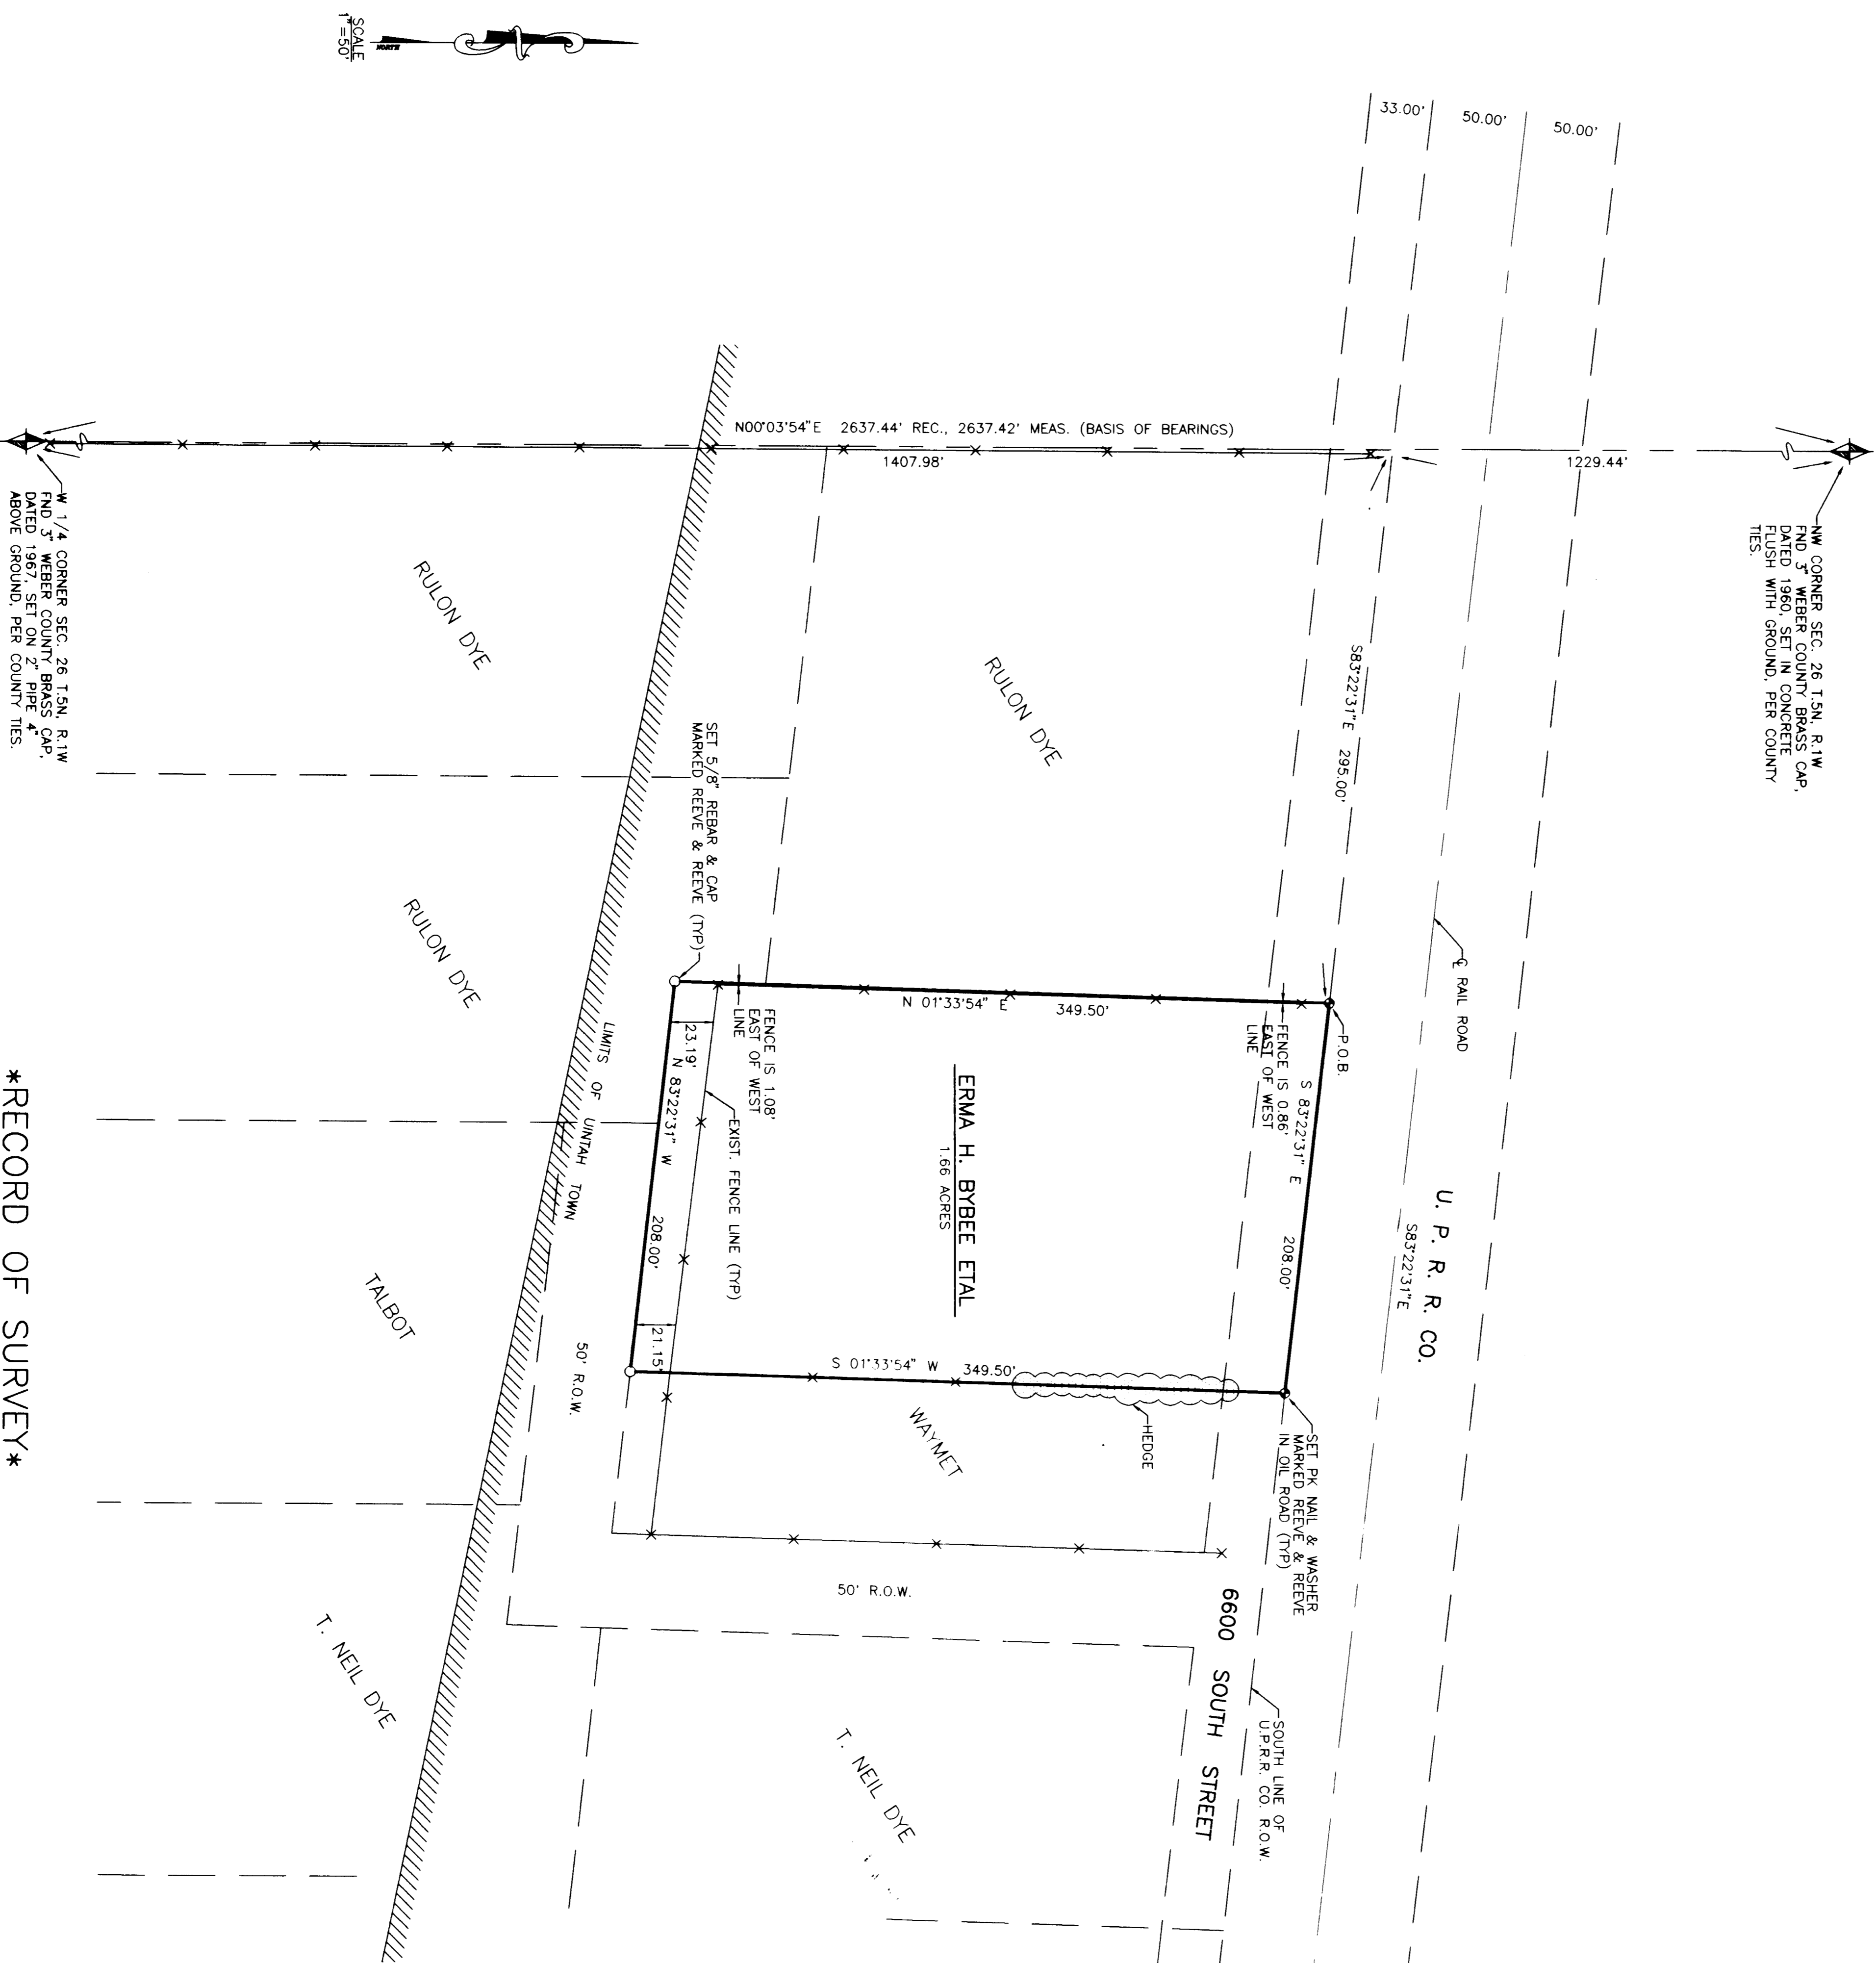

RECORD OF SURVEY

SURVEYOR'S CERTIFICATE

I, JOHN P. REEVE, UTAH REGISTERED LAND SURVEYOR NO. 3499, DO HEREBY CERTIFY THAT THIS PLAT WAS PREPARED FROM A SURVEY MADE BY ME OR UNDER MY SUPERVISION, ON THE GROUND AT THE REQUEST OF AND EXCLUSIVELY FOR THE CLIENT, AND THAT I AM A LICENSED SURVEYOR IN THE STATE OF UTAH AND I STRIVE AND CORRECT TO THE BEST OF MY KNOWLEDGE AND BELIEF.

SIGNED THIS 6 DAY OF FEBRUARY 2001

22-146666-2201
UTAH LICENSE NUMBER
SIGNATURE

NARRATIVE

THE PURPOSE OF THIS SURVEY WAS TO VERIFY THE BOUNDARIES OF THIS PARCEL AND TO SET A FENCE LINE ALONG THE SOUTH BOUNDARY OF THE CLIENT. HOWEVER THE SOUTH FENCE HAS BEEN IN PLACE FOR 30 OR MORE YEARS.

BOUNDARY DESCRIPTION



BASIS OF BEARINGS




RECEIVED
OCT 24 1997
Weber County Surveyor