






REEVE & REEVE, INC.
CIVIL AND ENVIRONMENTAL ENGINEERING
LAND SURVEYING
OGDEN, UTAH

RECORD OF SURVEY

WEBER COUNTY
SCHOOL PROPERTY
WASHINGTON TERRACE


| | |
|-----------|---|
| SHEET | 1 |
| OF SHEETS | 1 |

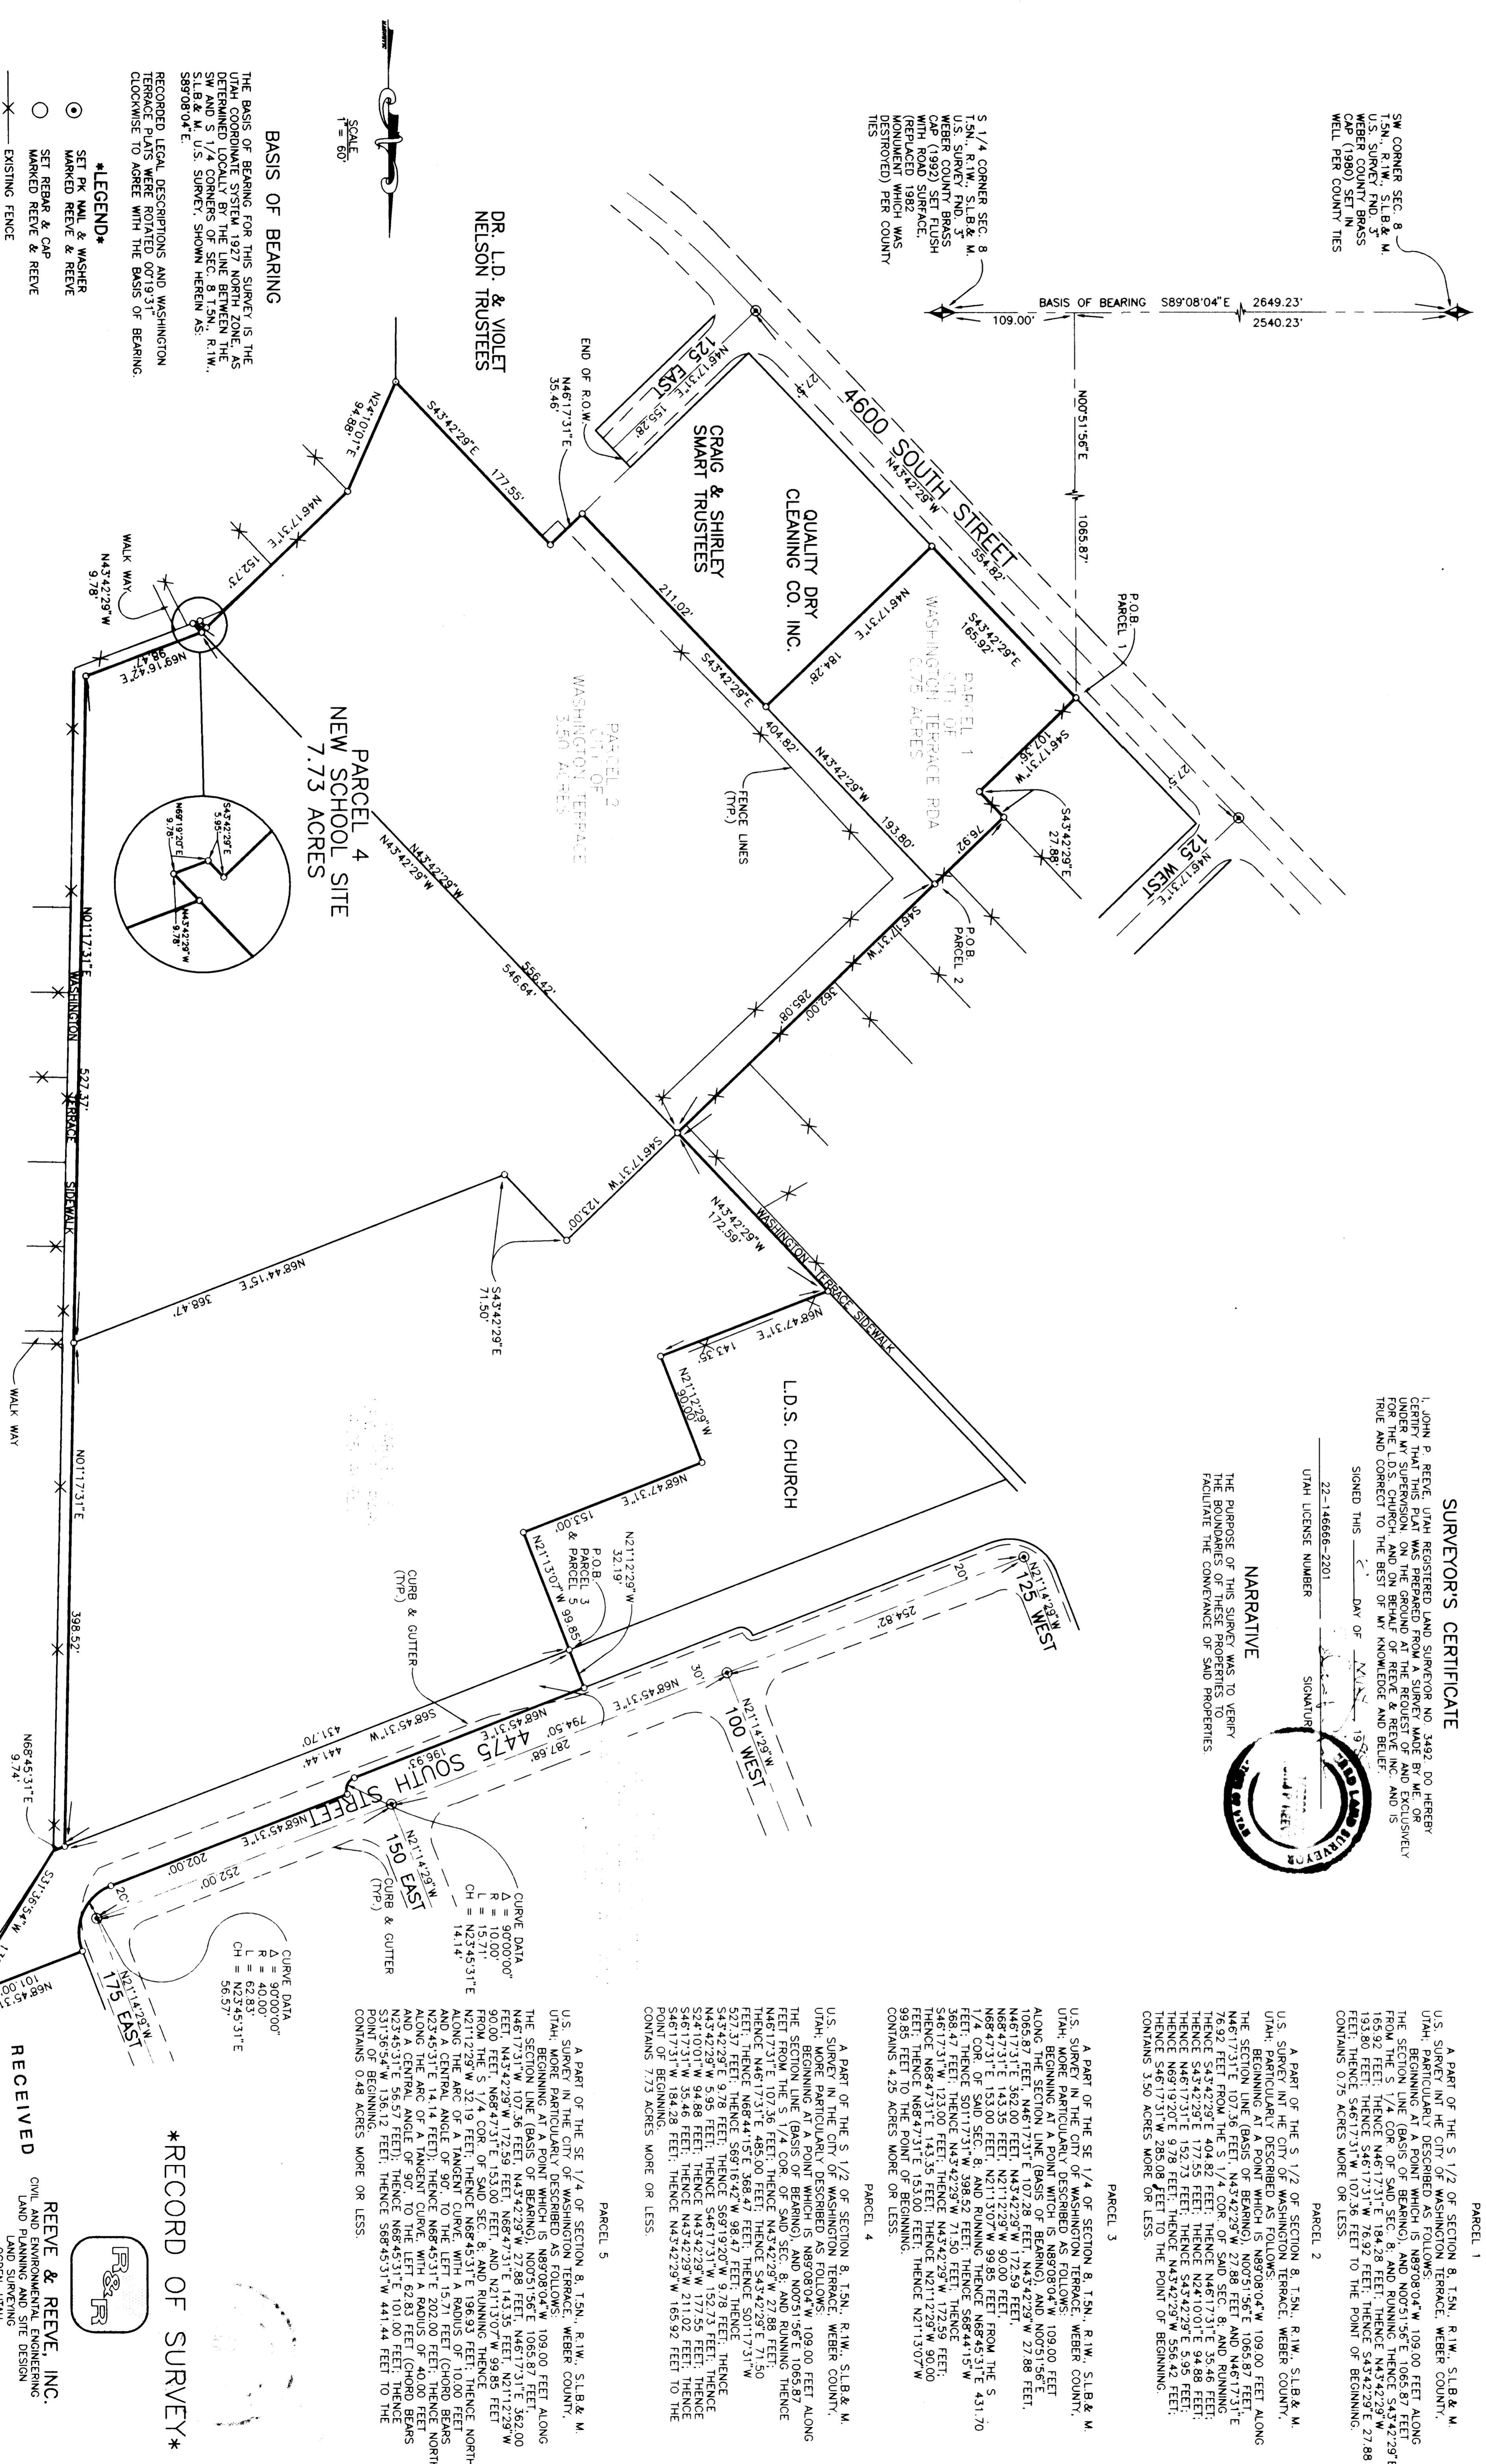

BASIS OF BEARING
THE BASIS OF BEARING FOR THIS SURVEY IS THE UTM COORDINATE SYSTEM 1927 NORTH ZONE, AS DETERMINED LOCALLY BY THE LINE BETWEEN THE S. 1/4 COR. OF SAID SEC. 8 AND THE S. 1/4 COR. OF SAID SEC. 8, U.S. SURVEY SHOWN HEREIN AS S89°08'04"E.

RECORDED LEGAL DESCRIPTIONS AND WASHINGTON TERRACE PLATS WERE ROTATED 0°07'31" CLOCKWISE TO AGREE WITH THE BASIS OF BEARING.


LEGEND
 ○ SET PK W/AL & WASHER
 ○ MARKED REVE & REVE
 ○ SET REBAR & CAP
 ○ MARKED REVE & REVE
 ○ EXISTING FENCE
 --- EXISTING CURB & GUTTER

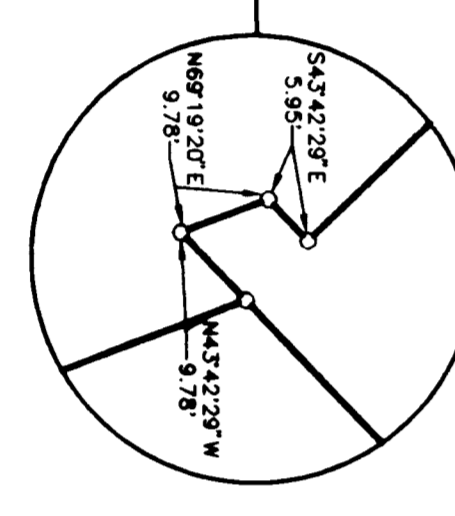

CURVE DATA

RECORD OF SURVEY
 RECEIVED
 001 24 1897
 REEVE & REEVE, INC.
 CIVIL AND ENVIRONMENTAL ENGINEERING
 LAND SURVEYING DESIGN
 OGDEN, UTAH

SURVEYOR'S CERTIFICATE
 JOHN P. REEVE
 UTAH LICENSE NUMBER 22-146668-2201
 SIGNATURE

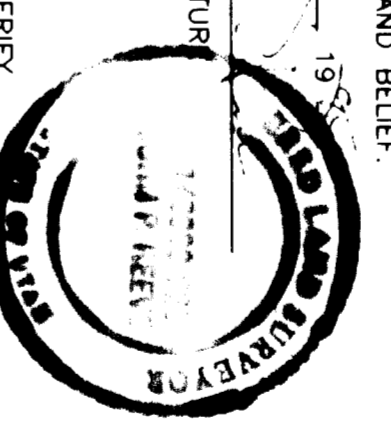

NARRATIVE
 THE PURPOSE OF THIS SURVEY WAS TO DETERMINE THE BOUNDARIES TO PROPERTY TO FACILITATE THE CONVEYANCE OF SAID PROPERTIES.