



1. SURVEY NO.
2. SHEET NO.
3. DATE

PROJECT NO.
DATE
SCALE

DATE
SCALE

REEVE & REEVE, INC.
CIVIL AND ENVIRONMENTAL ENGINEERING
LAND PLANNING AND SITE DESIGN
COTTEN, UTAH

RECORD OF SURVEY

LIGORI'S RESTAURANT



SHEET 1

P.O. SW CORNER SEC. 10,
WEBER COUNTY BRASS
SURFACE (1960)
SURFACE BELOW ROAD

(BASIS OF BEARINGS)
N00°49'46"E 5228.79'
N00°49'46"E 1537.71'

P.O. NW CORNER SEC. 10,
WEBER COUNTY BRASS
SURFACE (1960)
SURFACE BELOW ROAD

HARRISON BOULEVARD

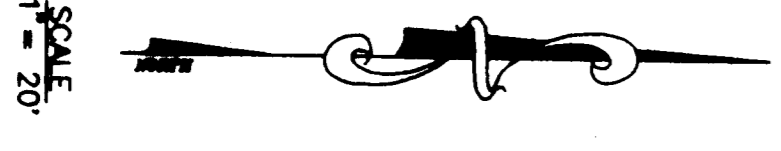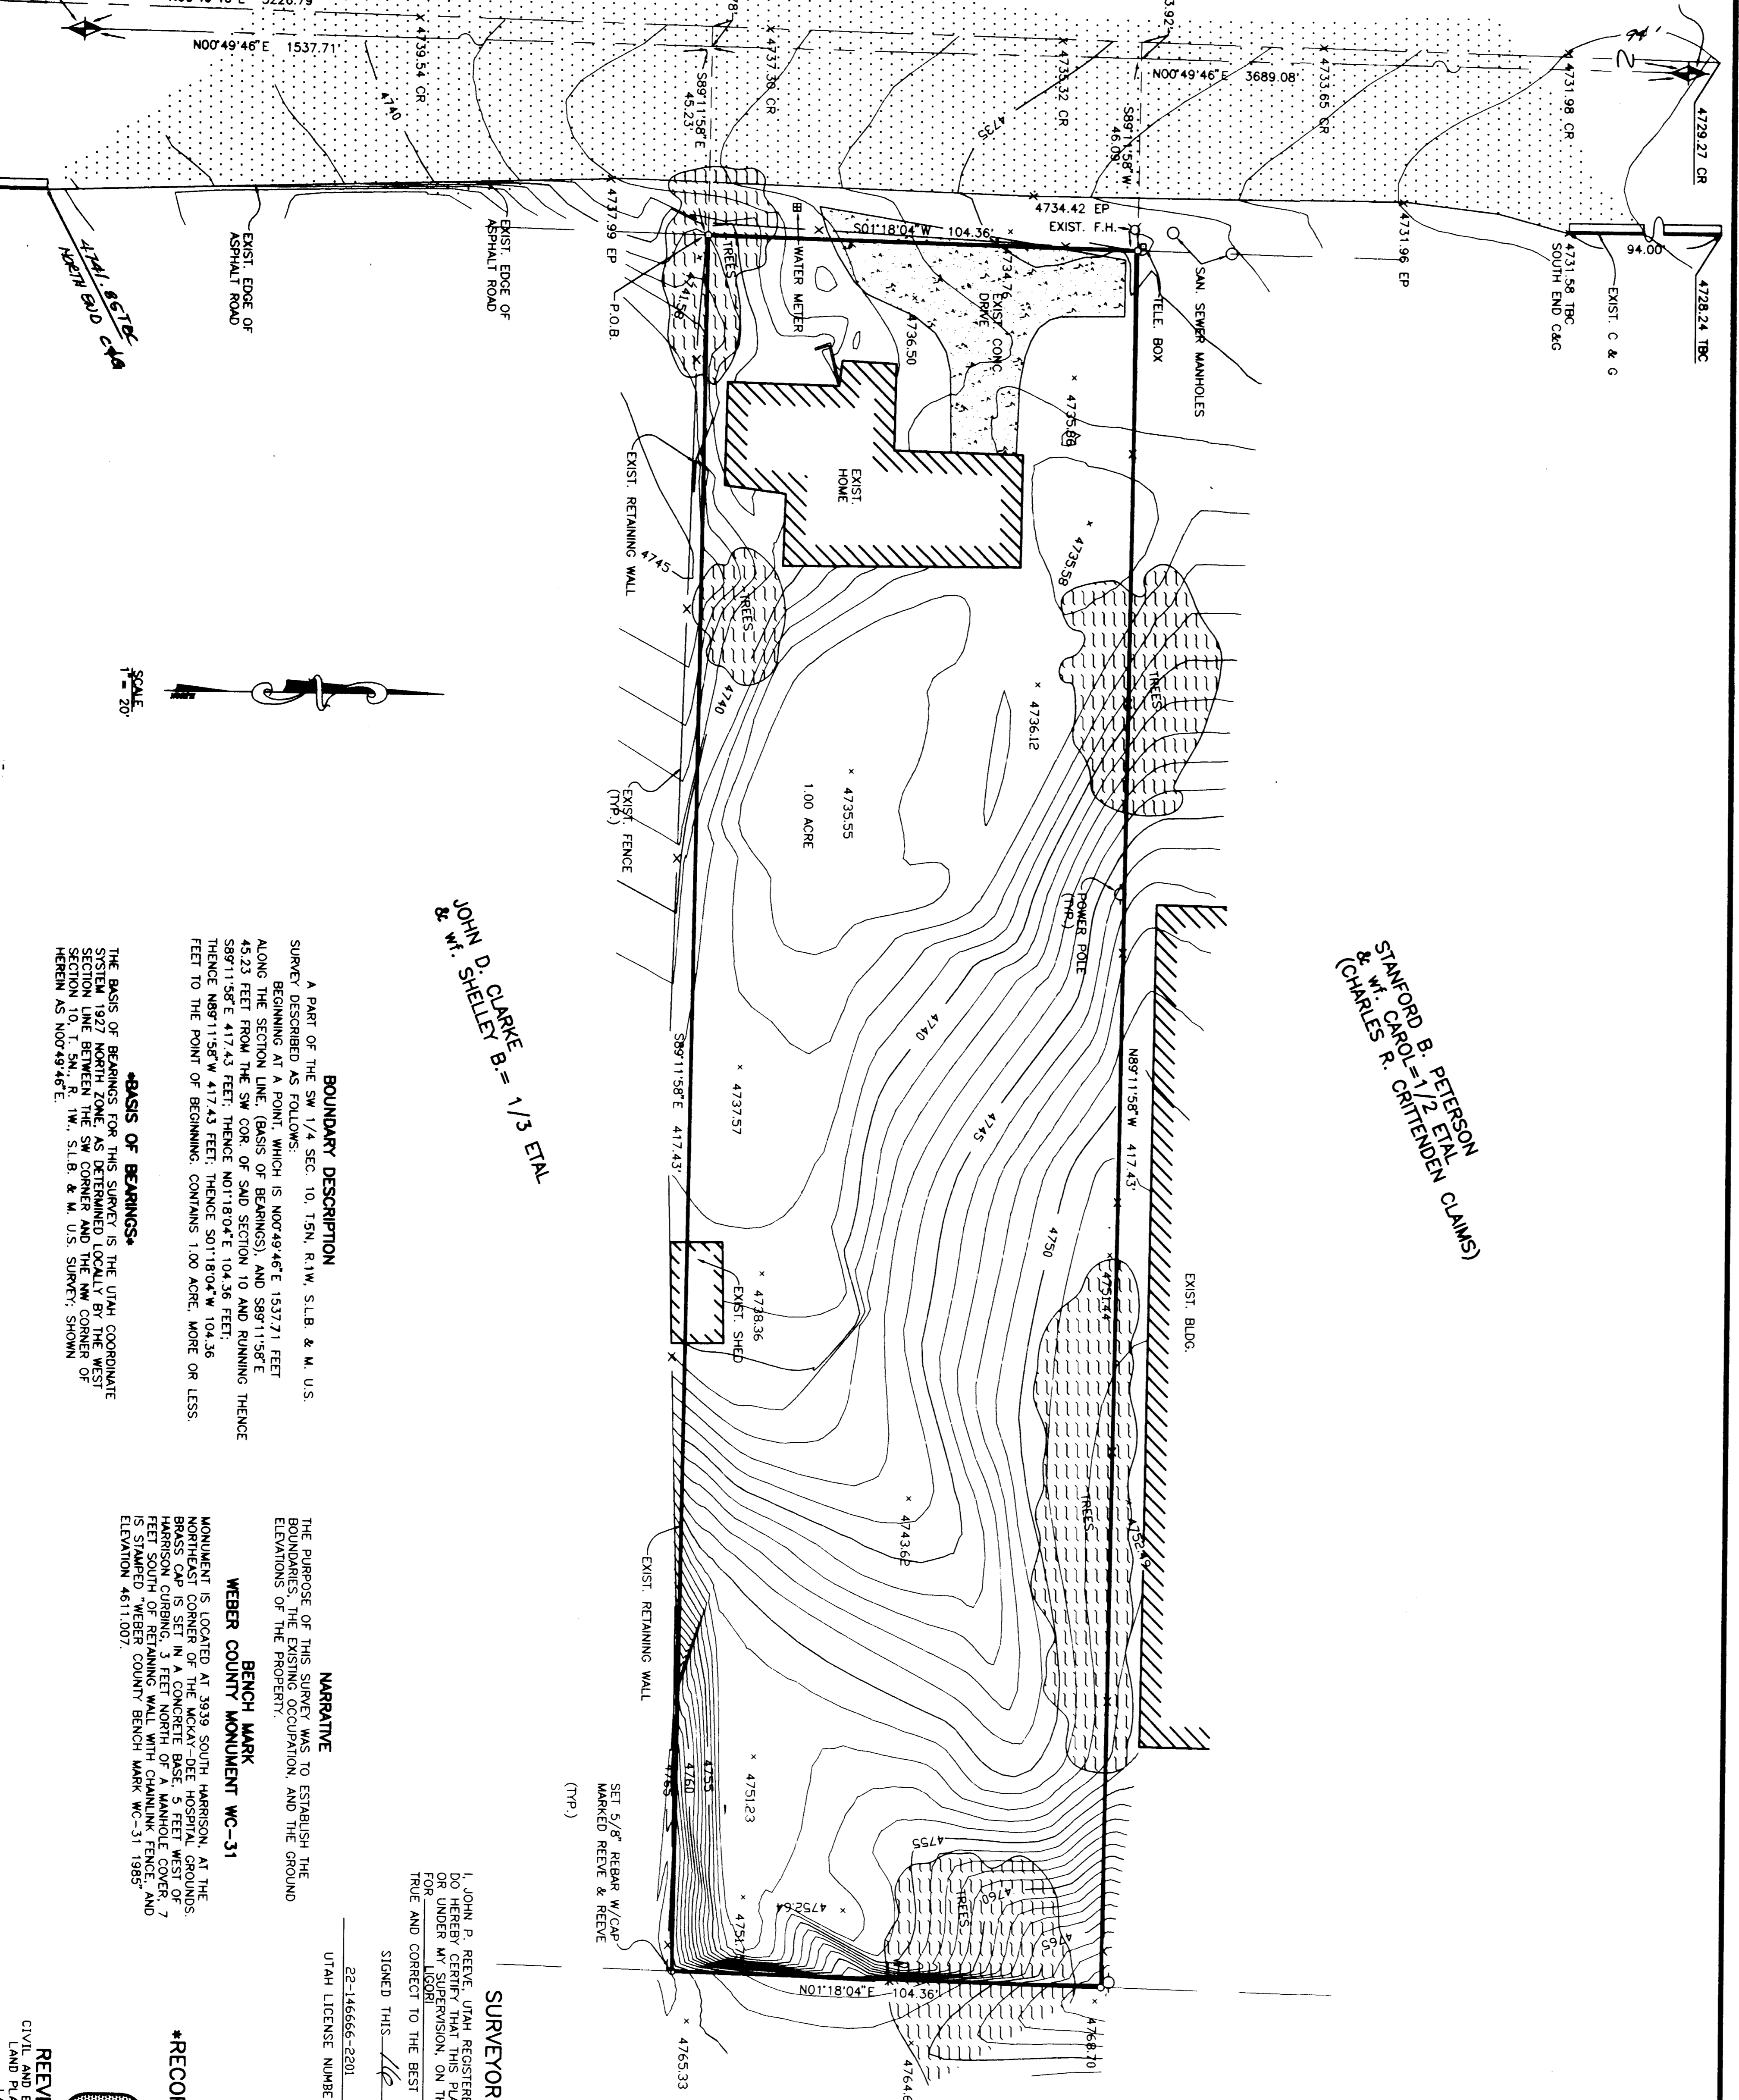

BOUNDARY DESCRIPTION


BASIS OF BEARINGS


NARRATIVE

THE PURPOSE OF THIS SURVEY WAS TO ESTABLISH THE BOUNDARIES, THE EXISTING OCCUPATION, AND THE GROUND ELEVATIONS OF THE PROPERTY.

WEBER COUNTY MONUMENT WC-31

MONUMENT IS LOCATED AT 3039 SOUTH HARRISON, AT THE NORTHEAST CORNER OF THE CONCRETE BASE, 5 FEET WEST OF HARRISON CURBING, 3 FEET NORTH OF A MANHOLE COVER, AND IS STAMPED "WEBER COUNTY BENCH MARK WC-31 1985" ELEVATION 4611.007.


STANFORD B. PETERSON
& W. CAROL = 1/2 ETAL
(CHARLES R. CRITTENDEN CLAIMS)

SURVEYOR'S CERTIFICATE


UTAH LICENSE NUMBER 22-146666-2201

RECORD OF SURVEY

RECEIVED
001 2 4 1997
REEVE & REEVE, INC.
CIVIL AND ENVIRONMENTAL ENGINEERING
LAND PLANNING AND SITE DESIGN
COTTEN, UTAH
Webster County Surveyor

