



1	DATE	1/28/13	COMPILED	DATE	1/28/13
2	SCALE	1" = 40'	APPROVED	DATE	1/28/13

PROJECT NO.	13B-13	DATE	1/28/13	
SCALE	1" = 40'	APPROVED	DATE	1/28/13


REEVE & REEVE, INC.  
CIVIL AND ENVIRONMENTAL ENGINEERING  
LAND PLANNING AND SITE DESIGN  
ODDEN, UTAH

RECORD OF SURVEY


DAN NIXON  
PROPERTY

SHEET 1  
SHEETS 1

\*RECORD OF SURVEY\*

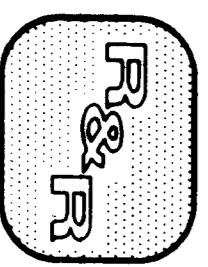

REEVE & REEVE, INC.  
CIVIL AND ENVIRONMENTAL ENGINEERING  
LAND PLANNING AND SITE DESIGN  
ODDEN, UTAH

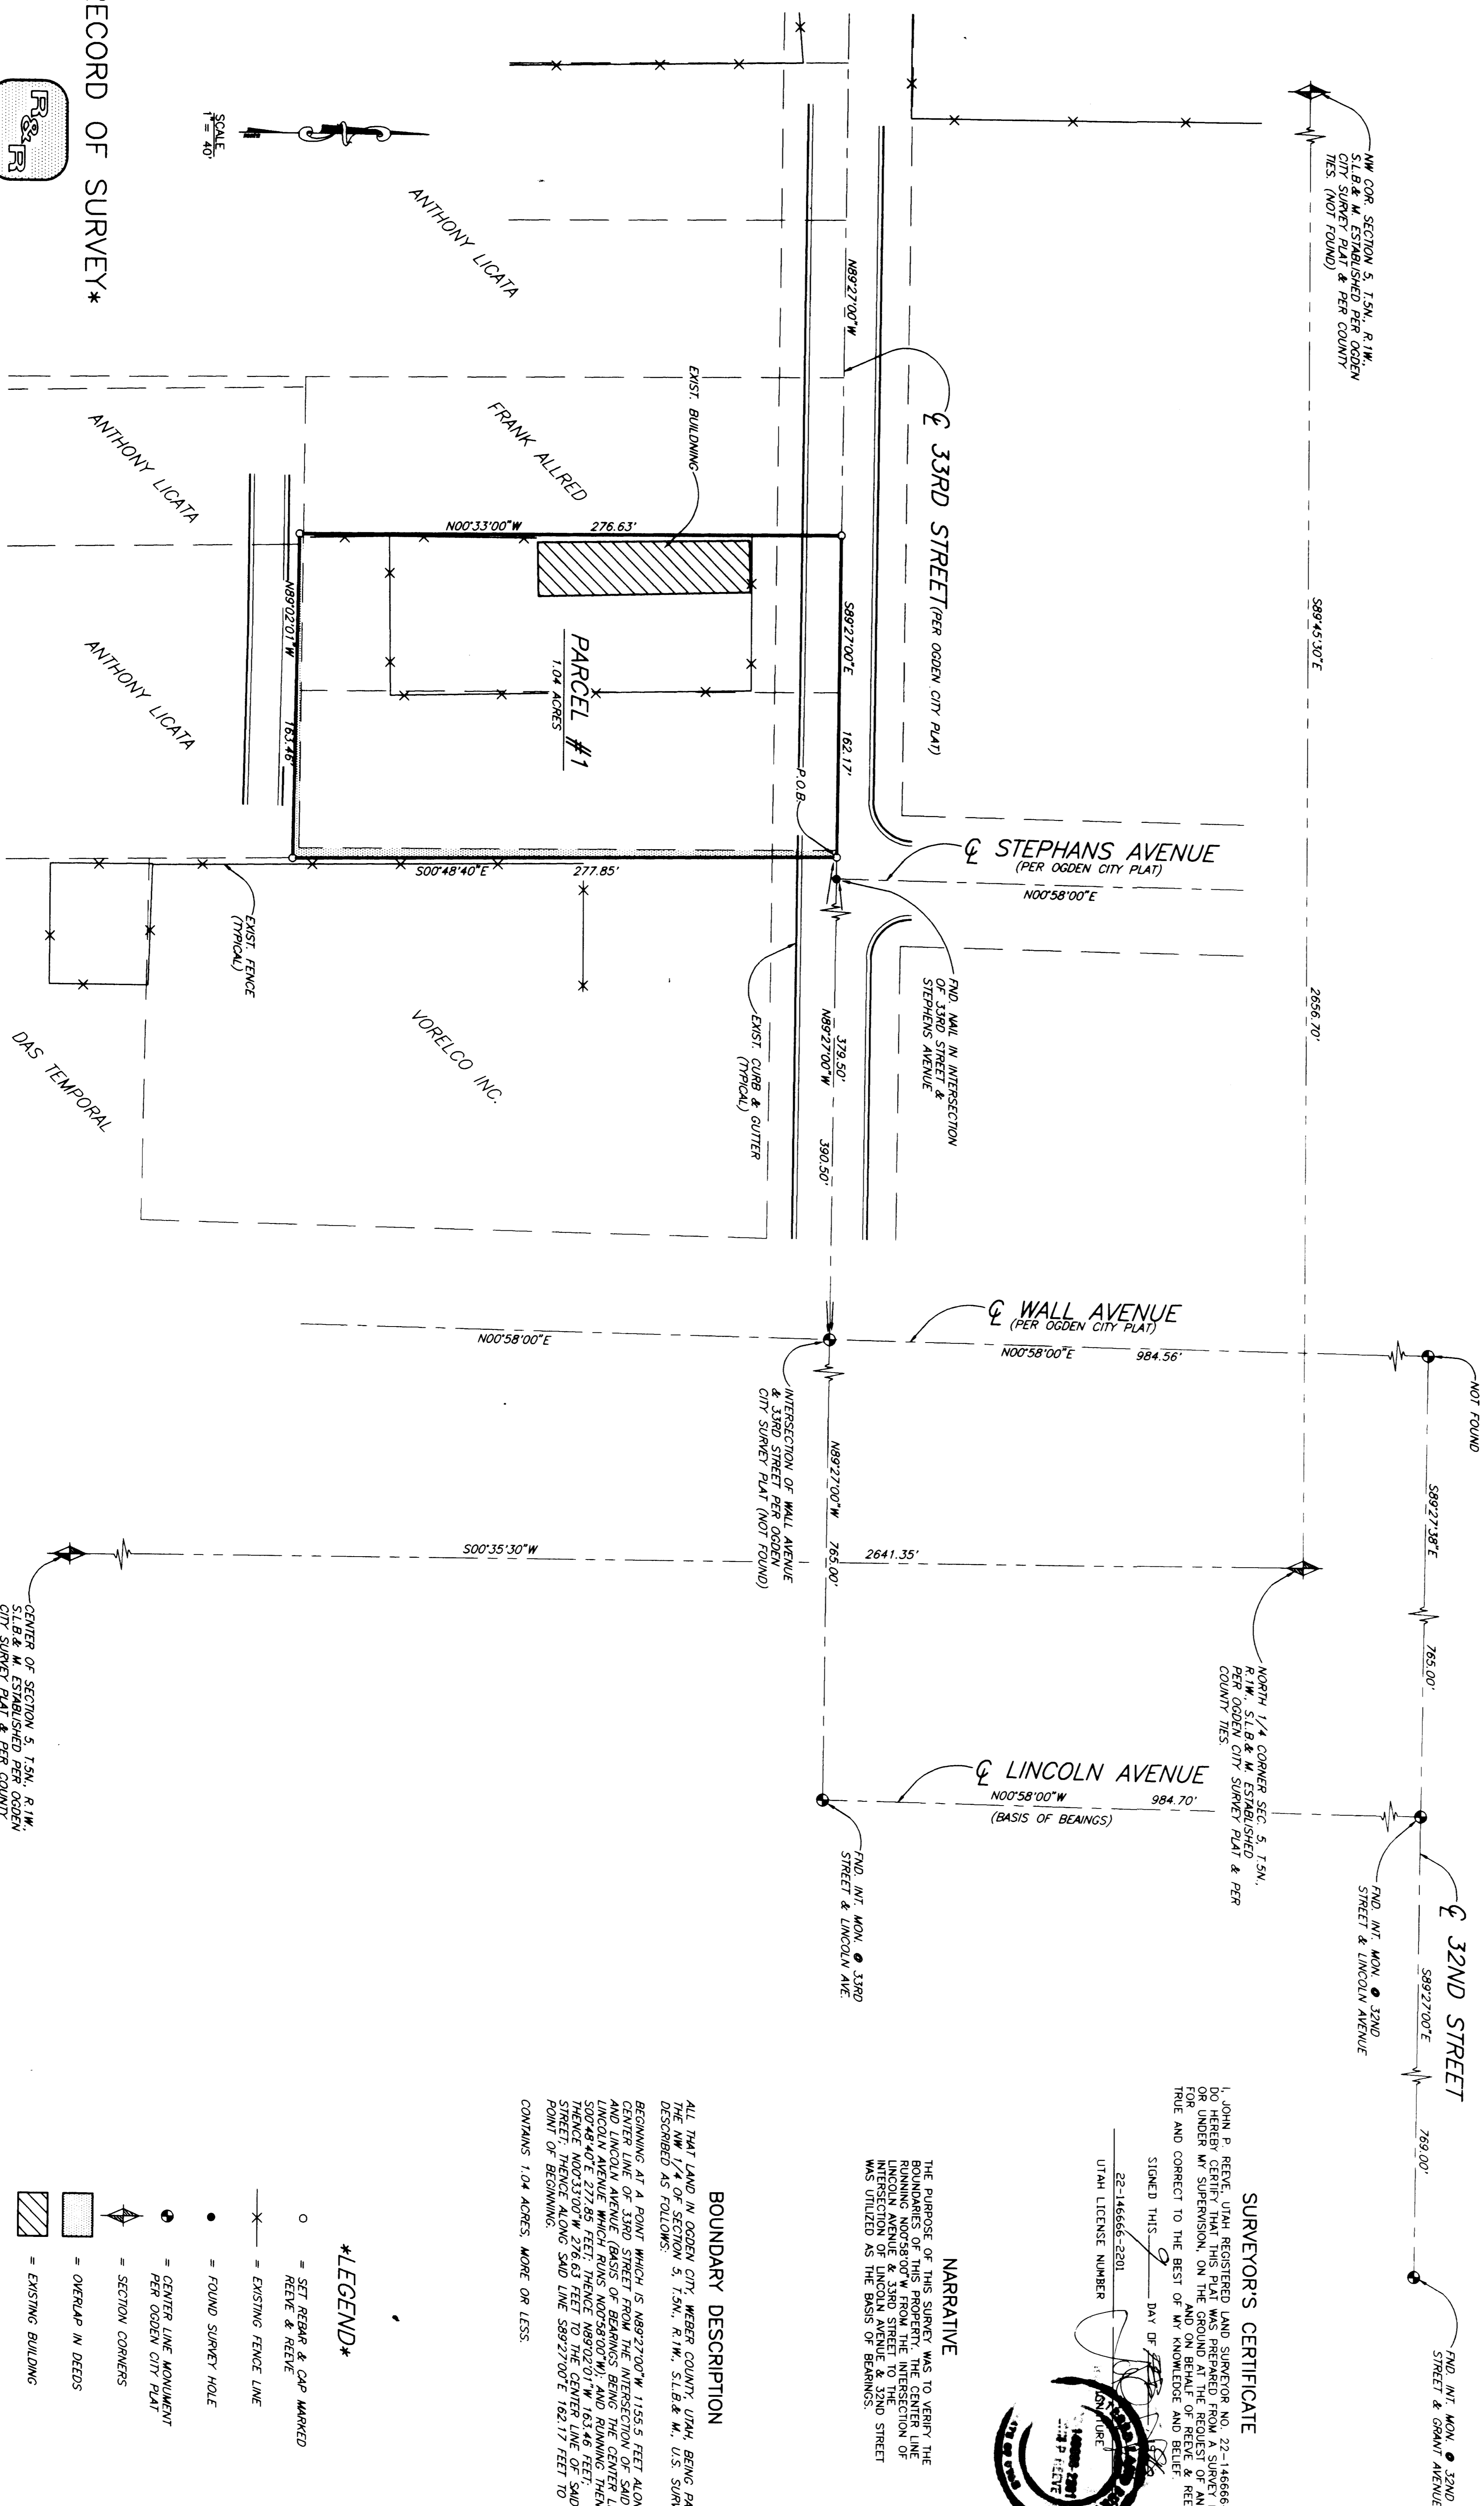

CENTER OF SECTION 5, T5N, R1W, S1/4 & M ESTABLISHED PER OGDEN CITY SURVEY PLAT & PER COUNTY DEEDS (NOT FOUND)

- \*LEGEND\***
- = SET REBAR & CAP MARKED REEVE & REEVE
  - x— = EXISTING FENCE LINE
  - = FOUND SURVEY HOLE
  - = CENTER LINE ALIGNMENT PER OGDEN CITY PLAT
  - ◊ = SECTION CORNERS
  - ▭ = OVERLAP IN DEEDS
  - ▨ = EXISTING BUILDING

**BOUNDARY DESCRIPTION**

ALL THAT LAND IN OGDEN CITY, WEBER COUNTY, UTAH, BEING PART OF THE NW 1/4 OF SECTION 5, T5N, R1W, S1/4 & M, US SURVEY DESCRIBED AS FOLLOWS:


CONTAINS 1.04 ACRES, MORE OR LESS.

**NARRATIVE**


**SURVEYOR'S CERTIFICATE**



22-146866-2201  
UTAH LICENSE NUMBER

JOHN P. REEVE  
LAND SURVEYOR  

