



1	REVISION
2	
3	
4	


PROJECT NO. 1111-01
DATE 11-22-87
SCALE 1" = 50'

DESIGNED BY
CHECKED BY
DRAWN BY
APPROVED BY

REVEE & REVEE, INC.
CIVIL AND ENVIRONMENTAL ENGINEERING
LAND PLANNING AND SITE DESIGN
LAND SURVEYING
ODDEN, UTAH

RECORD OF SURVEY

SHEET 1
SHEETS 1

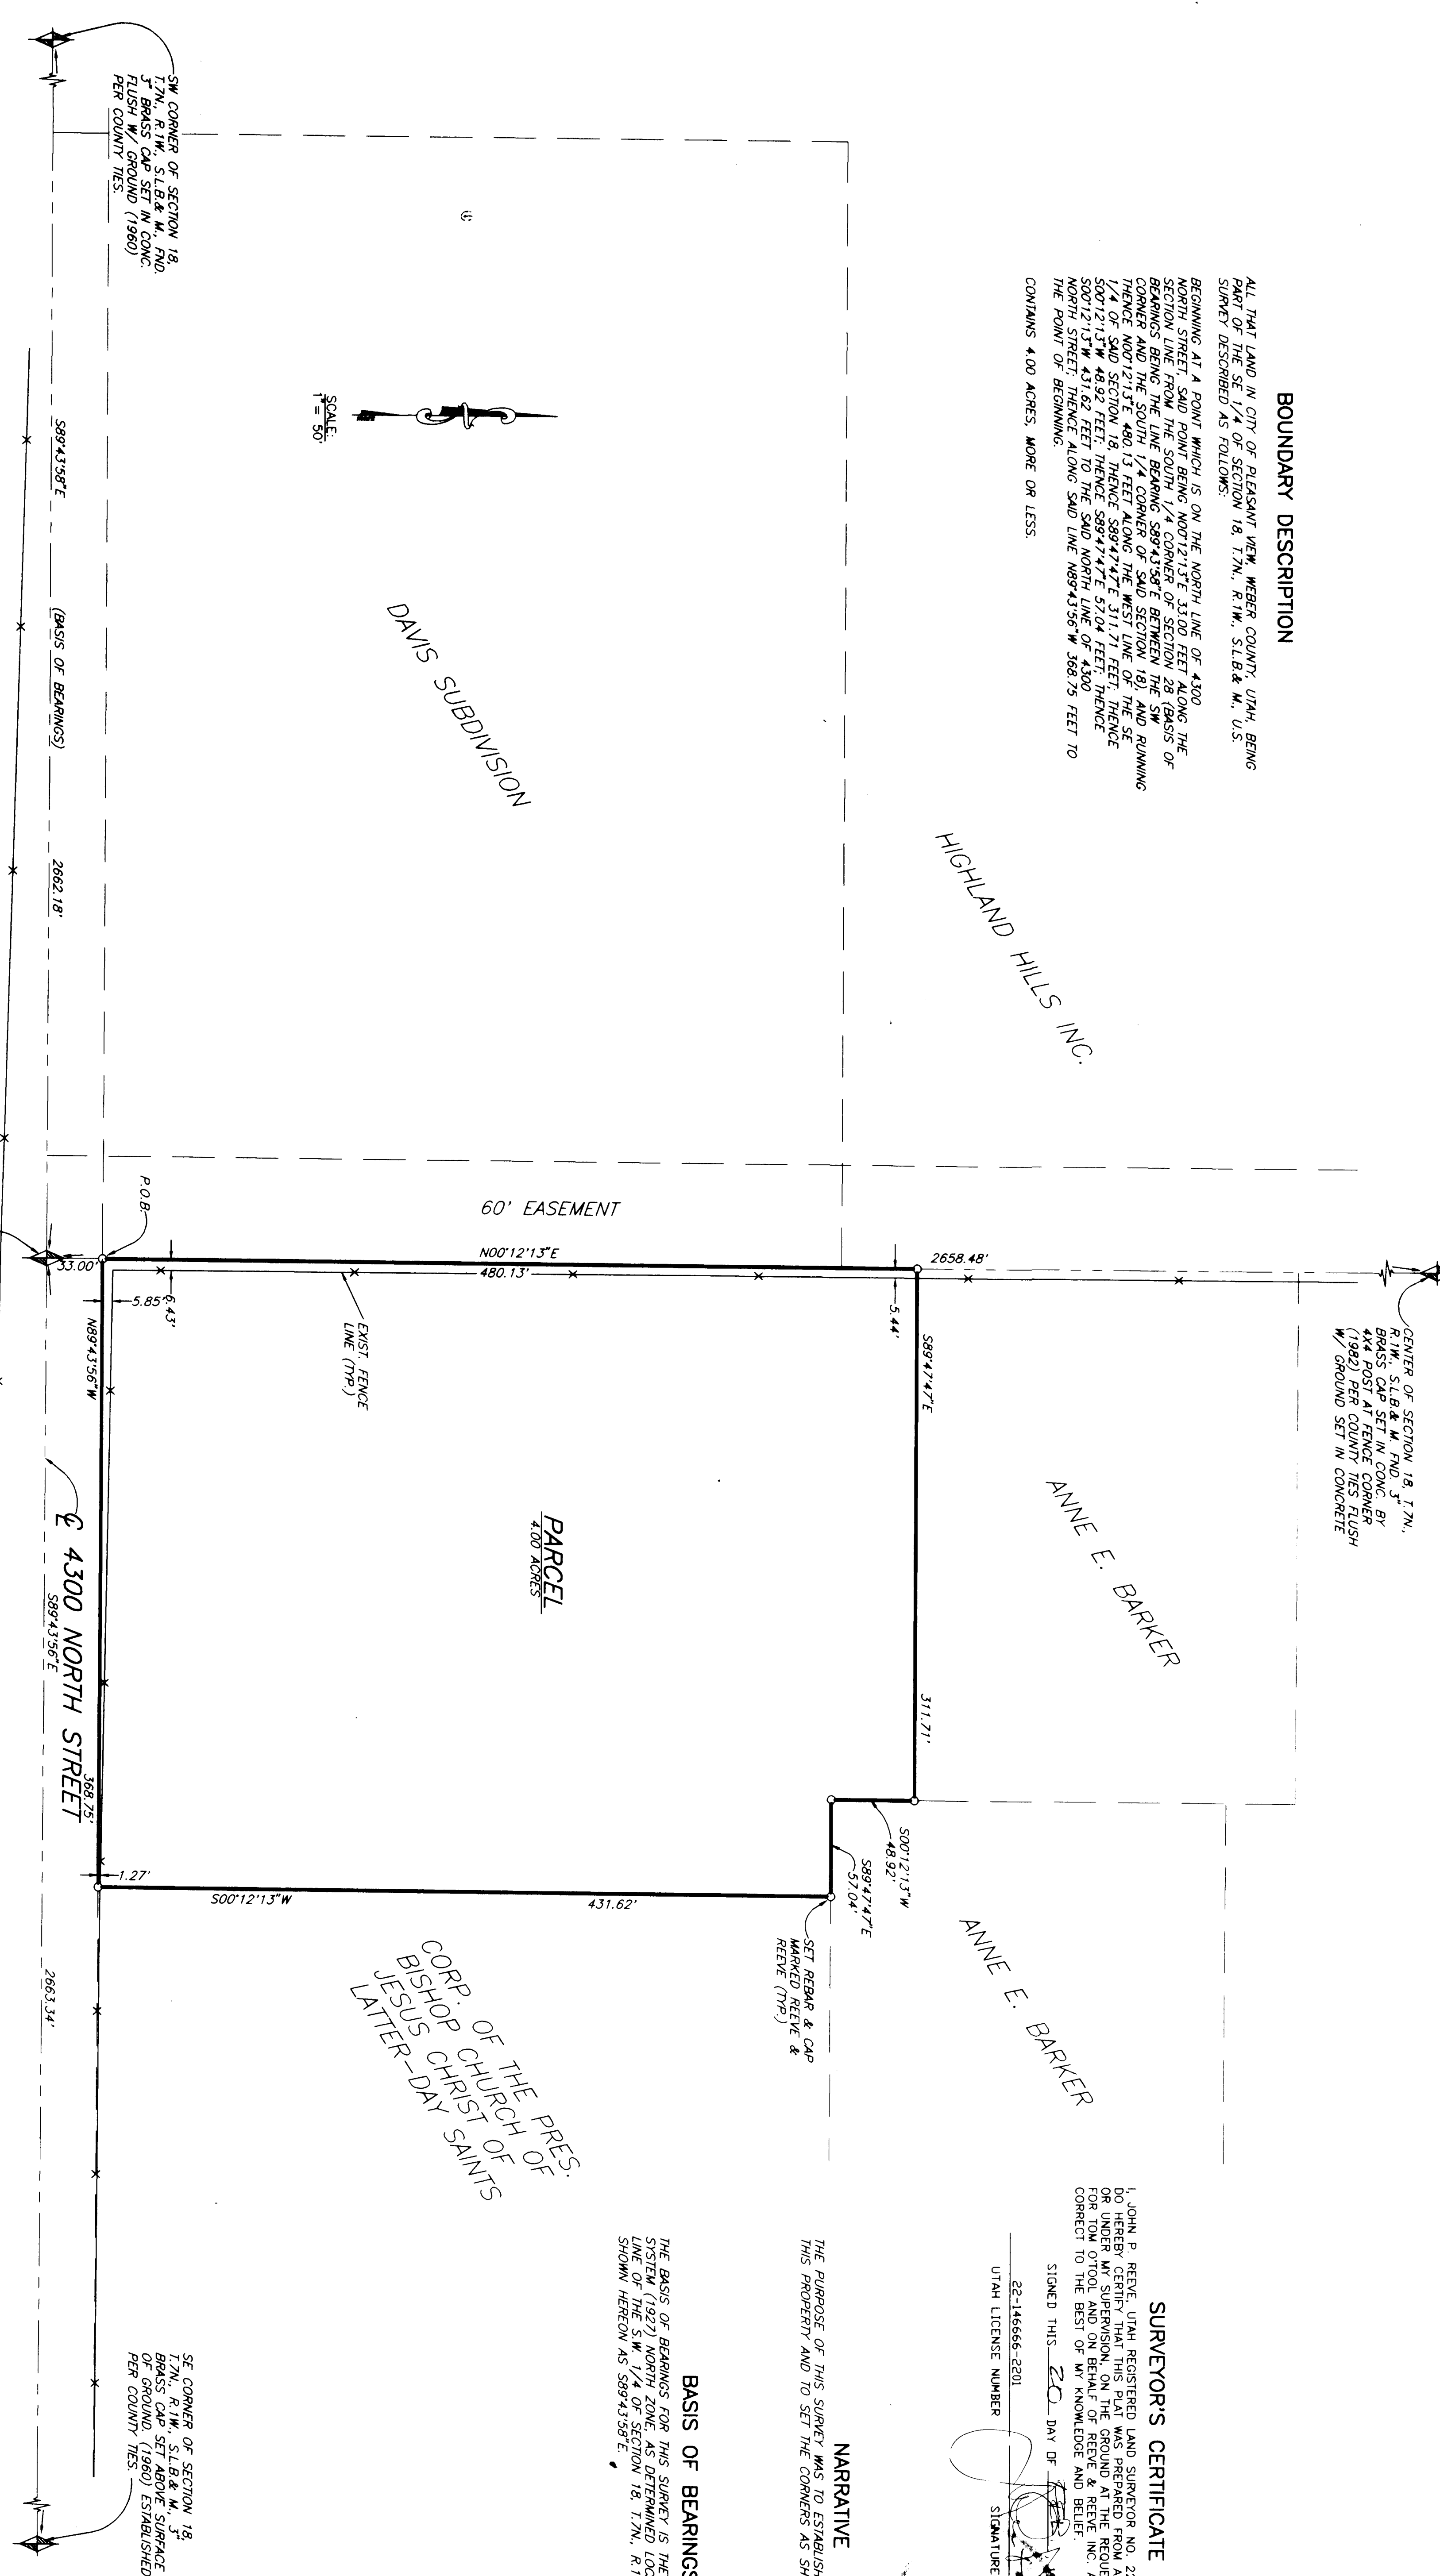

BOUNDARY DESCRIPTION

ALL THAT LAND IN CITY OF PLEASANT VIEW, WEBER COUNTY, UTAH BEING PART OF THE SE 1/4 OF SECTION 18, T7N, R1W, SLB& M, U.S. SURVEY DESCRIBED AS FOLLOWS:

CONTAINS 4.00 ACRES, MORE OR LESS.

CORNER OF SECTION 18, T7N, R1W, SLB& M, FND, 3" BRASS CAP SET IN CONG. BY 1982 PER COUNTY DEPARTMENT W/ GROUND SET IN CONCRETE

ANNE E. BARKER

ANNE E. BARKER


SURVEYOR'S CERTIFICATE
22-146666-2201
UTAH LICENSE NUMBER
SIGNATURE

NARRATIVE

THE PURPOSE OF THIS SURVEY WAS TO ESTABLISH THE BOUNDARIES OF THIS PROPERTY AND TO SET THE CORNERS AS SHOWN HEREON.

BASIS OF BEARINGS





SOUTH 1/4 CORNER OF SECTION 18, T7N, R1W, SLB& M, FND, 3" BRASS CAP SET 10' BELOW ROAD SURFACE (1982) PER COUNTY TIES

RECORD OF SURVEY

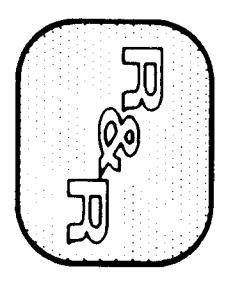

REVEE & REVEE, INC.
CIVIL AND ENVIRONMENTAL ENGINEERING
LAND PLANNING AND SITE DESIGN
LAND SURVEYING
ODDEN, UTAH

RECEIVED
OCT 24 1987