

G:\DRAWINGS\SHARED\2768101-PAT10\PAT10SUR Tue Jul 15 15:11:15 1997 JAE

REVISIONS

1	
2	
3	
4	
5	
6	



PROJECT NO. 2786-01, 2787-01, 2788-01
DATE: APRIL 2, 1997
SCALE: 1"=60'
DRAWN: R
CHECKED: R

REEVE & REEVE, INC.
ENGINEERS PLANNERS & SURVEYORS
3670 QUINCY AVE. SUITE NO. 1

RECORD OF SURVEY

PART OF PATIO SPRINGS
UNIT NUMBER 1

SHEET
1
SHEETS

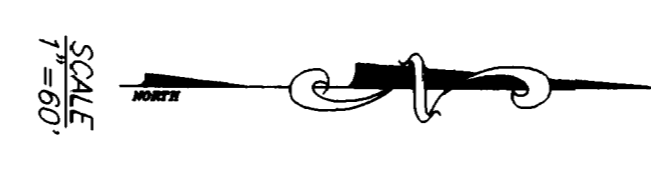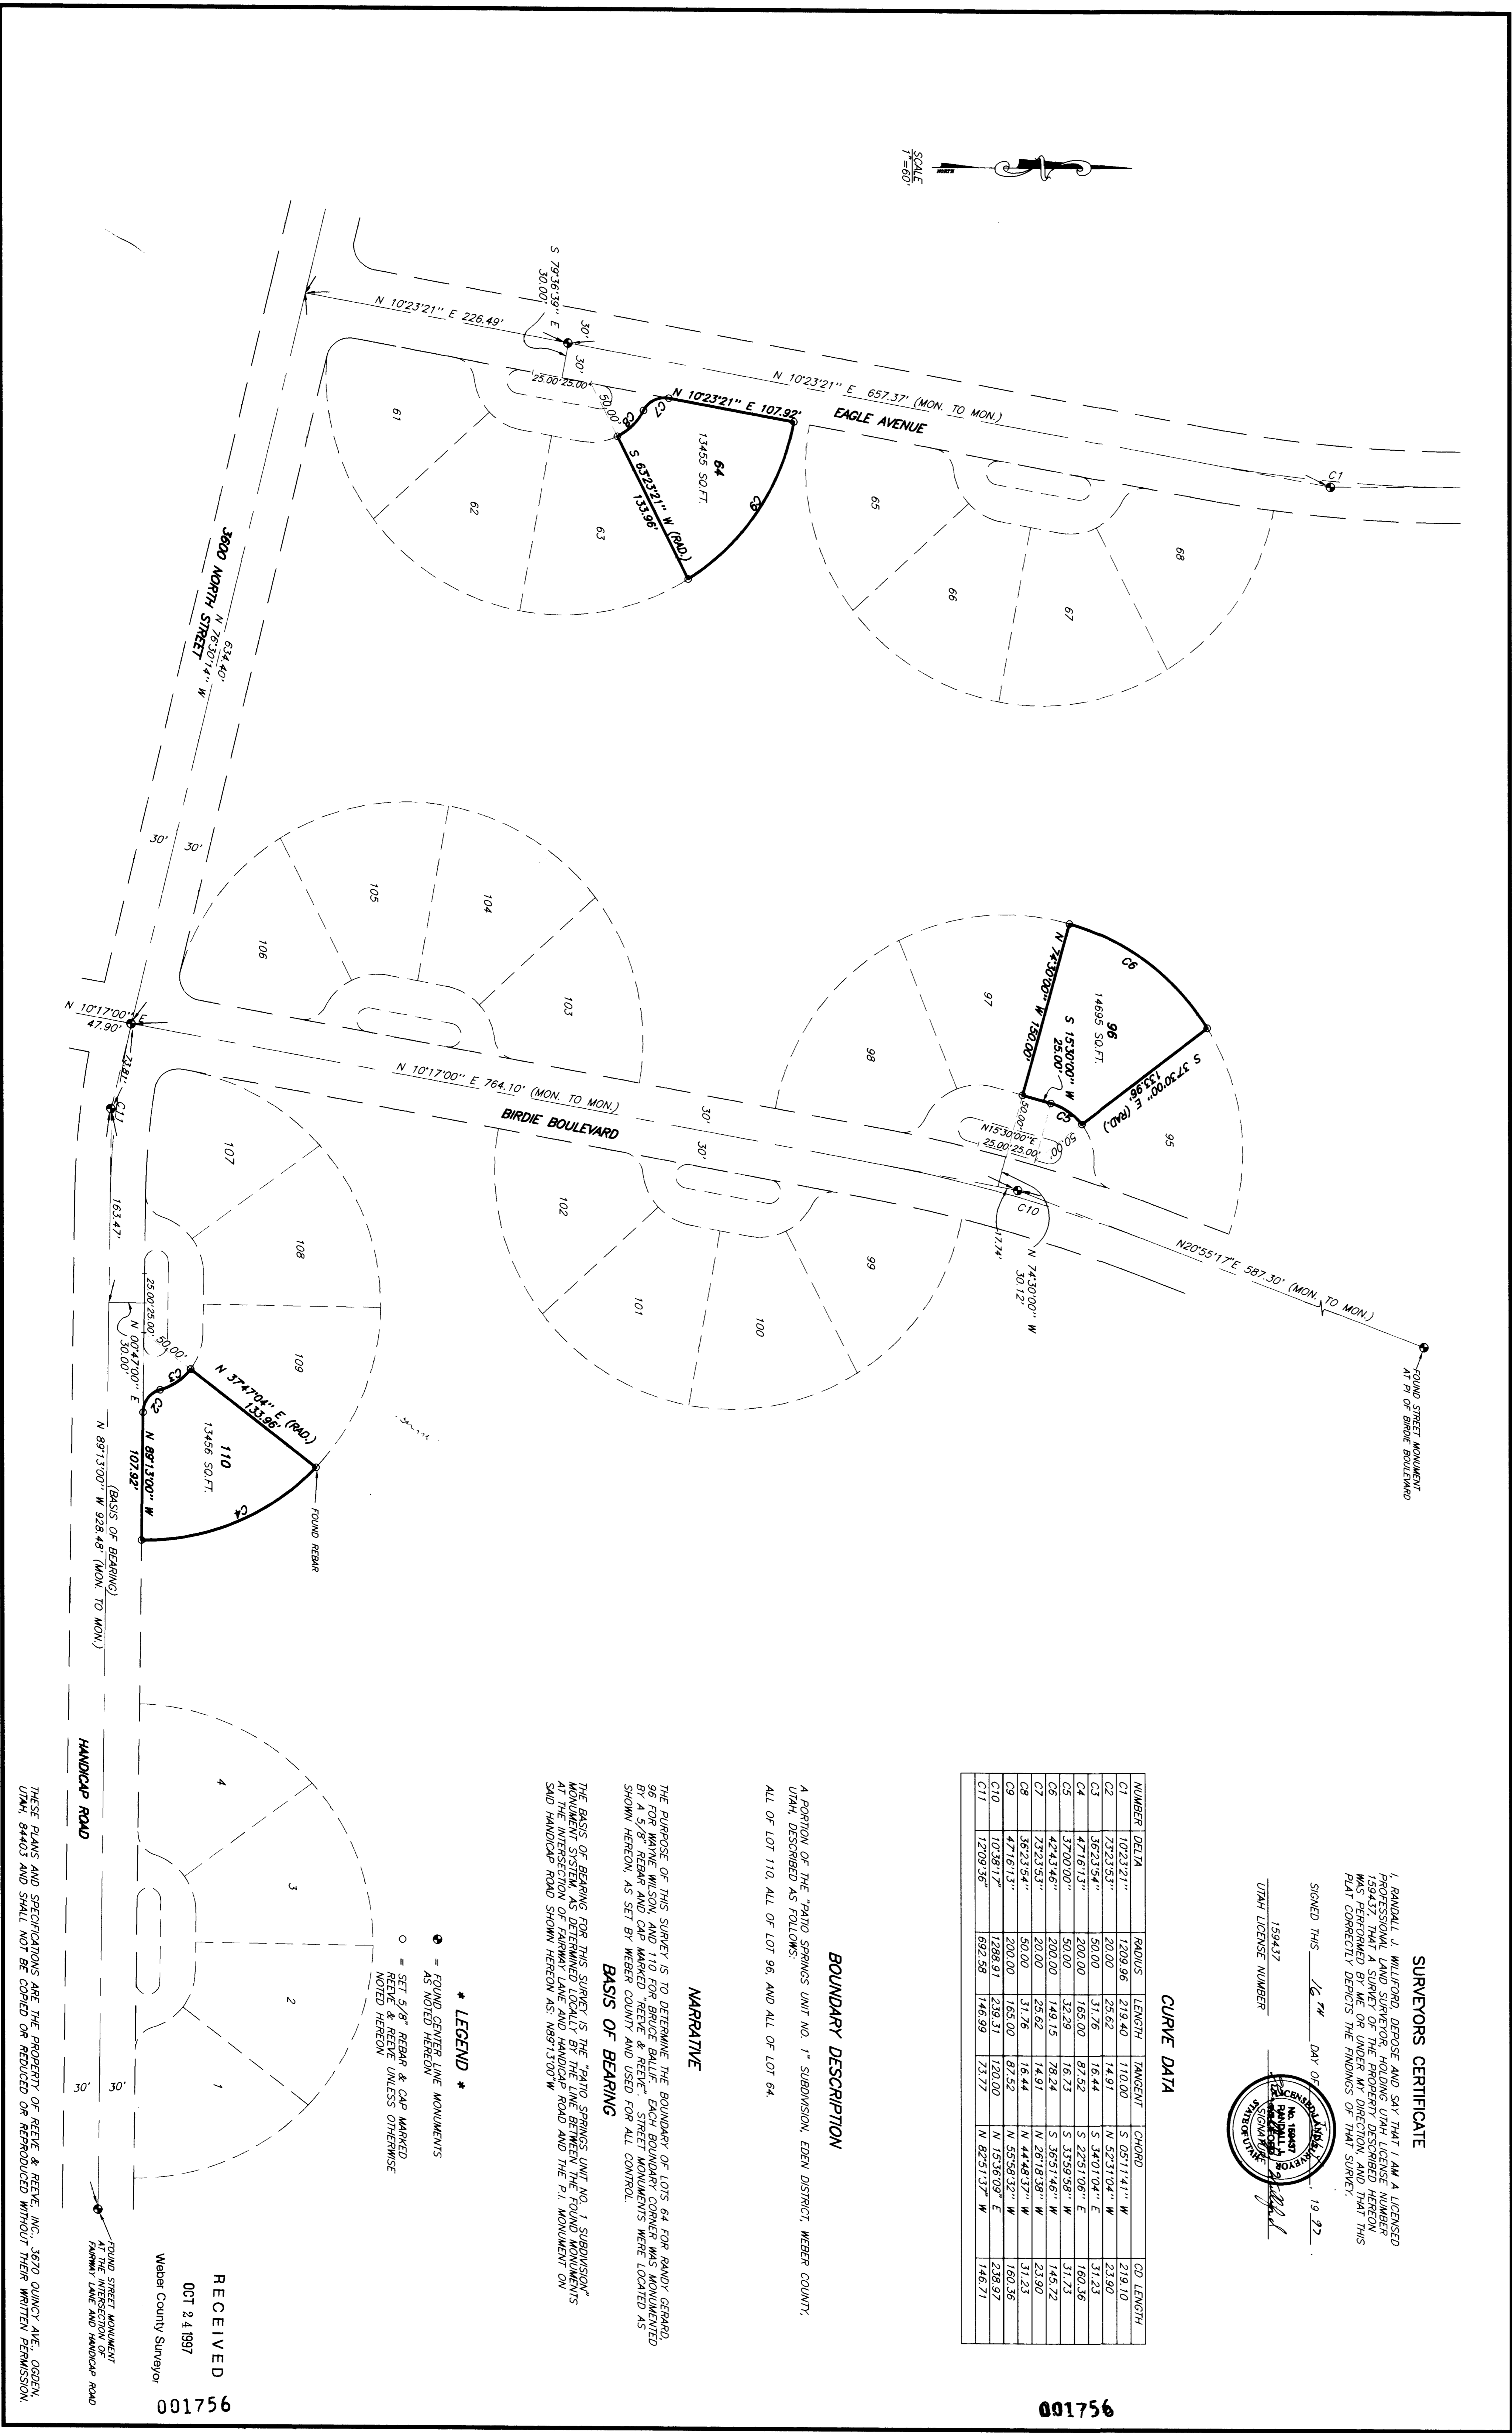

CURVE DATA

NUMBER	DEPTA	RADIUS	LENGTH	TANGENT	CHORD	CH. LENGTH

BOUNDARY DESCRIPTION

A PORTION OF THE "PATIO SPRINGS UNIT NO. 1" SUBDIVISION, EDEEN DISTRICT, WEBER COUNTY, UTAH, DESCRIBED AS FOLLOWS:
ALL OF LOT 110, ALL OF LOT 96, AND ALL OF LOT 64.

NARRATIVE


BASIS OF BEARING

THE BASIS OF BEARING FOR THIS SURVEY IS THE "PATIO SPRINGS UNIT NO. 1" SUBDIVISION, AS SHOWN ON THE PLAT THEREOF, AND THE MONUMENTS WERE LOCATED AS SHOWN SAID HANDICAP ROAD SHOWN HEREON AS N89°13'00" W.

LEGEND

- = ROUND CENTER LINE MONUMENTS
- = SET 3/8" REBAR & CAP MARKED NOTED HEREON
- = SET 3/8" REBAR & CAP MARKED NOTED HEREON UNLESS OTHERWISE NOTED HEREON

RECEIVED
OCT 2 1997
Weber County Surveyor

001756

SURVEYORS CERTIFICATE
SIGNED THIS 16TH DAY OF SEPTEMBER, 1997.
159447
UTAH LICENSE NUMBER

