DRAWING NUMBER 001758
PLAN HOLD CORPORATION • IRVINE CALIFORNIA
REORDER BY NUMBER 07SAR

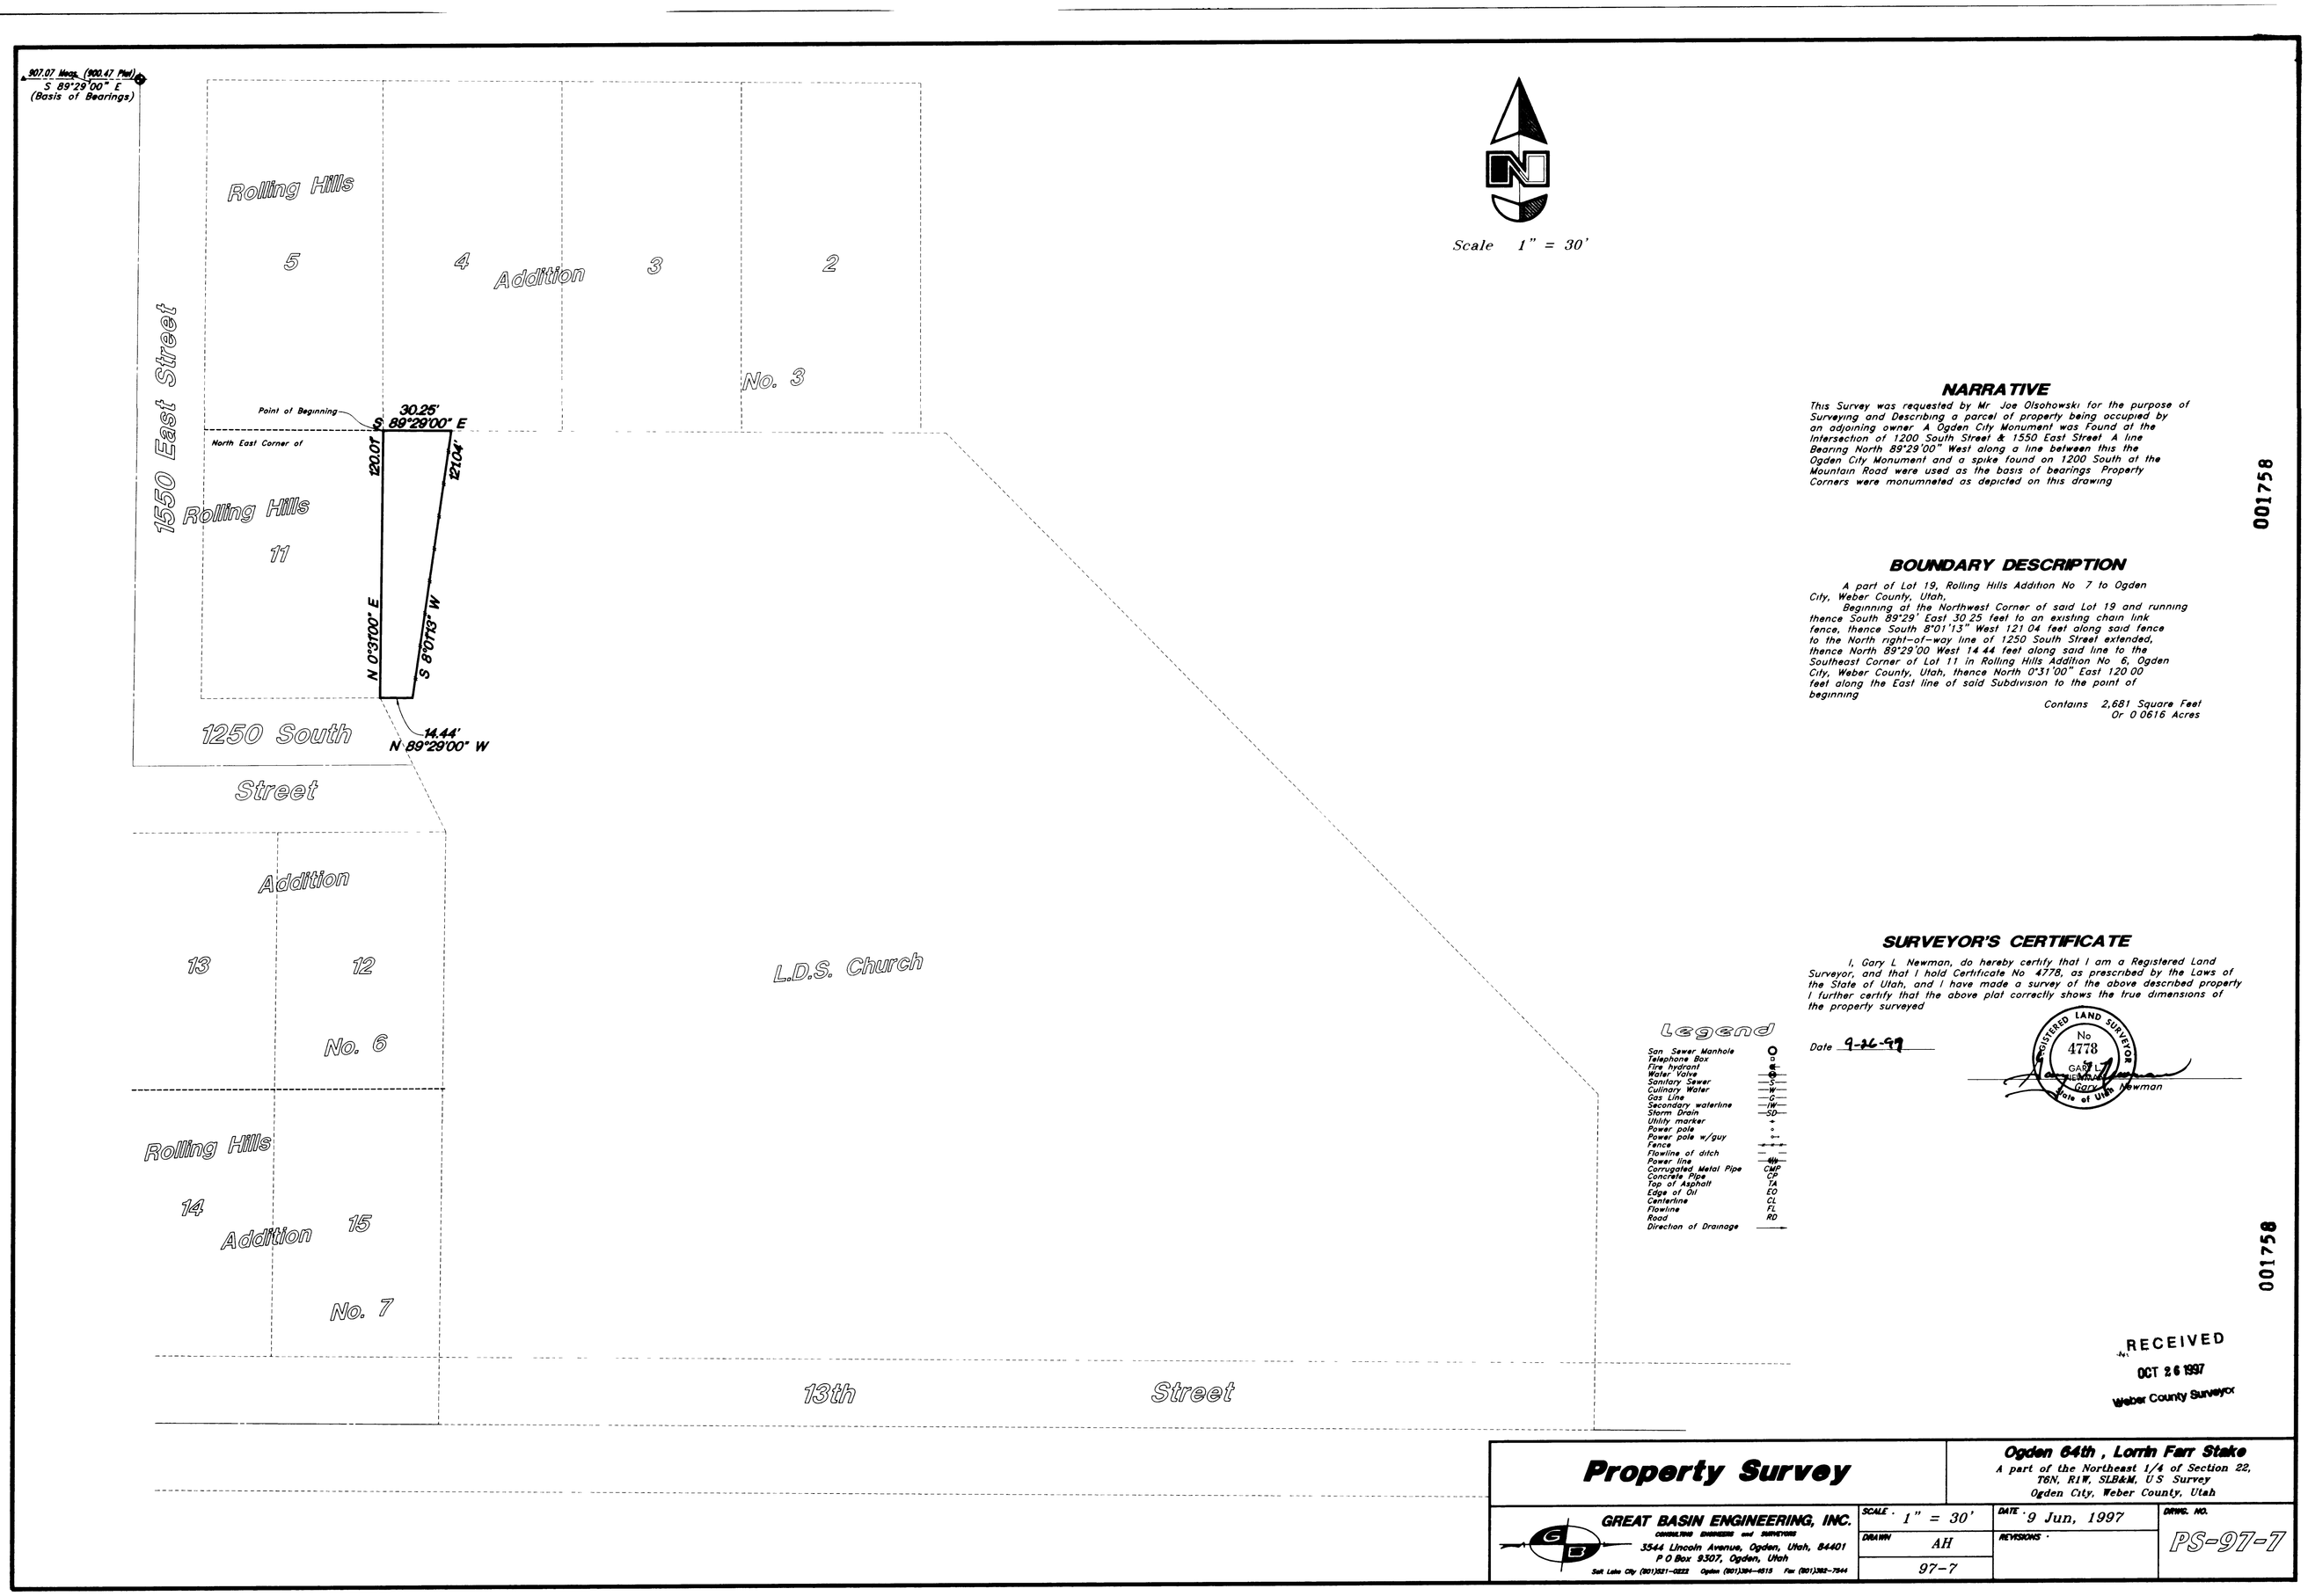

NARRATIVE

This Survey was requested by Mr Joe Olsohowski for the purpose of Surveying and Describing a parcel of property being occupied by an adjoining owner A Ogden City Monument was Found at the Intersection of 1200 South Street & 1550 East Street A line Bearing North 89°29'00" West along a line between this the Ogden City Monument and a spike found on 1200 South at the Mountain Road were used as the basis of bearings Property Corners were monumneted as depicted on this drawing

BOUNDARY DESCRIPTION

A part of Lot 19, Rolling Hills Addition No 7 to Ogden City, Weber County, Utah.

Beginning at the Northwest Corner of said Lot 19 and running thence South 89°29' East 30 25 feet to an existing chain link fence, thence South 8°01'13" West 121 04 feet along said fence to the North right-of-way line of 1250 South Street extended, thence North 89°29'00 West 14 44 feet along said line to the Southeast Corner of Lot 11 in Rolling Hills Addition No 6, Ogden City, Weber County, Utah, thence North 0°31'00" East 120 00 feet along the East line of said Subdivision to the point of beginning

Contains 2,681 Square Feet
Or 0 0616 Acres

SURVEYOR'S CERTIFICATE

I, Gary L Newman, do hereby certify that I am a Registered Land Surveyor, and that I hold Certificate No 4778, as prescribed by the Laws of the State of Utah, and I have made a survey of the above described property I further certify that the above plat correctly shows the true dimensions of the property surveyed

Date 9-26-97

REGISTERED LAND SURVEYOR No 4778 GARY L. NEWMAN State of Utah

Gary L Newman

Legend

San Sewer Manhole	S
Telephone Box	T
Fire hydrant	F
Water Valve	W
Sanitary Sewer	S
Culinary Water	W
Gas Line	G
Secondary waterline	IW
Storm Drain	SD
Utility marker	+
Power pole	+
Power pole w/guy	+
Fence	+ + +
Flowline of ditch	
Power line	PL
Corrugated Metal Pipe	CMP
Concrete Pipe	CP
Top of Asphalt	TA
Edge of Oil	EO
Centerline	CL
Flowline	FL
Road	RD
Direction of Drainage	

RECEIVED
OCT 26 1997
Weber County Surveyor

Property Survey

Ogden 64th , Lorrin Farr Stake
A part of the Northeast 1/4 of Section 22, T6N, R1W, SLB&M, U S Survey
Ogden City, Weber County, Utah

GREAT BASIN ENGINEERING, INC.
CONSULTING ENGINEERS and SURVEYORS
3544 Lincoln Avenue, Ogden, Utah, 84401
P O Box 9307, Ogden, Utah
Salt Lake City (801)521-0222 Ogden (801)394-4515 Fax (801)392-7544

SCALE · 1" = 30'	DATE · 9 Jun, 1997	DRWG. NO.	
DRAWN AH	REVISIONS ·	PS-97-7	
97-7			

001758