


NOTE:
17-27-801 THRU 17-27-811 REGARDING THE SUBDIVISION OF LAND

- COMMENTS**
1. THIS SURVEY IS MADE AT THE INSTANCE OF THE SALT LAKE COUNTY WATER CONSERVANCY DISTRICT FOR THEIR OWN USES AND PURPOSES.
 2. THE BASIS OF BEARING FOR THIS SURVEY IS THE UTM STATE PLANE COORDINATE SYSTEM, NORTH ZONE, AS SHOWN ON DOCUMENTS OF RECORD IN THE WEBER COUNTY SURVEYOR'S OFFICE.
 3. DEED BEARINGS AND DISTANCES HAVE BEEN PROBABED WITHIN THE SET/4 OF SECTION 27, 16N, R2W, S88M.

LEGAL DESCRIPTIONS

PARCEL A:


PARCEL B:


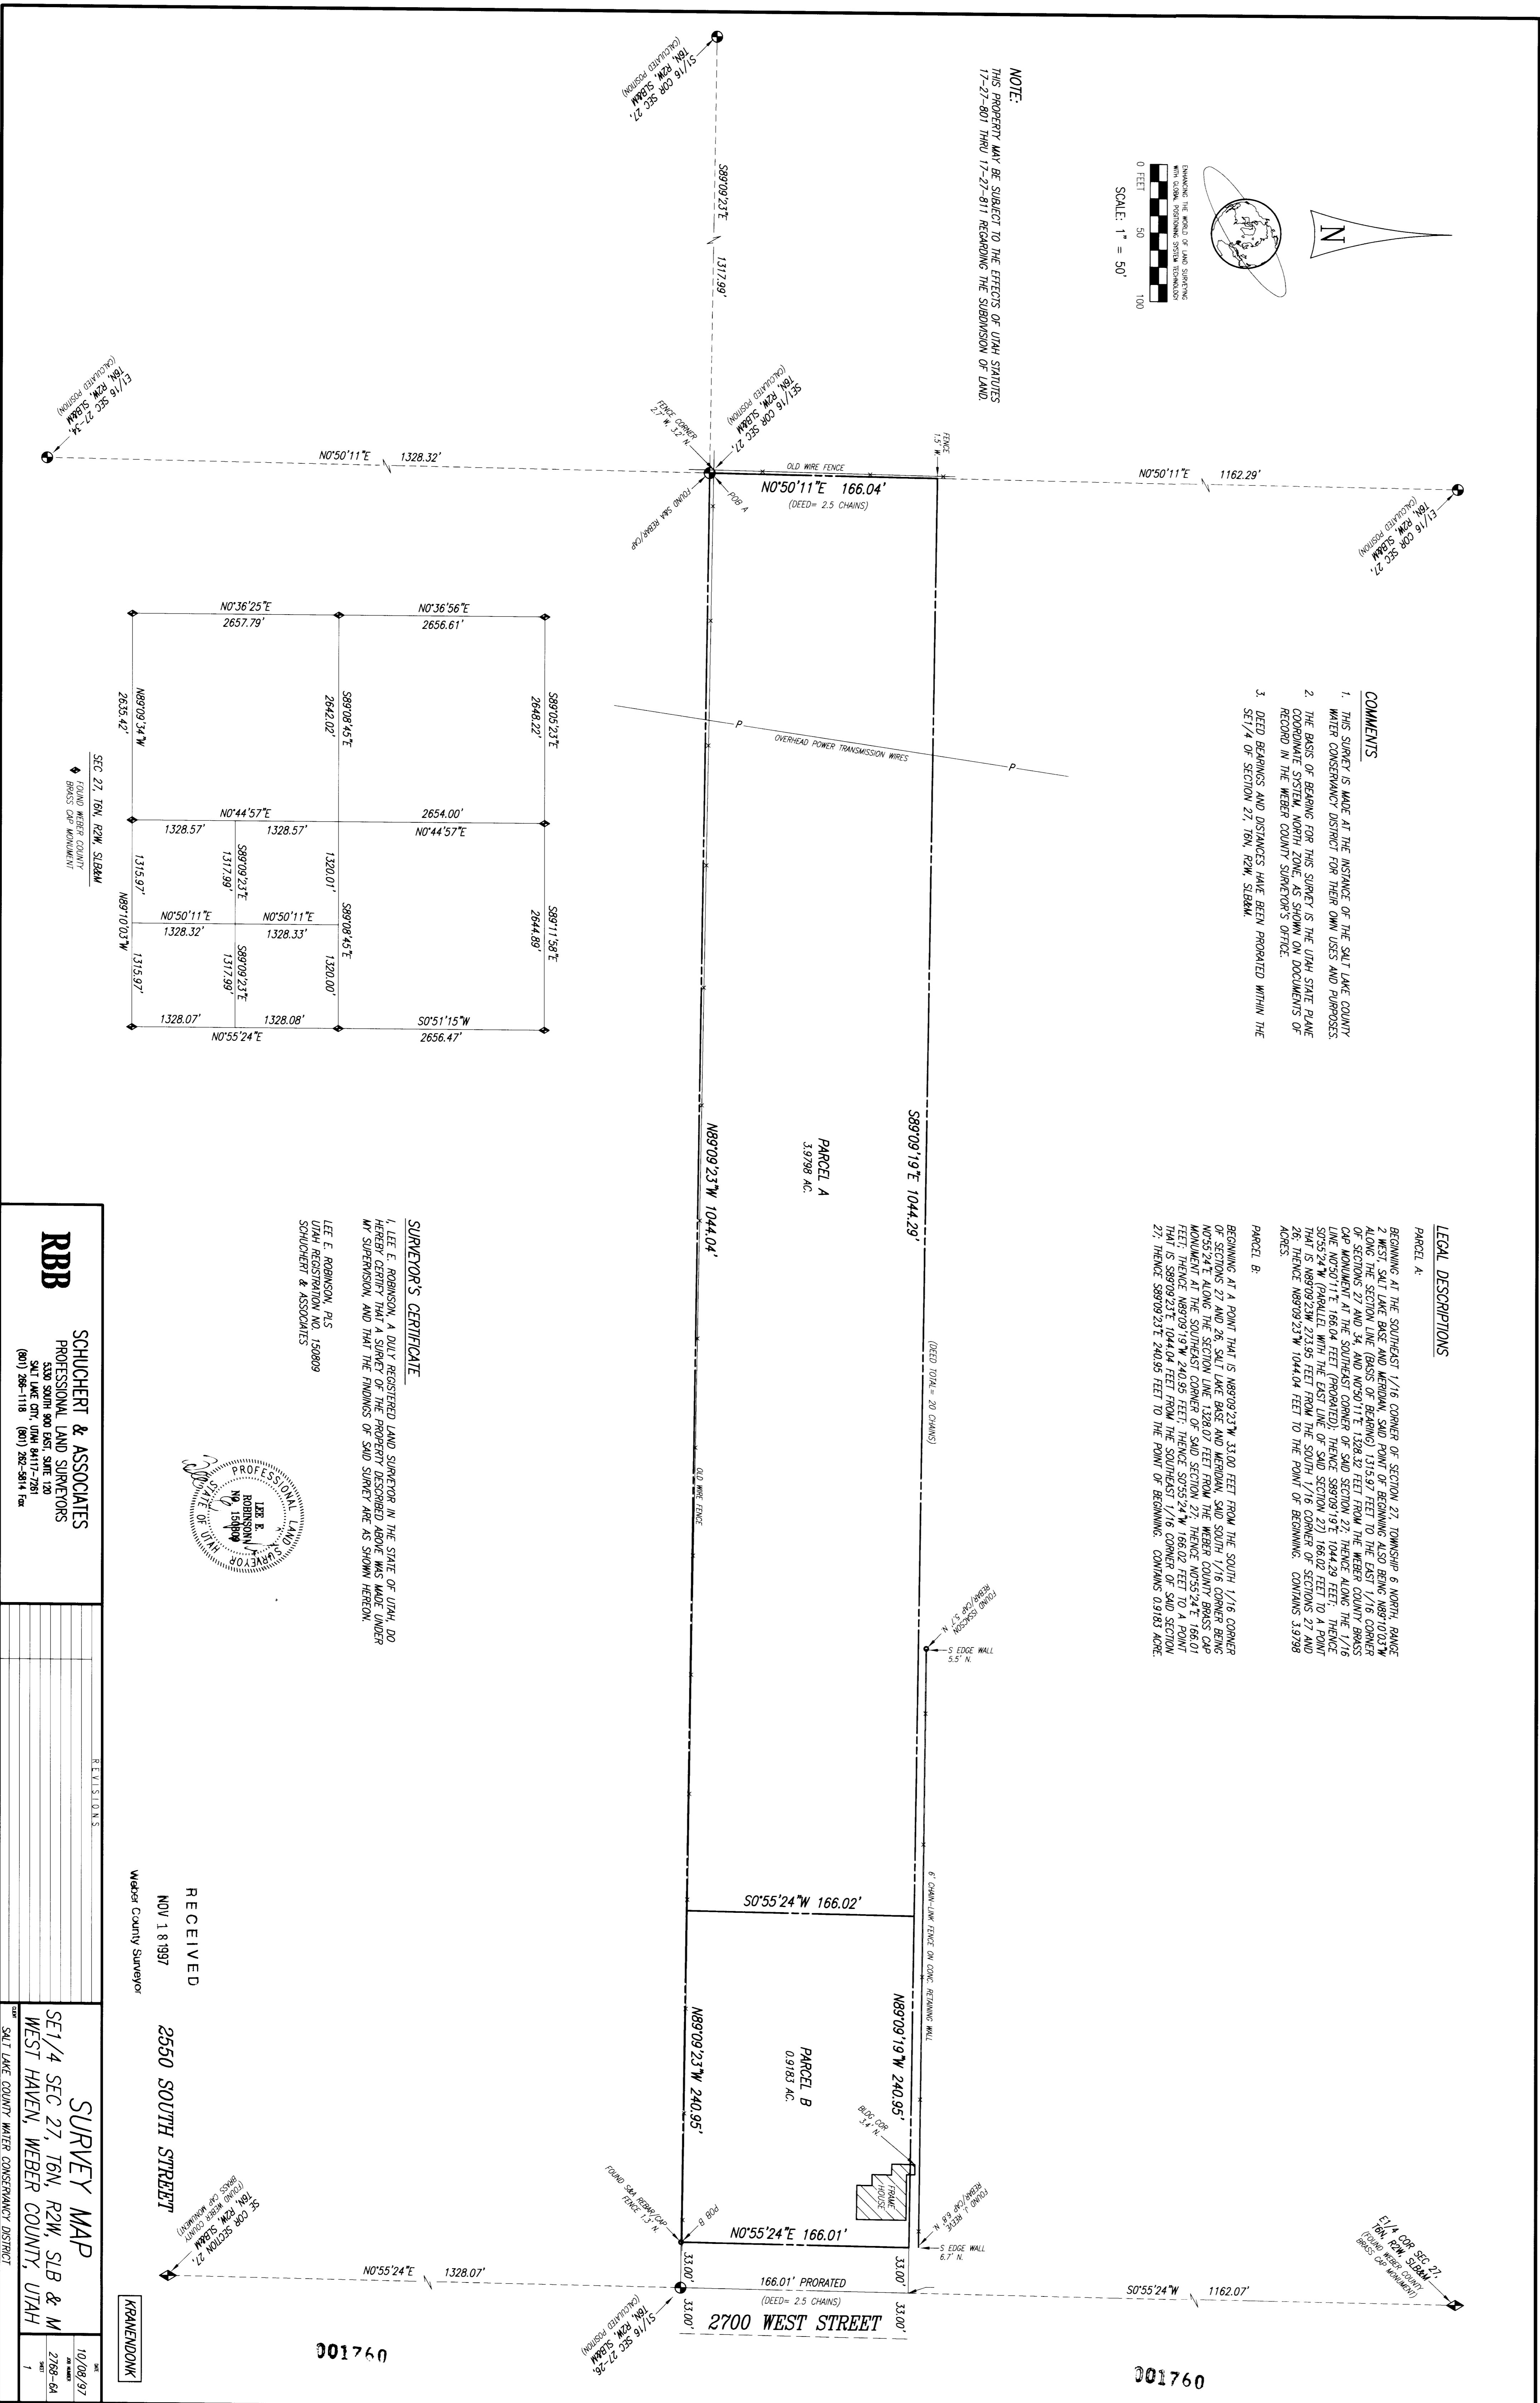

SURVEYOR'S CERTIFICATE


LEE E. ROBINSON, P.L.S.
UTAH REGISTRATION NO. 150889
SCHUCHERT & ASSOCIATES



RBB
SCHUCHERT & ASSOCIATES
PROFESSIONAL LAND SURVEYORS

RECEIVED
NOV 1 8 1997
WEBER COUNTY SURVEYOR

SURVEY MAP
SET/4 SEC. 27, 16N, R2W, S88M, SLB & M
WEST HAVEN, WEBER COUNTY, UTAH

10/09/97
2708-64