

Mall Tax Notice to Address Ogdem, Utah BOOK 371 PAGE 153

WARRANTY DEED
 Carl J. Blodgett and Lila Blodgett, husband and wife,
 Grantor
 of North Ogdem County of Weber, State of Utah, hereby CONVEY and WARRANT TO GEORGE F. SIMONS as Bishop of the North Ogdem Second Ward of the Church of Jesus Christ of Latter-day Saints, and his successors in office,
 Grantee

of North Ogdem County of Weber, State of Utah, for the sum of THIRTY-FIVE HUNDRED - \$3500.00 - DOLLARS, the following described tract of land in Weber County, State of Utah:

A part of the Southeast and Southwest Quarters of Section 33, Township 7 North, Range 1 West, Salt Lake Meridian, U. S. Survey; Beginning at a point on the North line of County Road 1051.28 feet South from the Northeast corner of said Southwest Quarter Section; running thence West 155.1 feet; thence North 400 feet; thence East 435.6 feet; thence South 400 feet; thence West 280.5 feet along North line of County Road, to the place of beginning, containing 4 acres.

Together with all water rights appurtenant thereto.
 Subject to 5/12ths of the General Taxes for the year 1951.



WITNESS the hands of said Grantor s, this 21st day of July A. D. 1951.
 Signed in the presence of
 Thomas J. Melea
 Carl J. Blodgett
 Lila Blodgett

STATE OF UTAH }
 County of Weber }
 Personally appeared before me Carl J. Blodgett and Lila Blodgett, husband and wife, the signers of the within instrument, who duly acknowledged to me that they executed the same.



Notary Public
 My Commission Expires April 3 - 1953

Recording Data
 Entry No. 180663
 Serial No. Rn 9052
 Filed and Recorded July 27 10 05 AM '51
 State of Utah
 County of Weber
 Book 371 of Records
 Page 153
 Dorely B. Campbell
 500-1250
 (Use black typewriter ribbon only)

NARRATIVE OF SURVEY
 THE PURPOSE OF THIS SURVEY WAS TO ESTABLISH THE LINES OF THE PROPERTY AS DESCRIBED IN THE DEED AS SHOWN HEREON. THE CENTER OF SECTION THAT THE PROPERTY IS DESCRIBED FROM IS NOT MONUMENTED, AND SINCE THERE IS NO INTENT TO TRANSFER THE PROPERTY, A NEW DESCRIPTION WAS NOT CREATED. THE TIES AS SHOWN ON PLAT ARE SUFFICIENT TO ALLOW THE SURVEY TO BE RETRACED.

I, MARTIN B. MOORE JR., UTAH REGISTERED LAND SURVEYOR NO. 3964, DO HEREBY CERTIFY THAT THIS PLAT WAS PREPARED FROM A SURVEY MADE ON THE GROUND BY ME OR UNDER MY SUPERVISION, AT THE REQUEST OF MATHEWSON - SANDERS ARCHITECTS, AND ON BEHALF OF MOUNTAIN WEST PROFESSIONAL LAND SURVEYORS P.C., AND IS TRUE AND CORRECT TO THE BEST OF MY KNOWLEDGE AND BELIEF.

Martin B. Moore Jr.
 MARTIN B. MOORE JR.

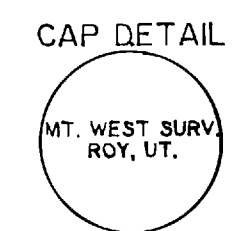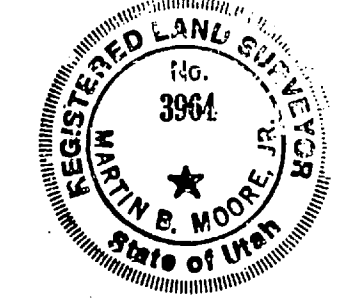

NOTE: #5 CAPPED REBAR SET AT ALL CORNERS

SCALE: 1"=20'

SITE SURVEY
 NORTH OGDEN 2nd & 10th WARDS
 PART OF THE S1/2 OF SECTION 33, T7N, R1W, S.L.B. & M.
 for
 MATHEWSON-SANDERS ARCHITECTS

Date 11/01/58	No. 88-3008-A	Drwn DNM	chk MBM
MOUNTAIN WEST PROFESSIONAL LAND SURVEYORS, P.C. Roy, Utah			

RECEIVED
 JUL 20 1958
 Weber County Surveyor

BM: FINISH FLOOR AT NW COR IN DOOR
 ELEV= 100.00'

2100 NORTH STREET

000179