


•SURVEYOR'S CERTIFICATE•

I, DOUG L. GRAHAM, A PROFESSIONAL LICENSED LAND SURVEYOR AS PRESCRIBED BY THE LAWS OF THE STATE OF UTAH AND HOLDING LICENSE NUMBER 172757 DO HEREBY CERTIFY THAT I MADE A SURVEY OF THE BELOW DESCRIBED PROPERTY AND THE PLAT HEREON IS A TRUE AND CORRECT REPRESENTATION OF SAID SURVEY.

DATE: 5-15-97 SIGNED: [Signature]

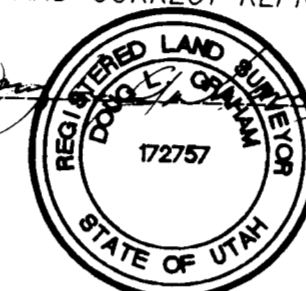

•BOUNDARY DESCRIPTION• (RECORD)

PART OF THE SOUTHWEST QUARTER OF SECTION 6, TOWNSHIP 7 NORTH, RANGE 1 EAST, SALT LAKE BASE AND MERIDIAN, U.S. SURVEY, BEGINNING AT A POINT NORTH 85°39' EAST 953.02 FEET ALONG THE SECTION LINE FROM THE SOUTHWEST CORNER OF SAID SECTION 6, AND RUNNING THENCE NORTH 48°34'40\"

(SURVEYED)

A PART OF THE SOUTHWEST QUARTER OF SECTION 6, TOWNSHIP 7 NORTH, RANGE 1 EAST, SALT LAKE BASE AND MERIDIAN, U.S. SURVEY, DESCRIBED AS FOLLOWS: BEGINNING AT A POINT ON THE SECTION LINE, SAID POINT BEING NORTH 85°39'00\"

•NARRATIVE•

THE PURPOSE OF THIS SURVEY WAS TO ESTABLISH THE PROPERTY CORNERS OF A 1.31 ACRE PARCEL EXISTING IMPROVEMENTS, FENCES AND SOME EVIDENCE OF PREVIOUS SURVEYS WERE USED TO ESTABLISH THE WEST LINE OF THE ROADWAY; A FOUND REBAR AND FENCING NEAR THE SOUTH BOUNDARY APPEARS TO HAVE BEEN ESTABLISHED FROM A PRIOR MONUMENTED LOCATION FOR THE SOUTH QUARTER OF SECTION 6. THE CURRENT MONUMENT LOCATION OF THIS CORNER WAS USED FOR THE SOUTH BOUNDARY OF THIS SURVEY.

RECEIVED

DEC 03 1997

Weber County Surveyor

LANDMARK SURVEYING
A COMPLETE SURVEYING SERVICE
2485 GRANT AVE. SUITE 318 OGDEN, UTAH 84401
PH. 827-4014

CLIENT: DIANA LINFORD

LOCATION: A PART OF THE S.W. 1/4 OF SEC. 6, T.7N., R.1E., S.L.B.&M.

SURVEYED:

REVISIONS:	DRAWN BY: <u>[Signature]</u>
5-13-97 01	CHECKED BY: D. GRAHAM
	DATE: 5-12-97
	FILE: 1859FIN.DWG