




CONSTRUCTION & LAND SURVEYORS
 2781 WASHINGTON BLVD. SUITE 300
 OGDEN, UTAH 84401
 Ph. (801) 399-4935 Fax (801) 627-1088

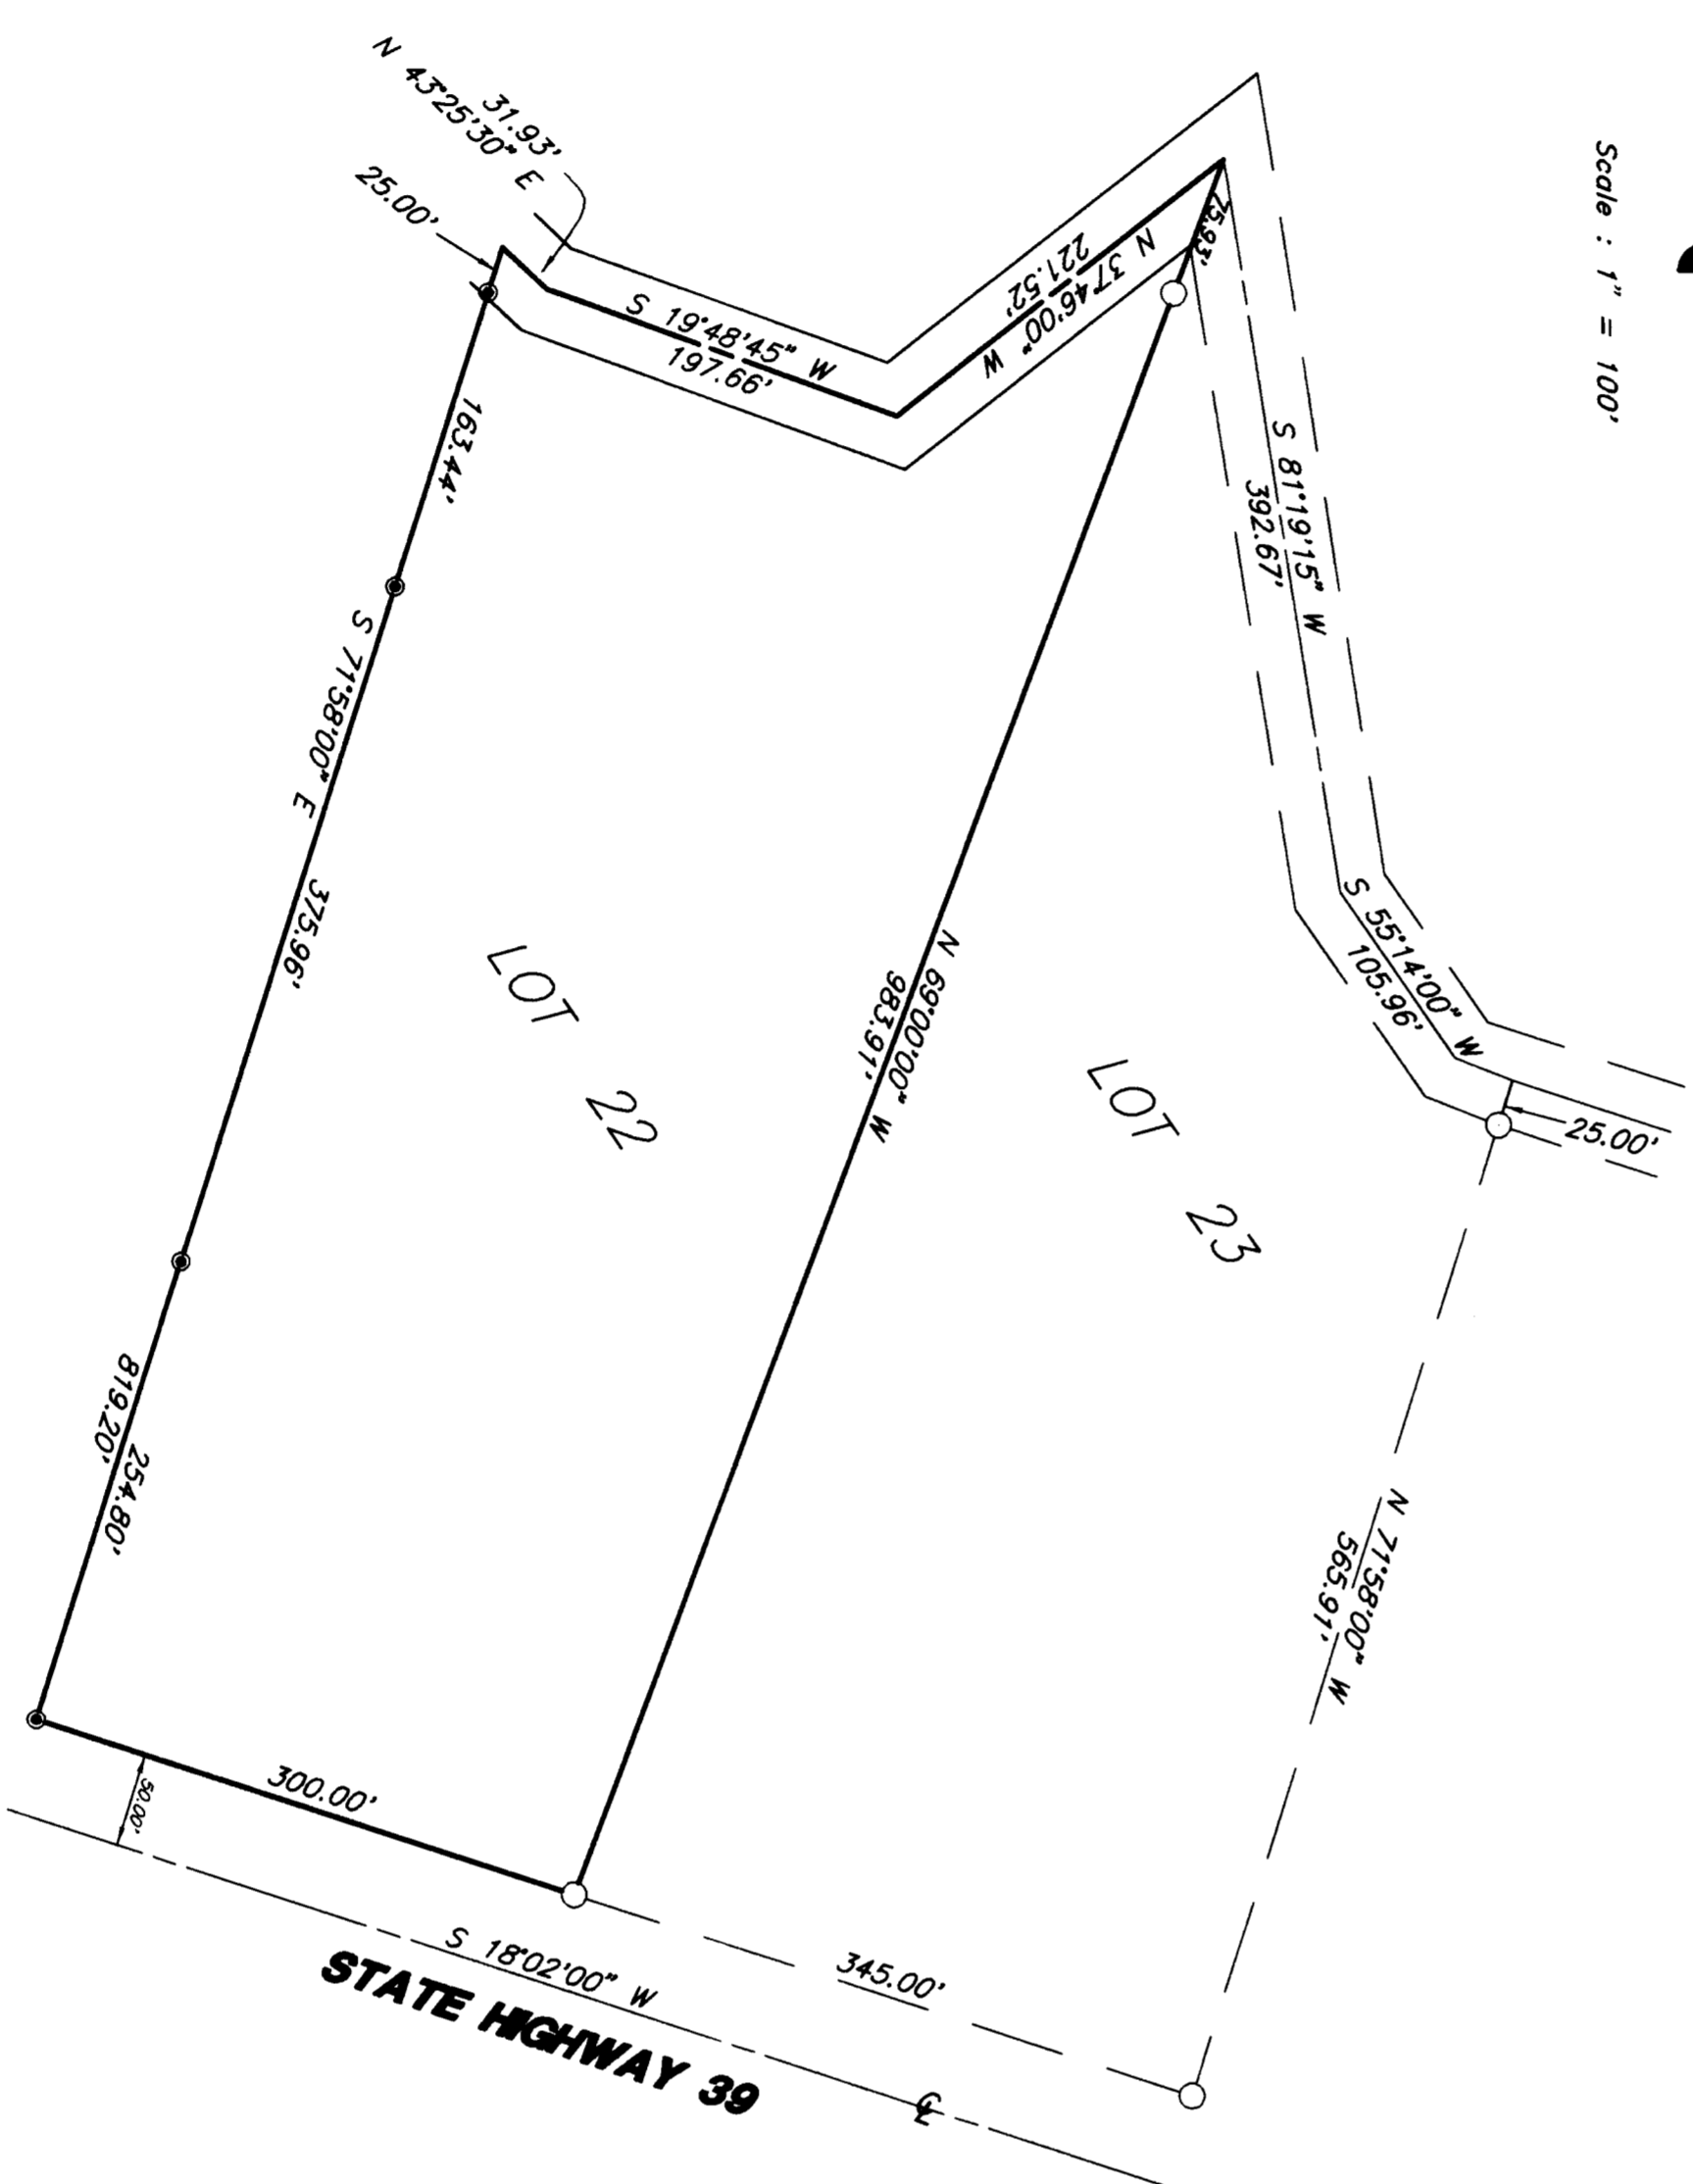

Scale: 1" = 100'

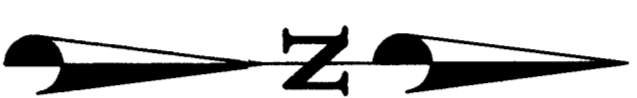

NOTE:
FOR ADDITIONAL INFORMATION SEE SURVEY OF LOT 23 FILED WITH THE WEBER COUNTY SURVEYOR.

LEGEND:

- FOUND 3/4" REBAR WITH C. & L.S. CAP.
- SET 1/2" REBAR WITH C. & L.S. CAP.

SURVEYORS' CERTIFICATE
 I, CHESTER L. NELSON DO HEREBY CERTIFY THAT I AM A REGISTERED LAND SURVEYOR AND THAT I HOLD CERTIFICATE NO. 4263 (1252026) AS ISSUED BY THE STATE OF UTAH. I HAVE MADE A PERSONAL AND THOROUGH AND FROM RECORDS OF THE WEBER COUNTY RECORDERS OFFICE AS DESCRIBED ABOVE AND SHOWN PER THIS PLAT.
 DATE: 8/28/96
 CHESTER L. NELSON



NARRATIVE

THIS SURVEY WAS DONE FOR THE PURPOSE OF STAKING THE EAST LINE OF LOT 22, BEAVER CREEK ESTATES, TOWNSHIP 7 NORTH, RANGE 3 EAST, SALT LAKE BASE AND MERIDIAN, WEBER COUNTY, UTAH.

LEGAL DESCRIPTION

ALL OF LOT 22, BEAVER CREEK ESTATES, WEBER COUNTY, UTAH.

RECEIVED

DEC 08 1997

Weber County Surveyor

001840

001840

CLIENT: STEVEN L. FORSBERG	CONSTRUCTION & LAND SURVEYORS 2781 WASHINGTON BLVD OGDEN, UTAH 84401 (801) 399-4935
SURVEY LOCATION: S.E. 1/4 SEC. 16, RANGE 3 EAST, SALT LAKE BASE & MERIDIAN	
SURVEY DATE: 8/9/96	
JOB No. P596-20	