



LEGAL DESCRIPTION

SURVEYOR'S CERTIFICATE
 I, LEE E. ROBINSON, A DULY REGISTERED LAND SURVEYOR IN THE STATE OF UTAH, DO HEREBY CERTIFY THAT A SURVEY OF THE PROPERTY DESCRIBED ABOVE WAS MADE UNDER MY SUPERVISION, AND THAT THE MEASUREMENTS AND CALCULATIONS ARE AS SHOWN HEREON.

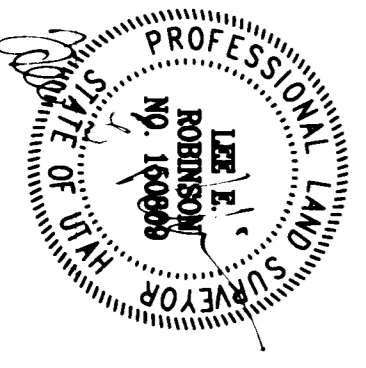


LEE E. ROBINSON, P.S.
 SCHUCHERT & ASSOCIATES

NOTE:

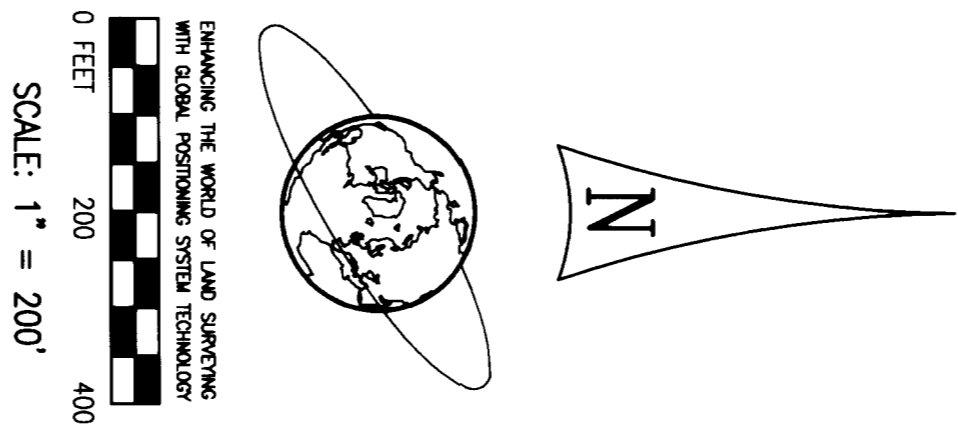

- COMMENTS**
1. THIS SURVEY IS MADE AT THE INSTANCE OF THE SALT LAKE COUNTY WATER CONSERVANCY DISTRICT FOR THEIR OWN USES AND PURPOSES.
 2. THE BASIS OF BEARING FOR THIS SURVEY IS THE UTAH STATE PLANE RECORD IN THE WEBER COUNTY SURVEYOR'S OFFICE.

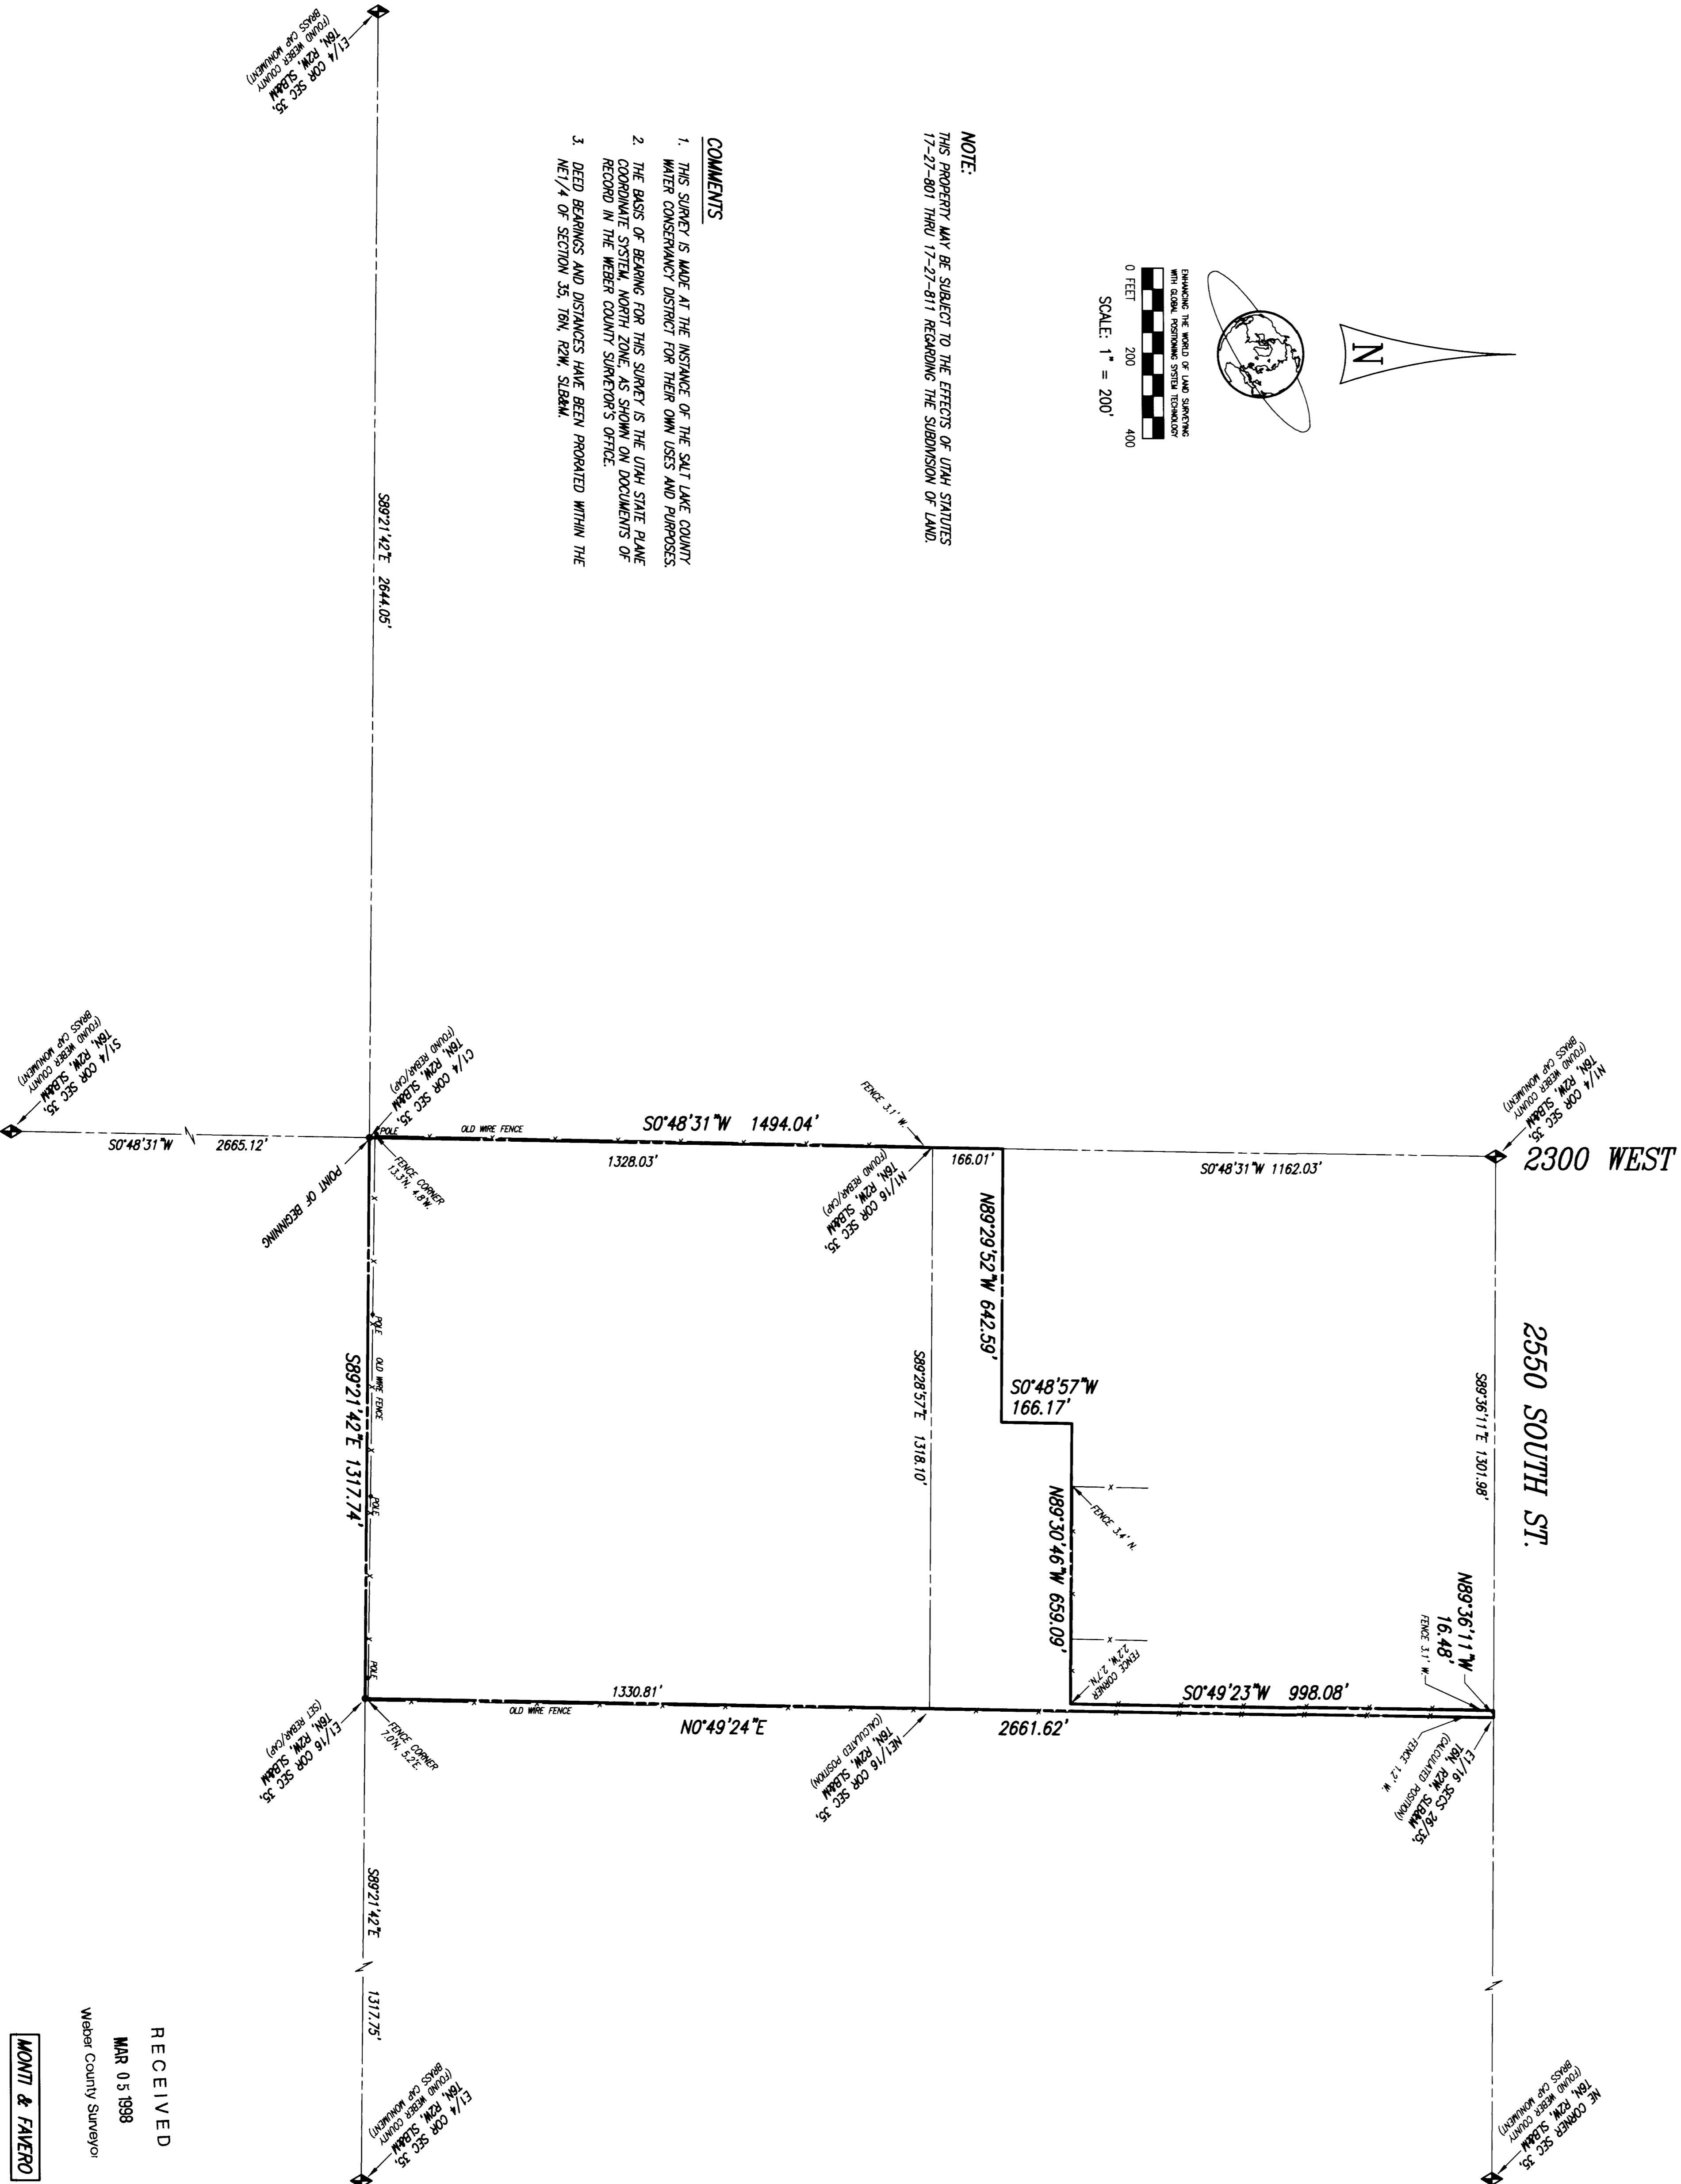

RBB
 SCHUCHERT & ASSOCIATES
 PROFESSIONAL LAND SURVEYORS
 5330 SOUTH 900 EAST, SUITE 100
 SALT LAKE CITY, UTAH 84117-7851
 (801) 266-1118 (801) 262-5811 fax

REVISIONS

| | | |
|--|--|--|
| | | |
| | | |
| | | |
| | | |
| | | |
| | | |
| | | |
| | | |
| | | |
| | | |
| | | |

SURVEY MAP
 WEST HAVEN, WEBER COUNTY, UTAH
 11/28/97
 2788 7/4
 1

RECEIVED
 MAR 05 1998
 Weber County Surveyor
MONTE & FAVERO