


NORTHWEST CORNER OF
SLAB #1 FOUND 3" BRASS
CAP SET IN CONCRETE 3"
BELOW THE GROUND WITH A
LOG 1941

SURVEYOR'S CERTIFICATE



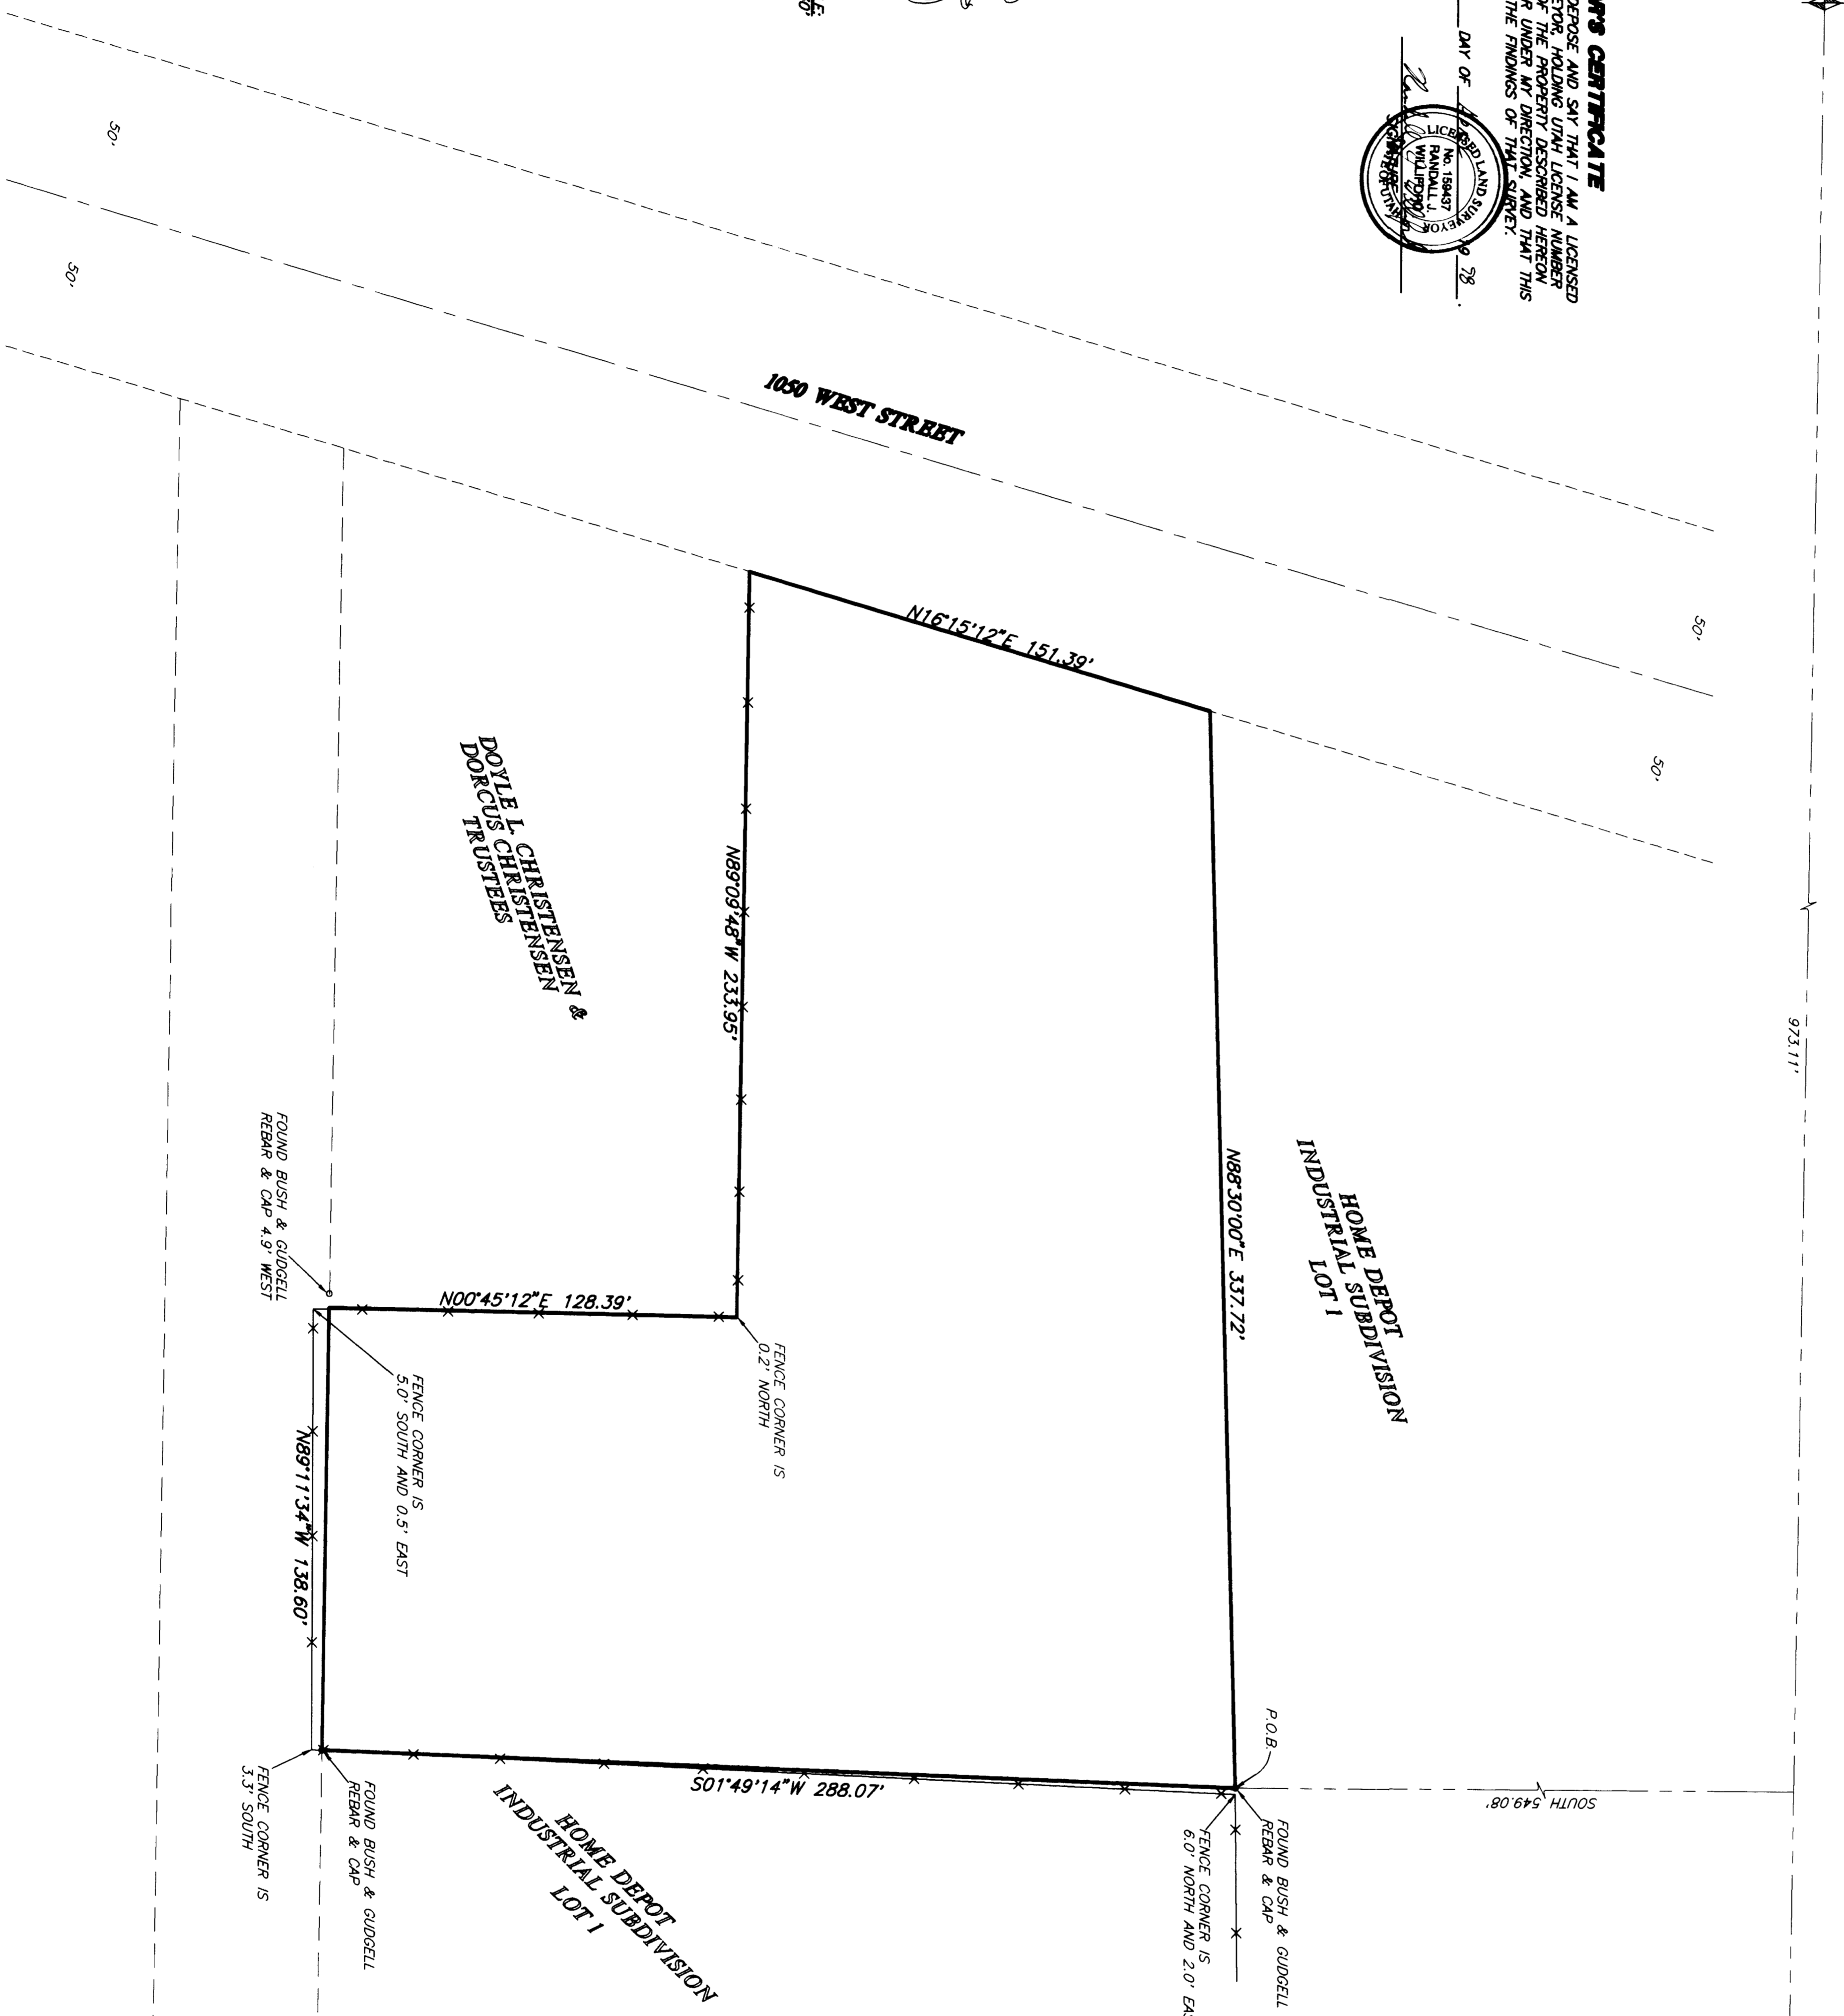

NORTH QUARTER CORNER OF
SECTION 18, T.5N., R.1W., S.L.B.#1,
CONCRETE 2" BELOW GROUND
(1981)

BOUNDARY DESCRIPTION

PART OF THE NORTHWEST QUARTER OF SECTION 18, T.5N., R.1W., S.L.B. #1, U.S. SURVEY, DESCRIBED AS FOLLOWS:







RECEIVED

APR 24 1998

Weber County Surveyor

THESE PLANS AND SPECIFICATIONS ARE THE PROPERTY OF REEVE & ASSOCIATES, INC. NO PART OF THESE PLANS OR SPECIFICATIONS ARE TO BE REPRODUCED OR TRANSMITTED IN ANY FORM OR BY ANY MEANS, ELECTRONIC OR MECHANICAL, INCLUDING PHOTOCOPYING, RECORDING, OR BY ANY INFORMATION STORAGE AND RETRIEVAL SYSTEM, WITHOUT THE WRITTEN PERMISSION OF REEVE & ASSOCIATES, INC.

RECORD OF SURVEY

RIVERSIDE MARINE PROPERTY
IN THE NORTHWEST QUARTER OF SECTION 18, T.5N., R.1W., S.L.B.#1,
MERCANTILE CO. WEBER COUNTY, UTAH
APRIL 1988

REEVE & ASSOCIATES, INC.
ENGINEERS PLANNERS & SURVEYORS
3670 COUNTRY UTAH BLVD. SUITE 101
SALT LAKE CITY, UTAH 84119
(801) 621-5100 FAX (801) 621-5886
TOLL-FREE 1-888-484-5100

PROJECT NO.: 2002-01 SURVEYOR: K. ANDERSON
DATE: 4-24-98 OWNER: H. CHRISTENSEN
SCALE: 1"=40' CHECKED:

REVISIONS
1 _____
2 _____
3 _____
4 _____
5 _____
6 _____