

REVISIONS

1	
2	
3	
4	
5	
6	

PROJECT NO. 2840-01  
 DATE 6-20-97  
 SCALE 1"=50'


DESIGNED BY JAE  
 CHECKED BY JAE

**REEVE & ASSOCIATES, INC.**  
 ENGINEERS PLANNERS & SURVEYORS  
 3670 QUINCY AVE. SUITE 101  
 (801) 521-5100 FAX (801) 521-2666

RECORD OF SURVEY

**BOB WADMAN PROPERTY**  
 A PART OF THE SW 1/4 OF SECTION 33, T7N, R1E, S18& M, U.S. SURVEY  
 1988

SHEET 1 OF 1 SHEETS

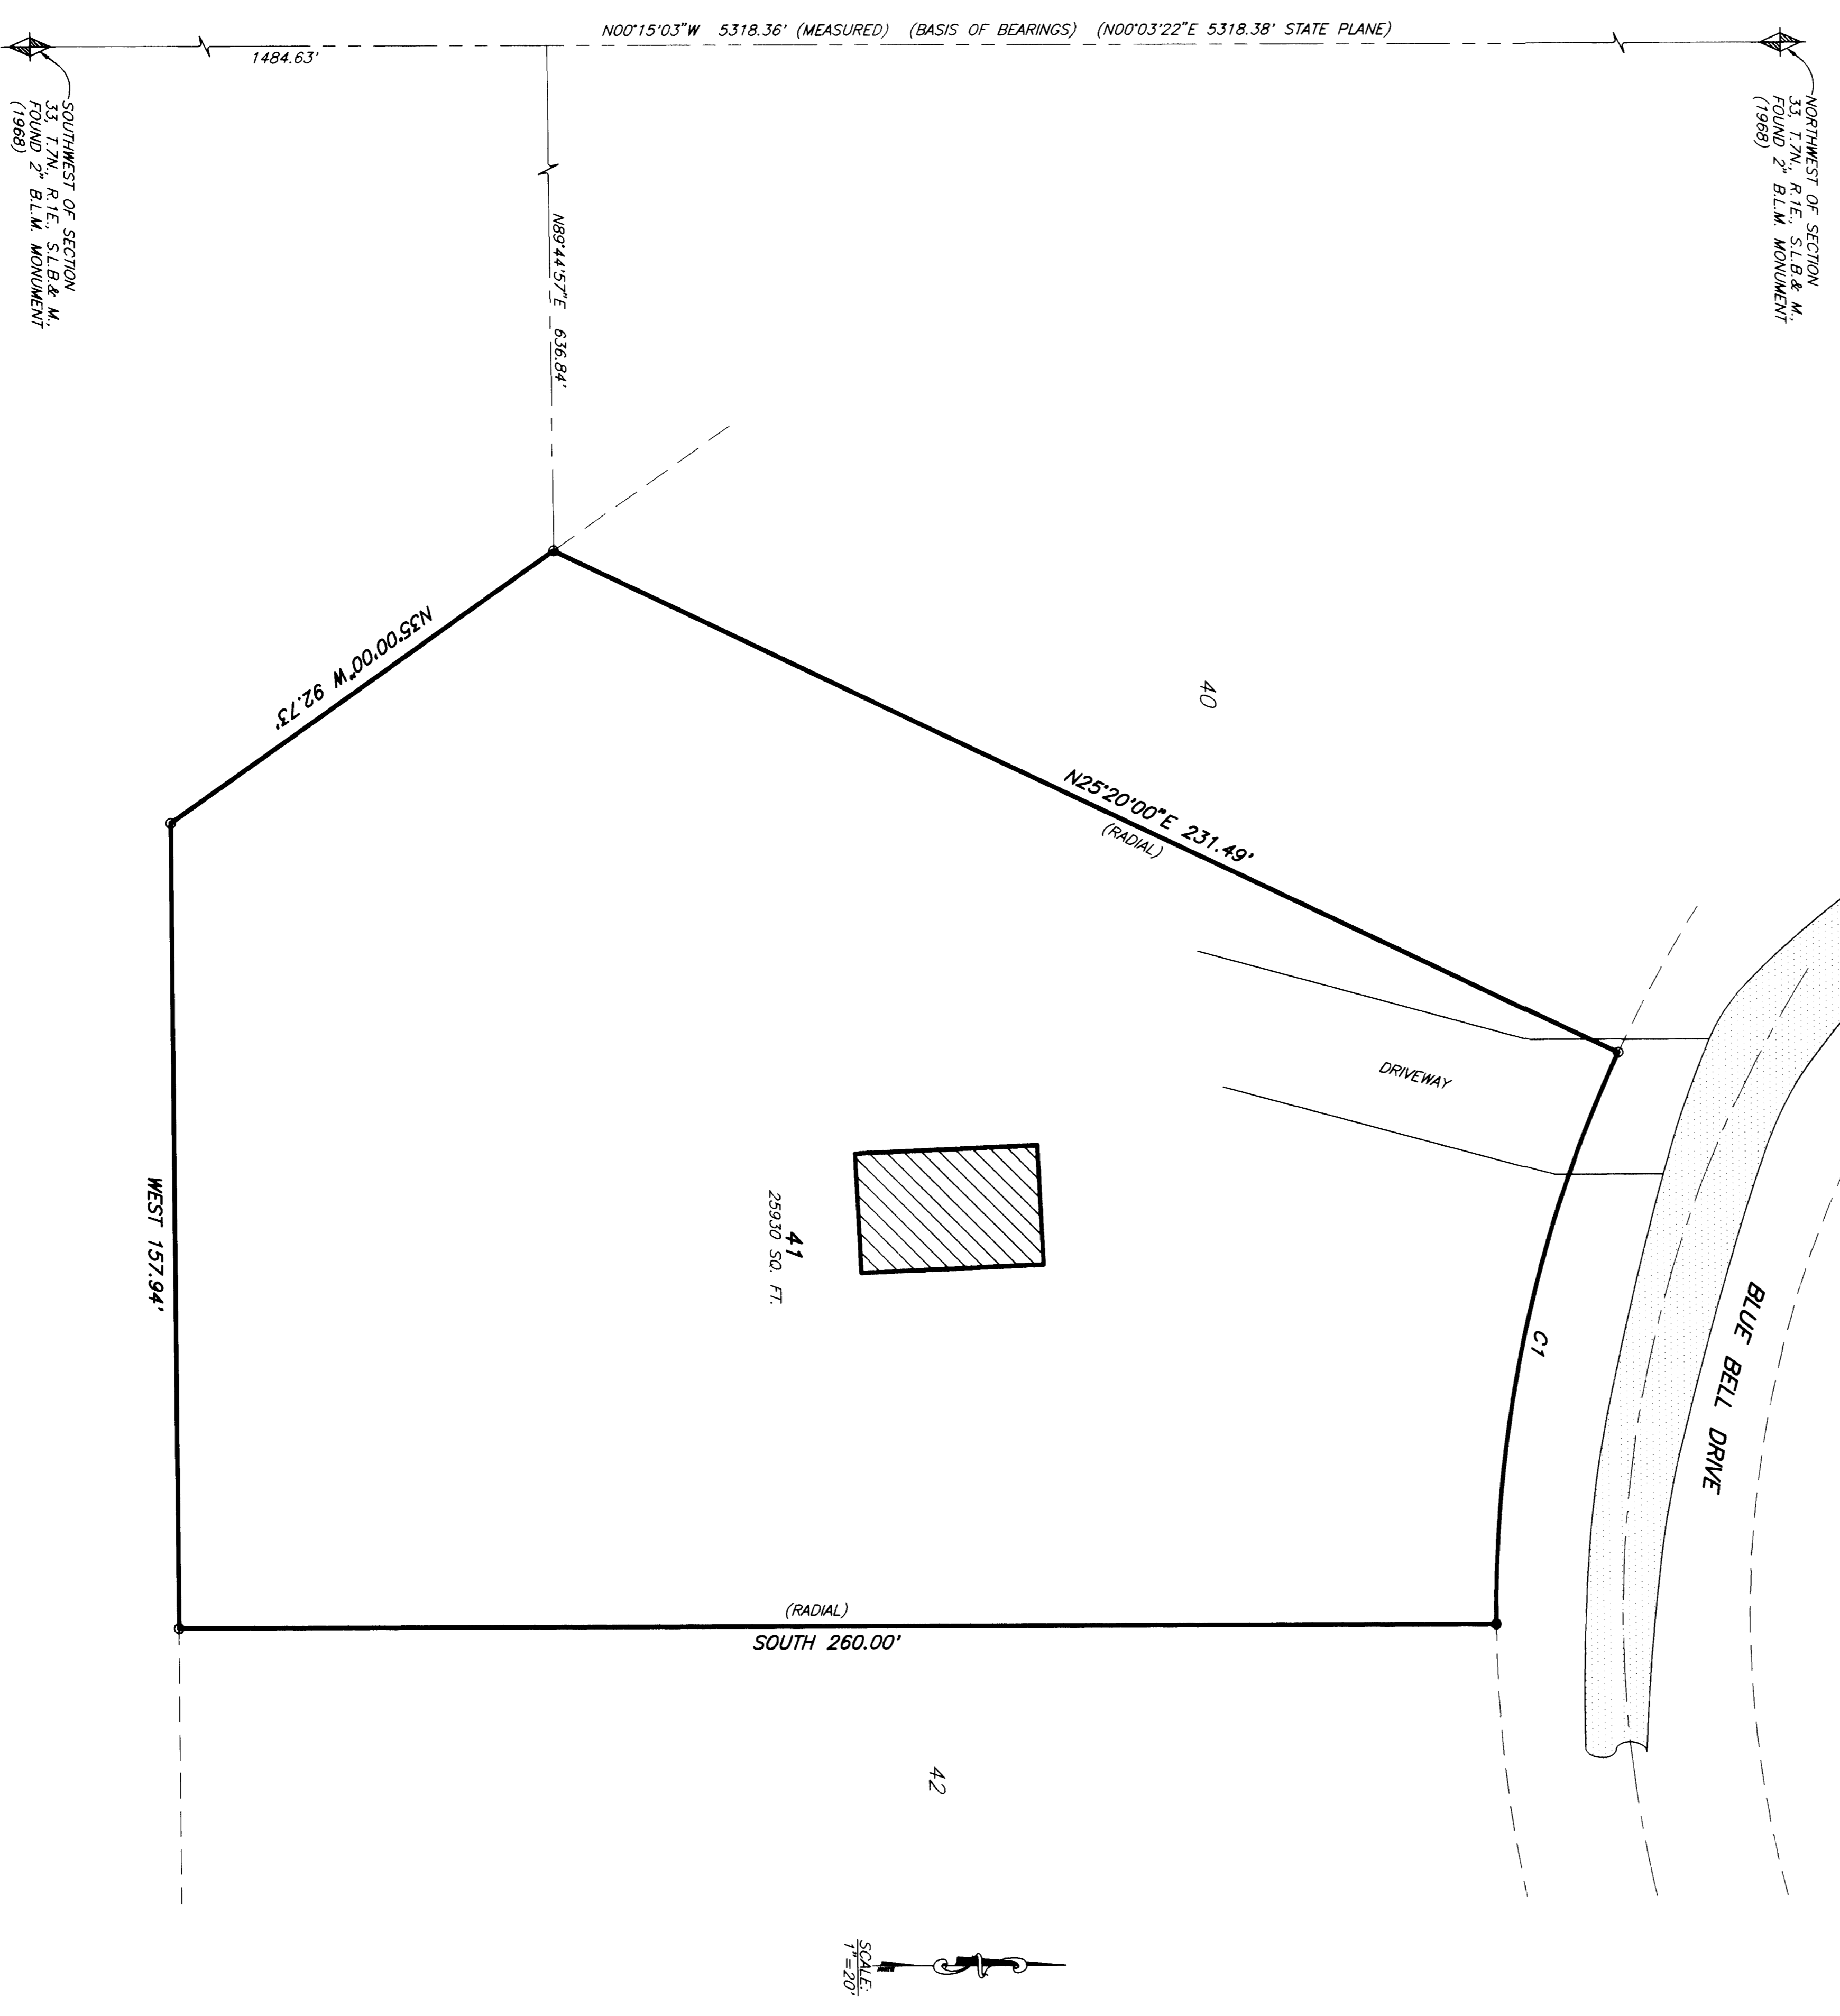

CURVE INFORMATION

NUMBER	DELTA	CHORD	TANGENT	RADIUS	LENGTH	CHORD
C1	25720'00"	57720'00"E	58.87	281.95	115.82	114.88

- LEGEND \***
- ◆ = SECTION CORNER FOUND AS NOTED HEREON
  - ▨ = EXISTING BUILDING
  - ▨ = EXISTING PAVEMENT
  - = FOUND 1/2" REBAR AND CAP
  - = SET 5/8" REBAR AND CAP
  - = MARKED "REVEE & REEVE"
- RECEIVED  
 APR 3 4 1998  

**BOUNDARY DESCRIPTION**  
 ALL OF LOT 41, BIG SKY ESTATES NUMBER 1, A PART OF THE SOUTHWEST QUARTER OF SECTION 33, T7N, R1E, S18& M, U.S. SURVEY.

**BASIS OF BEARINGS**  
 THE BASIS OF BEING FOR THIS PLAT IS THE LINE BETWEEN THE 33, T7N, R1E, S18& M, SHOWN HEREON AS N00°15'03"W.

**NARRATIVE**  


SIGNED THIS 22<sup>ND</sup> DAY OF APRIL 1998  
 199837  
 UTAH LICENSE NUMBER

BOB WADMAN  
 SURVEYOR

**SURVEYOR'S CERTIFICATE**

I, BOB WADMAN, DO HEREBY DEPOSE AND SAY THAT I AM A LICENSED PROFESSIONAL LAND SURVEYOR, HOLDING UTAH LICENSE NUMBER 199837, THAT A SURVEY OF THE PROPERTY DESCRIBED HEREON WAS CONDUCTED BY ME OR UNDER MY SUPERVISION AND THAT THIS PLAT CORRECTLY DEPICTS THE FINDINGS OF THAT SURVEY.