

NORTHWEST CORNER OF S.L.B.M., U.S. SURVEY, NOT FOUND



N89°09'30"W 2892.67'

**SURVEYOR'S CERTIFICATE**




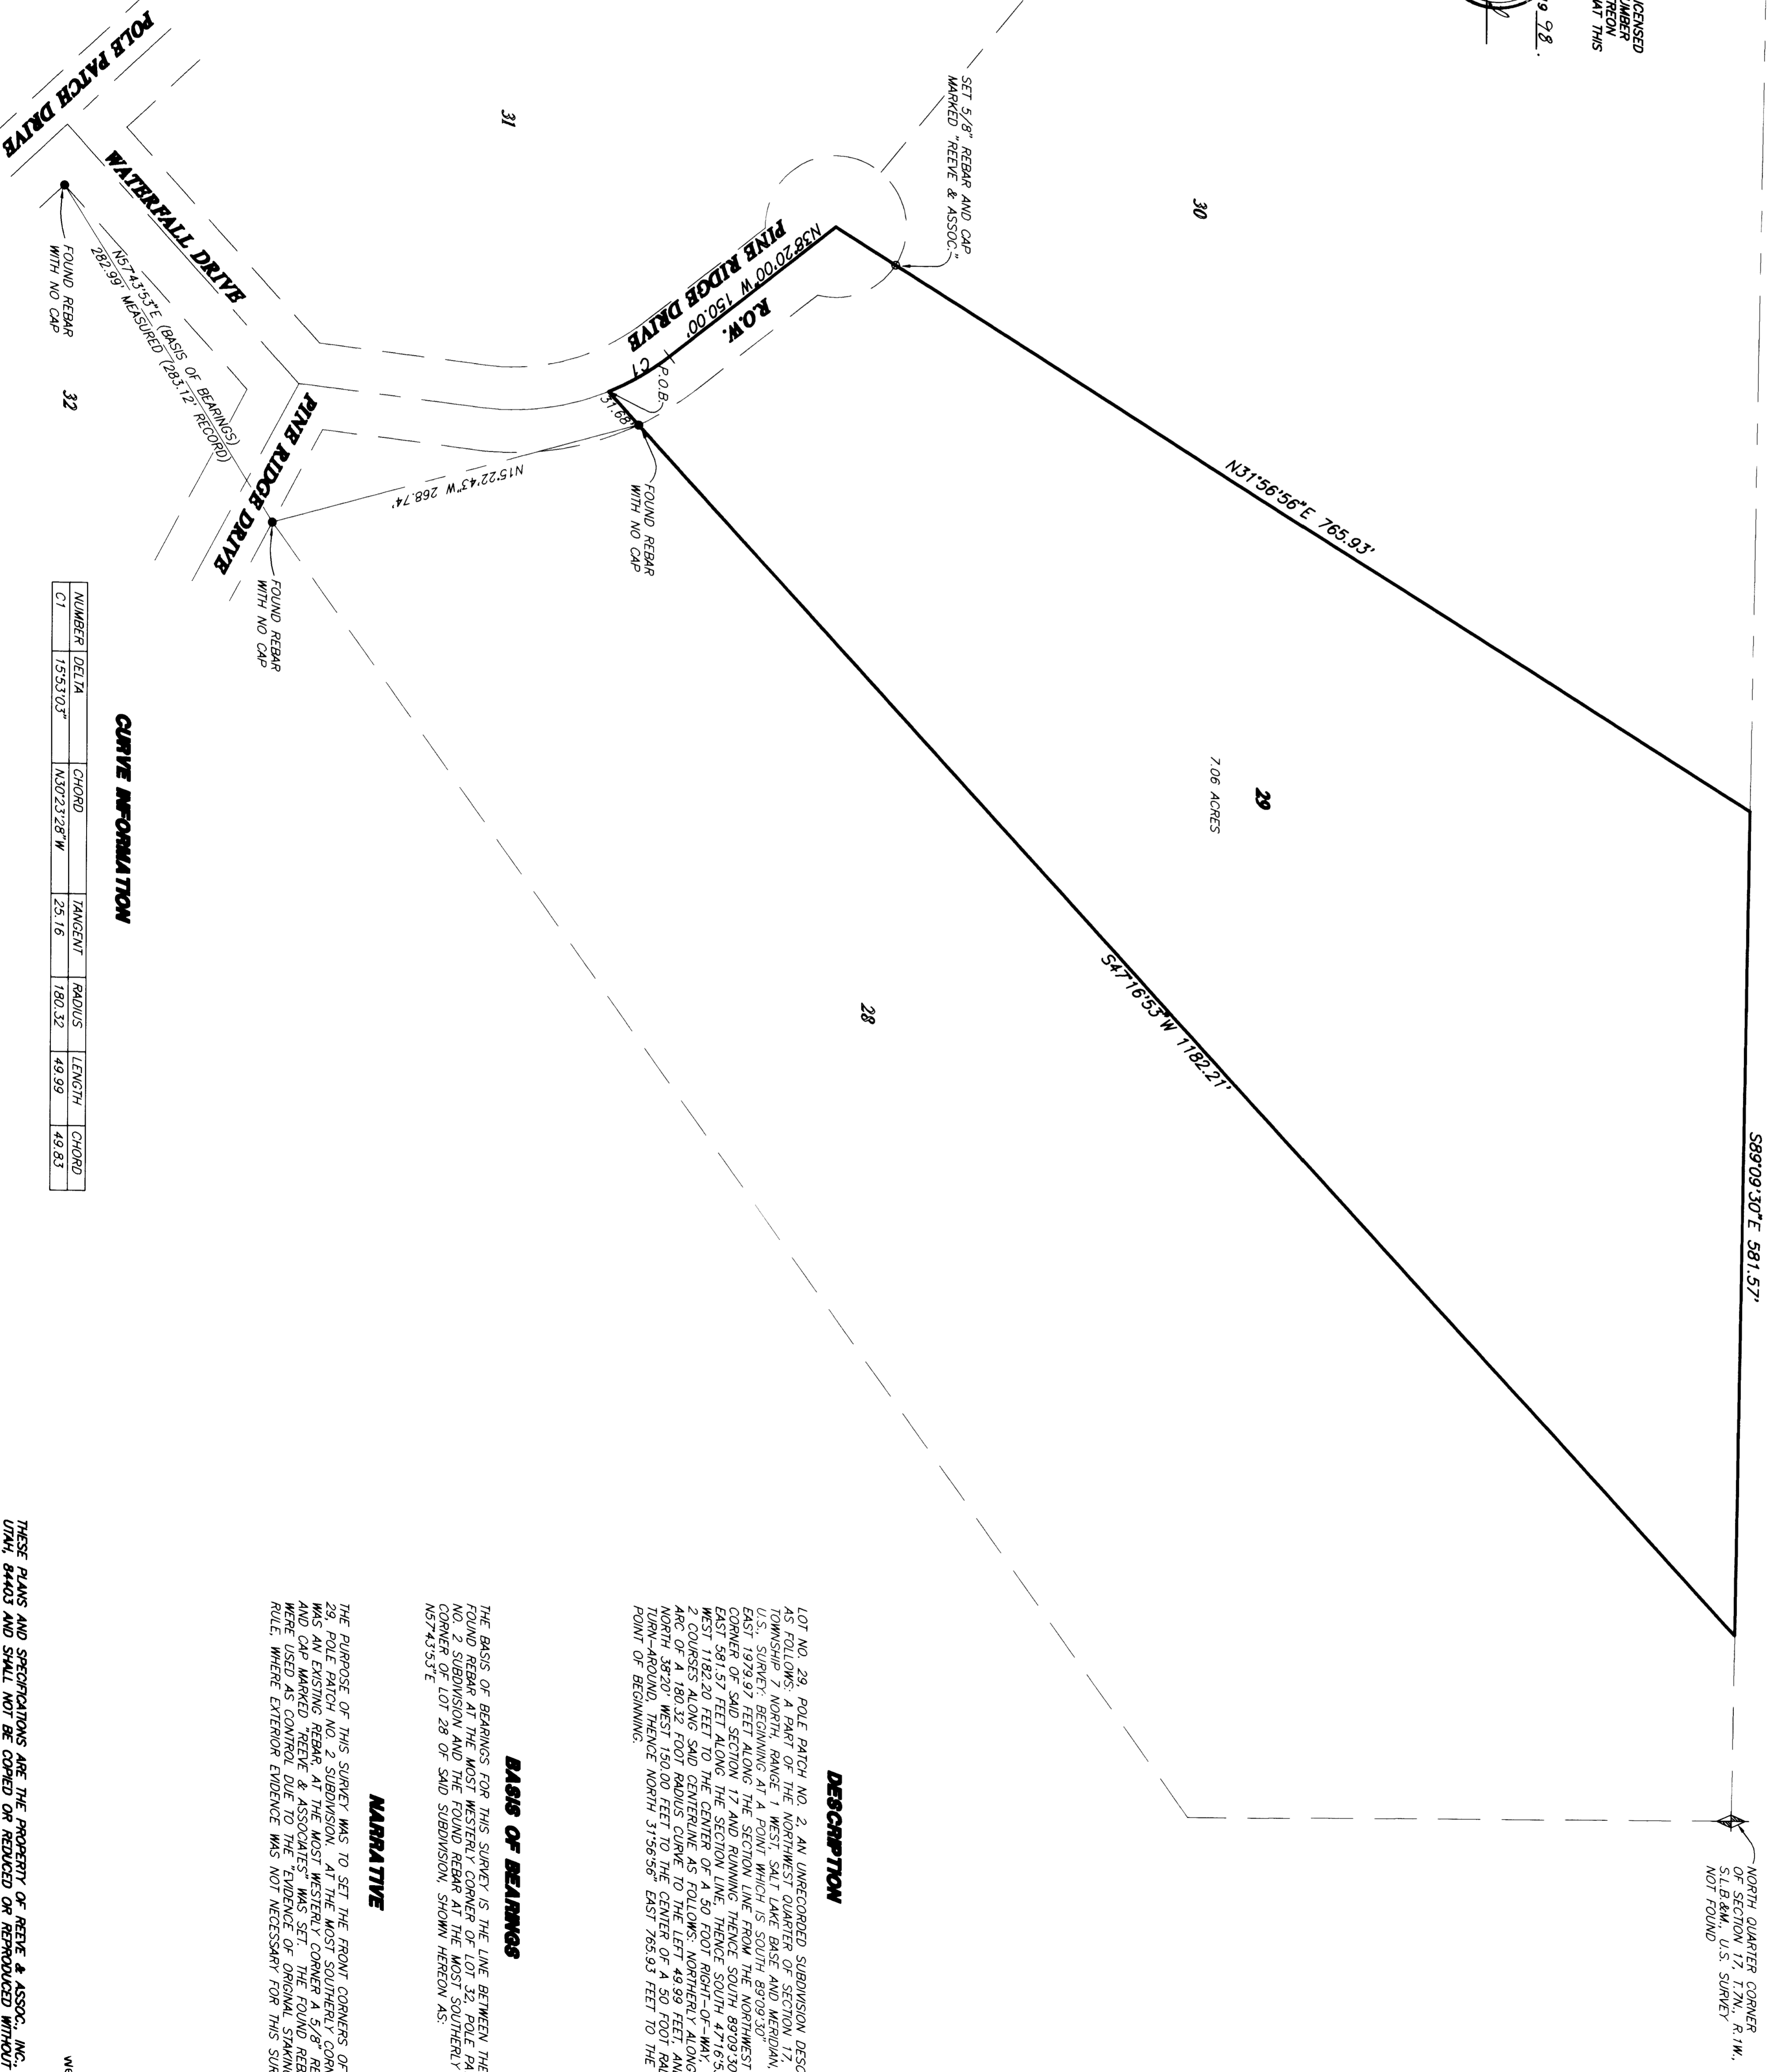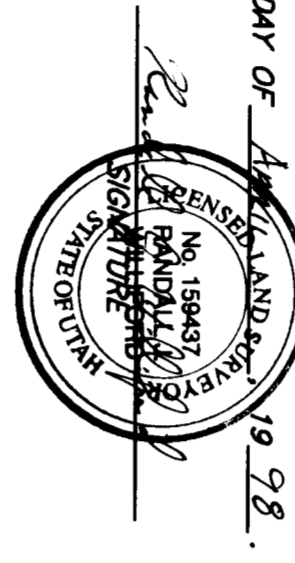

S89°09'30\"/>

NORTH QUARTER CORNER OF S.L.B.M., U.S. SURVEY, NOT FOUND

**DESCRIPTION**  

**BASIS OF BEARINGS**  

**NARRATIVE**  
THE PURPOSE OF THIS SURVEY WAS TO SET THE FRONT CORNERS OF LOT 29, POLE PATCH NO. 2, SUBDIVISION, AT THE MOST SOUTHERLY CORNER AND EXISTING REBAR, AT THE MOST WESTERLY CORNER A 5/8\"/>

**CURVE INFORMATION**

NUMBER	DELTA	CHORD	TANGENT	RADIUS	LENGTH	CHORD

- REVISIONS**
- 1. \_\_\_\_\_
  - 2. \_\_\_\_\_
  - 3. \_\_\_\_\_
  - 4. \_\_\_\_\_
  - 5. \_\_\_\_\_
  - 6. \_\_\_\_\_

DATE: 11-14-97 DRAWN: JAE  
SCALE: 1"=80' CHECKED: \_\_\_\_\_

**REEVE & ASSOCIATES, INC.**  
ENGINEERS PLANNERS & SURVEYORS  

**RECORD OF SURVEY**

**RICK WADMAN PROPERTY**  
NOVEMBER, 1997

RECEIVED  
APR 27 1998  
